


DRAWING NUMBER: MD-216-3980-EG-CV-GAD-1470 | REV: D01

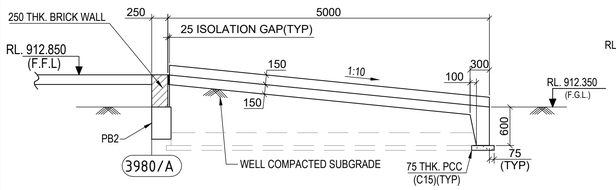


SECTION : C3-C3
(SCALE 1:50)

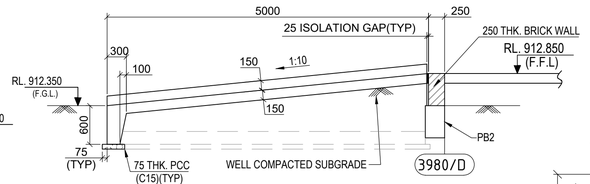


SECTION : C2-C2
(SCALE 1:50)

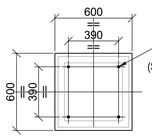


SECTION : C5-C5
(SCALE 1:25)

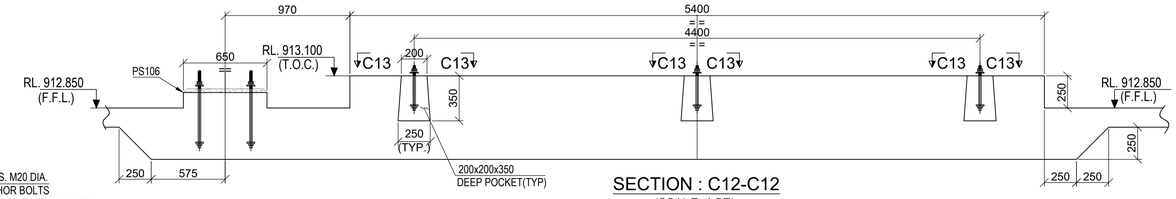


SECTION : C12-C12
(SCALE 1:25)

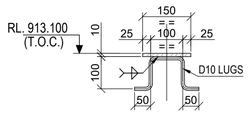


SECTION E1 - E1
(SCALE 1:10)

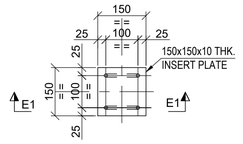


DETAIL OF INSERT PLATE - IP1
(SCALE 1:10)

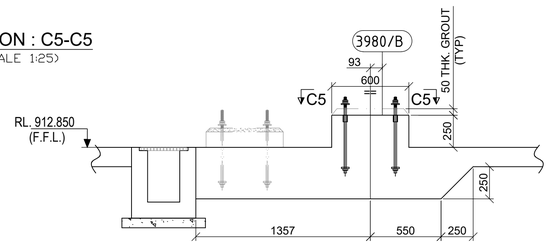

SECTION : C4A-C4A
(SCALE 1:25)

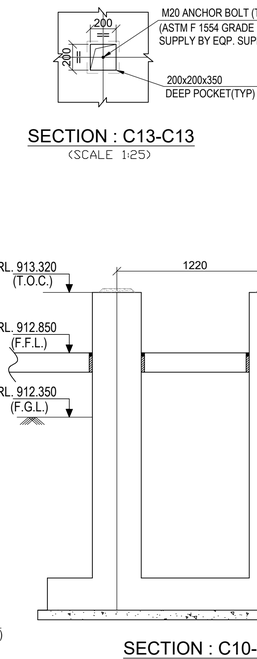


SECTION : C9-C9
(SCALE 1:25)

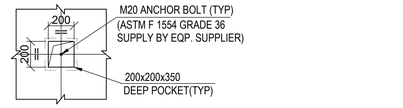


SECTION : C13-C13
(SCALE 1:25)


SECTION : C10-C10
(SCALE 1:25

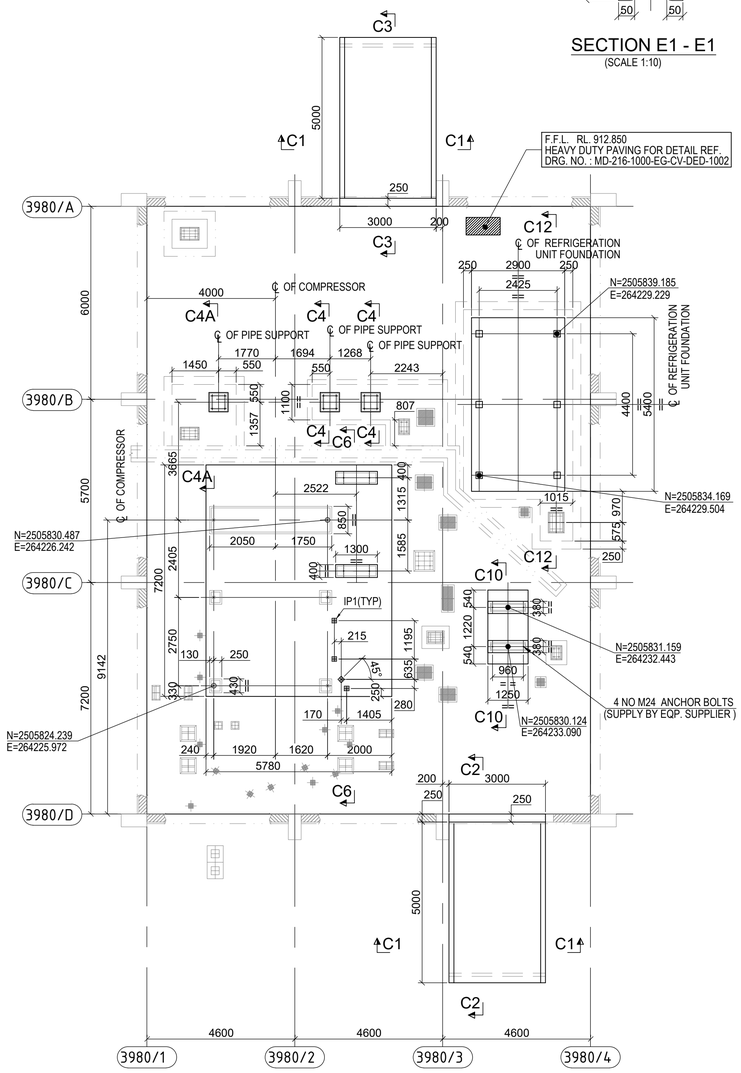


GRADE SLAB PLAN OF COMPRESSOR SHED
(SCALE 1:100)

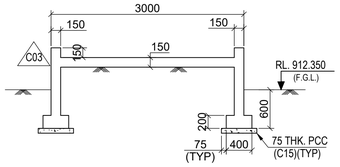


SECTION : C1-C1
(SCALE 1:50)

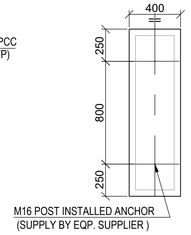


SECTION : C8-C8
(SCALE 1:25)

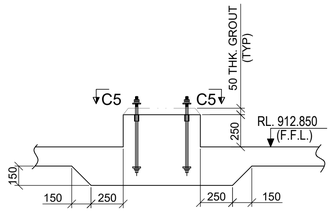

SECTION : C4-C4
(SCALE 1:25)

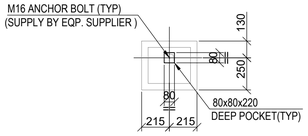

SECTION : C7-C7
(SCALE 1:25)

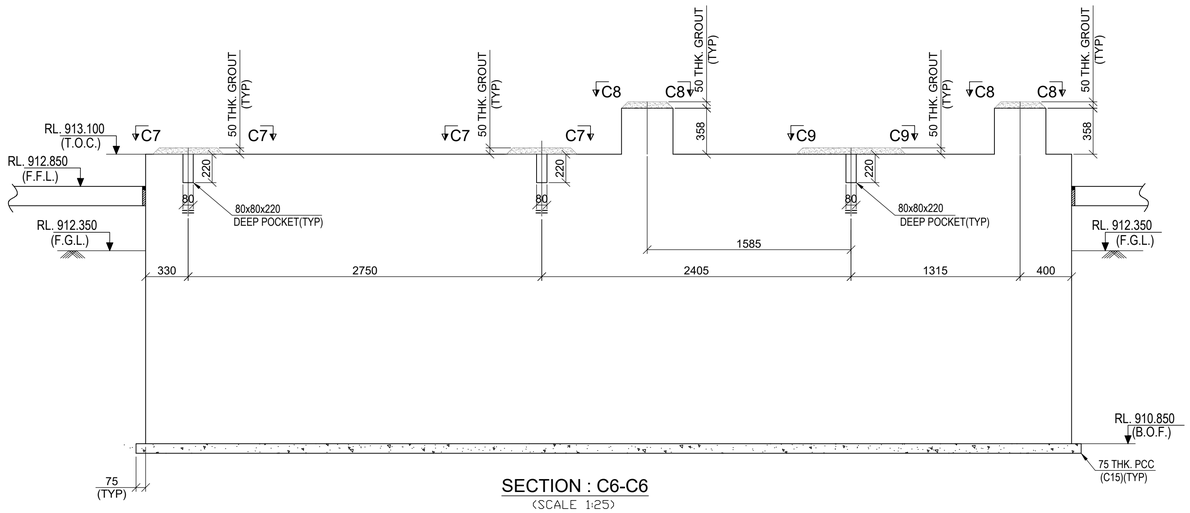

SECTION : C6-C6
(SCALE 1:25)

LEGEND :-

R.L. - REDUCED LEVEL
T.O.C. - TOP OF CONCRETE.
B.O.F. - BOTTOM OF FOUNDATION
F.G.L. - FINISHED GROUND LEVEL
F.F.L. - FINISHED FLOOR LEVEL
P.C.C - PLAIN CEMENT CONCRETE
TYP. - TYPICAL.
MKD. - MARKED.
THK. - THICK
℄ - CENTER LINE
PL. - PLATE

NOTES :-

1. ALL DIMENSIONS ARE IN MILLIMETRES AND LEVELS AND CO-ORDINATES ARE IN METRES. UNLESS OTHERWISE STATED.
2. GRADE OF CONCRETE SHALL BE C35.
3. GRADE OF REINFORCEMENT SHALL BE DEFORMED BAR ASTM A615 - GRADE 60 (fy = 420 MPa).
4. NET SAFE BEARING CAPACITY OF SOIL AT BOTTOM OF FOUNDATION CONSIDERED 670KN/SQ. M.
5. IF ANY PART OF FOUNDATION COMES ON BACKFILL ZONE OF ADJACENT FOUNDATION OR ANY LOOSE PACKETS ARE ENCOUNTERED BELOW FOUNDATION LEVEL THE SAME SHALL BE REMOVED AND FILLED WITH PCC.
6. THIS DRAWING IS READ IN CONJUNCTION WITH DRG. NO : MD-216-3980-EG-CV-GAD-1468, MD-216-3980-EG-CV-GAD-1483 & MD-216-3980-EG-CV-GAD-1484.
7. FOR REINFORCEMENT DETAIL REFER DRG. NO : MD-216-3980-EG-CV-DED-1472.
8. FOR BOLT DETAILS REFER DRG. NO : MD-216-1000-EG-CV-DED-1003.
9. FOR GENERAL NOTE FOR CIVIL WORK REFER DRG. NO : MD-216-1000-EG-CV-DED-1001.

DOCUMENT NUMBER	REFERENCE DOCUMENTS	REV	DATE	REVISION DESCRIPTION	DRN	CHK	ENG	APP	EMP
MD-216-3980-EG-CV-GAD-V551-1482	FOUNDATION LOAD - AIR/WATER EXCHANGER E07								
MD-216-3980-EG-CV-DED-V551-1480	FOUND. LOAD & ANCHORAGE FOR COMPPESSOR	D01	22/02/2023	AS-BUILT	SBH	BDA	SUE	AG	
MD-216-3980-EG-ST-GAD-V551-1489	GUIDE DRAWING COMPPESSOR ROOM (SHT 3 OF 3)	C03	12/11/2020	ISSUED FOR CONSTRUCTION & REVISED AS MKD.	SBH	BDA	SUE	AG	
MD-216-3980-EG-ST-GAD-V551-1488	GUIDE DRAWING COMPPESSOR ROOM (SHT 2 OF 3)	C02	14/08/2020	ISSUED FOR CONSTRUCTION	SBH	BDA	SUE	AG	
MD-216-3980-EG-ST-GAD-V551-1477	GUIDE DRAWING COMPPESSOR ROOM (SHT 1 OF 3)	C01	16/07/2020	ISSUED FOR CONSTRUCTION	SBH	BDA	SUE	AG	
MD-216-3980-EG-PI-PPD-V551-1001	OXYGEN PLANT PLOT PLAN	A01	23/06/2020	ISSUED FOR REFERENCE	SBH	BDA	SUE	AG	

RESERVED FOR VENDOR LOGO AND DRAWING NUMBER

LARSEN & TOUBRO
This drawing is the property of LARSEN & TOUBRO and must not be passed on to any person or body not authorized by us to receive it nor be copied or otherwise made use either in full or in part by such person or body without our prior permission in writing.

Outotec
The content of these documents are the sole property of Outotec Oyj. Any rights not expressly granted herein are reserved. Reproduction, transfer or distribution of part or all of the contents in any form without prior written permission of Outotec is prohibited.

MA'ADEN معادن
Saudi Arabian Mining Company شركة التعدين العربية السعودية
This document and the information contained herein is Ma'aden proprietary know-how. This document or any part thereof should not be reproduced, stored in a retrieval system or transmitted by any means, electronic or otherwise, or divulged without prior written permission of Ma'aden.

LARSEN & TOUBRO DRAWING NUMBER: 019045_080_C_G_24197_003 | REVISION: 4
OUTOTEC DRAWING NUMBER: 900707 __GAU01 __AG22__MTL01 __39837 | DOCUMENT ID: OU100687651 | REVISION: 4

DRAWN	SBH	20/06/2020
CHECKED	BDA	22/06/2020
ENGINEER	SUE	20/06/2020
APPROVED	AG	23/06/2020
EMPLOYER		

SCALE: 1:100, 1:75 | A1

MANSOURAH - MASSARAH GOLD PROJECT
GENERAL ARRANGEMENT DRAWING
OXYGEN PLANT
COMPRESSOR ROOM GRADE SLAB & DETAILS

DRAWING NUMBER: MD-216-3980-EG-CV-GAD-1470 | REV: D01