


DRAWING NUMBER: MD - 216 - 3980 - EG - CV - GAD - 1474 | REV: D01

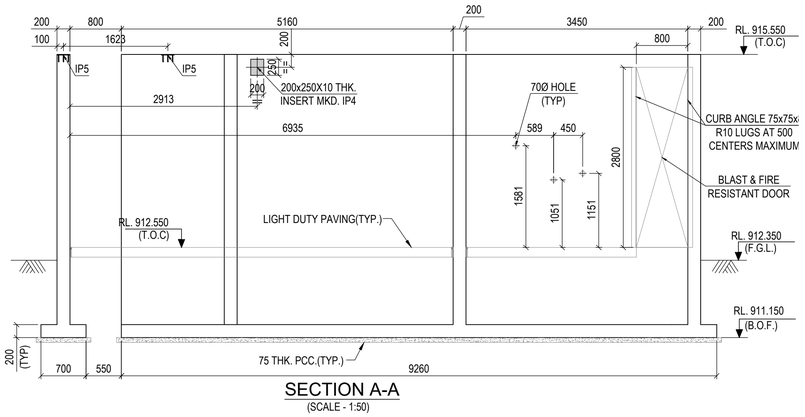


SECTION A-A
(SCALE - 1:50)

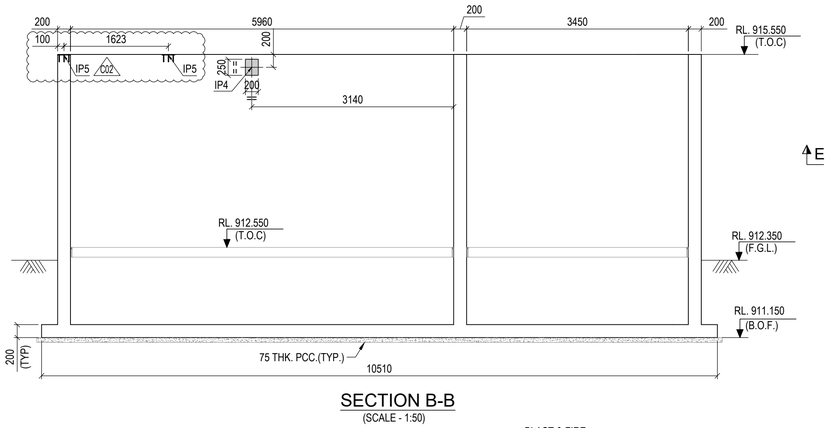


SECTION B-B
(SCALE - 1:50)

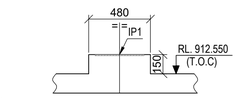


SECTION E-E
(SCALE-1:25)

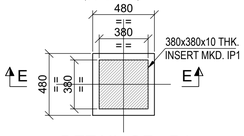


DETAIL OF - P1
(SCALE-1:25)

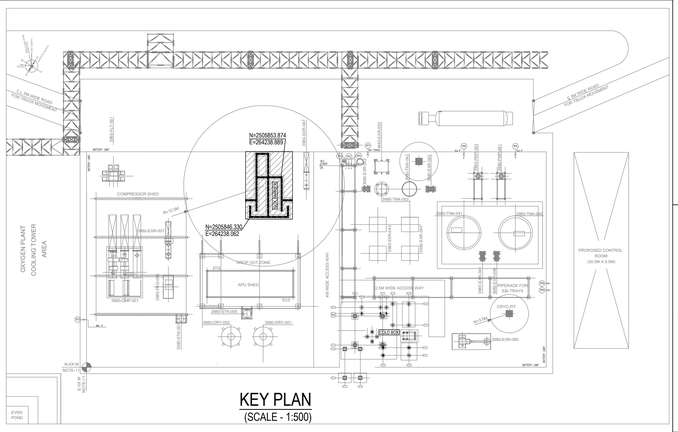


KEY PLAN
(SCALE - 1:500)

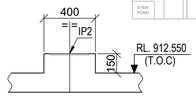


SECTION F-F
(SCALE-1:25)

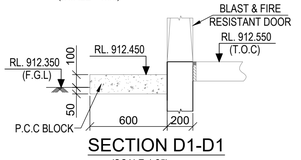


SECTION D1-D1
(SCALE-1:25)

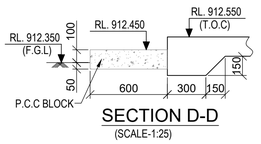


SECTION D-D
(SCALE-1:25)

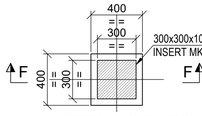


DETAIL OF - P2
(SCALE-1:25)

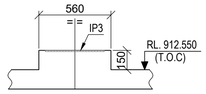


SECTION G-G
(SCALE-1:25)

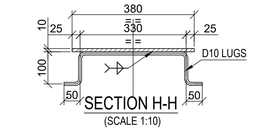


SECTION H-H
(SCALE 1:10)

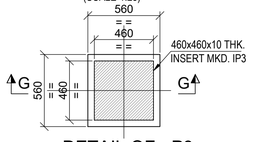


DETAIL OF - P3
(SCALE-1:25)

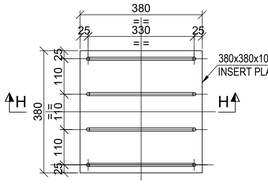


DETAIL OF INSERT PLATE - IP1
(SCALE 1:10)

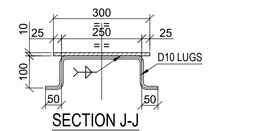


SECTION J-J
(SCALE 1:10)

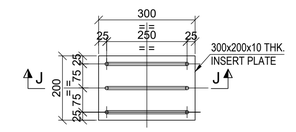


DETAIL OF INSERT PLATE - IP5
(SCALE 1:10)

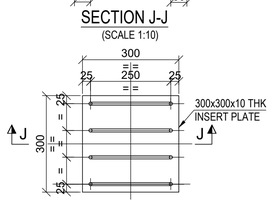


DETAIL OF INSERT PLATE - IP2
(SCALE 1:10)

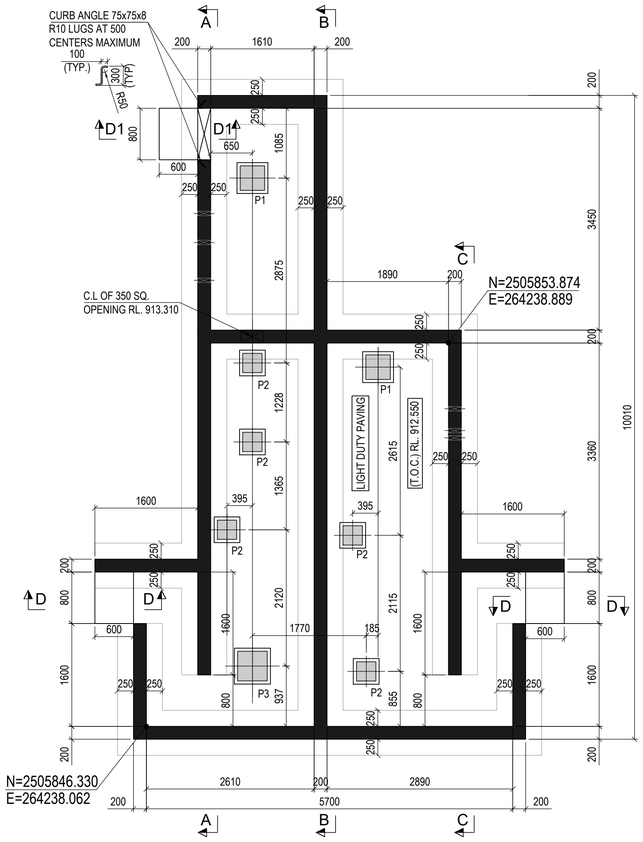


FOUNDATION LAYOUT PLAN FOR GOX BARRIER
(SCALE - 1:50)

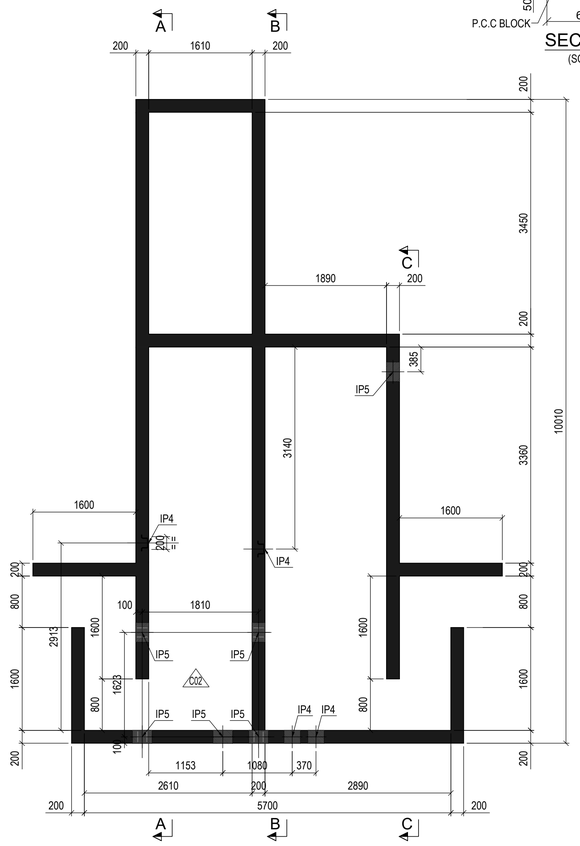


TOP PLAN FOR GOX BARRIER
(SCALE - 1:50)

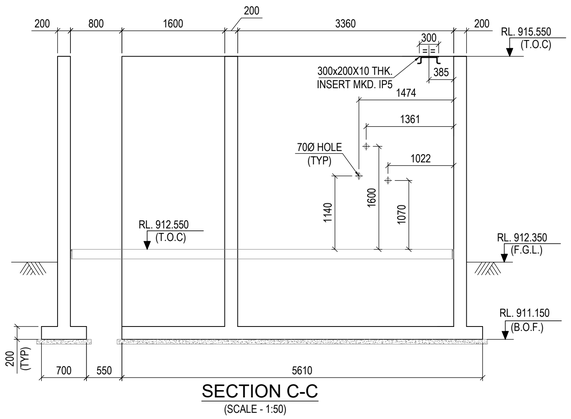


SECTION C-C
(SCALE - 1:50)

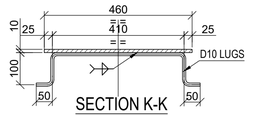


SECTION K-K
(SCALE 1:10)

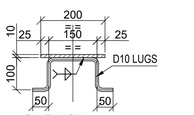

SECTION L-L
(SCALE 1:10)

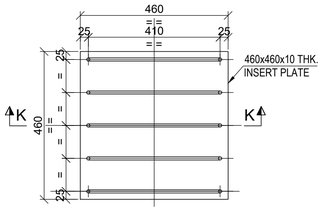

DETAIL OF INSERT PLATE - IP3
(SCALE 1:10)

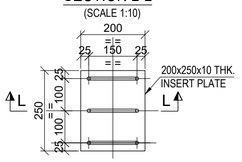

DETAIL OF INSERT PLATE - IP4
(SCALE 1:10)

LEGEND :-

RL. - REDUCED LEVEL
F.G.L - FINISHED GROUND LEVEL
P.C.C - PLAIN CEMENT CONCRETE
T.O.C - TOP OF CONCRETE
B.O.F - BOTTOM OF FOUNDATION
THK. - THICK
TYP. - TYPICAL
C.L - CENTRE LINE
DRG. - DRAWING
MKD. - MARKED
Ø - DIAMETER

NOTES:-

1. ALL DIMENSIONS ARE IN MILLIMETRES AND LEVELS ARE IN METRES UNLESS OTHERWISE STATED.
2. GRADE OF CONCRETE SHALL BE C35 .
3. GRADE OF REINFORCEMENT SHALL BE DEFORMED BAR 420 MPa (GRADE 60)
4. NET SAFE BEARING CAPACITY CONSIDERED AT THE FOUNDING LEVEL IS 670 KN/SQ. M
5. IF ANY PART OF FOUNDATION COMES ON BACKFILL ZONE OF ADJACENT FOUNDATION OR ANY LOOSE POCKETS ARE ENCOUNTERED BELOW FOUNDATION LEVEL THE SAME SHALL BE REMOVED AND FILLED WITH PCC.
6. FOR REINFORCEMENT DRAWING REFER DRG. NO. MD-216-3980-EG-CV-DED-1476.
7. FOR STANDARD DETAILS OF PAVING REFR DRG. NO : MD-216-1000-EG-CV-DED-1002.

DOCUMENT NUMBER	REFERENCE DOCUMENTS	REV	DATE	REVISION DESCRIPTION	DRN	CHK	ENG	APP	EMP
		D01	22/02/2023	AS-BUILT	APM	BDA	STY	AG	
		C02	08/03/2021	ISSUED FOR CONSTRUCTION AND REVISED AS MARKED	APM	BDA	STY	AG	
MD-216-3980-EG-CV-GAD-V551-1485	GUIDE DRAWING - GOX BARRIER	C01	20/08/2020	ISSUED FOR CONSTRUCTION	APM	BDA	STY	AG	
MD-216-3980-EG-CV-GAD-V551-1484	GUIDE DRAWING - GOX BARRIER	A01	24/07/2020	ISSUED FOR REFERENCE	APM	BDA	STY	AG	

RESERVED FOR VENDOR LOGO AND DRAWING NUMBER

LARSEN & TOUBRO

This drawing is the property of LARSEN & TOUBRO and must not be passed on to any person or body not authorized by us to receive it nor be copied or otherwise made use either in full or in part by such person or body without our prior permission in writing.

Outotec

The content of these documents are the sole property of Outotec Oyj. Any rights not expressly granted herein are reserved. Reproduction, transfer or distribution of part or all of the contents in any form without prior written permission of Outotec is prohibited.

MA'ADEN معادن
Saudi Arabian Mining Company شركة التعدين العربية السعودية

This document and the information contained herein is Ma'aden proprietary know-how. This document or any part thereof should not be reproduced, stored in a retrieval system or transmitted by any means, electronic or otherwise, or divulged without prior written permission of Ma'aden.

LARSEN & TOUBRO DRAWING NUMBER: 019045_080_C_G_24197_007 | REVISION: 3
OUTOTEC DRAWING NUMBER: 900707__GAU01__AG22__MTL01__39862 | DOCUMENT ID: OU100689191 | REVISION: 3

DRAWN	APM	20/07/2020
CHECKED	BDA	22/07/2020
ENGINEER	STY	20/07/2020
APPROVED	AG	24/07/2020
EMPLOYER		
SCALE	1:100, 1:50	A1

MANSOURAH - MASSARAH GOLD PROJECT
GENERAL ARRANGEMENT DRAWING
OXYGEN PLANT
GOX BARRIER

DRAWING NUMBER: MD - 216 - 3980 - EG - CV - GAD - 1474 | REV: D01