


DRAWING NUMBER: MD-216-3980-EG-CV-GAD-1475 | REV: D01

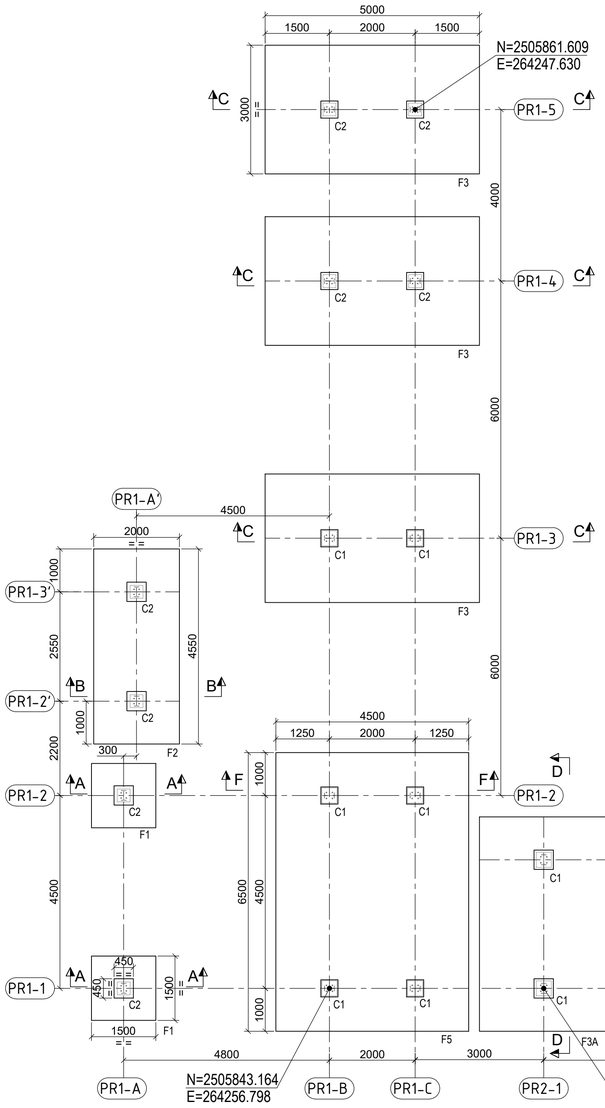


LAYOUT PLAN FOR PIPE RACK FOUNDATION
(SCALE - 1:75)

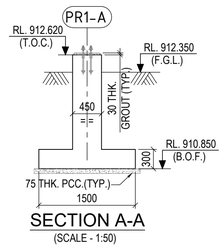


SECTION A-A
(SCALE - 1:50)

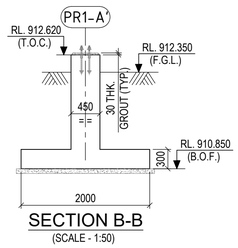


SECTION B-B
(SCALE - 1:50)

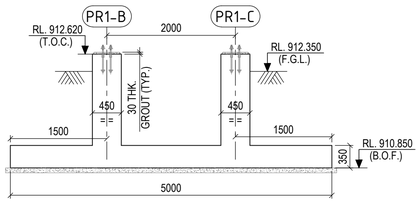


SECTION C-C
(SCALE - 1:50)

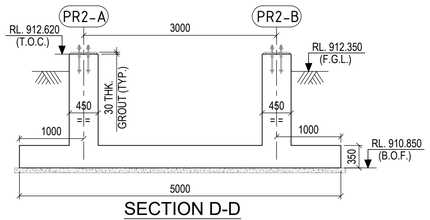


SECTION D-D
(SCALE - 1:50)

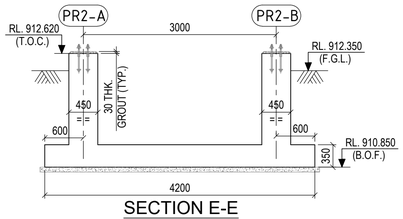


SECTION E-E
(SCALE - 1:50)

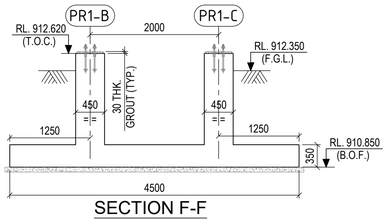


SECTION F-F
(SCALE - 1:50)

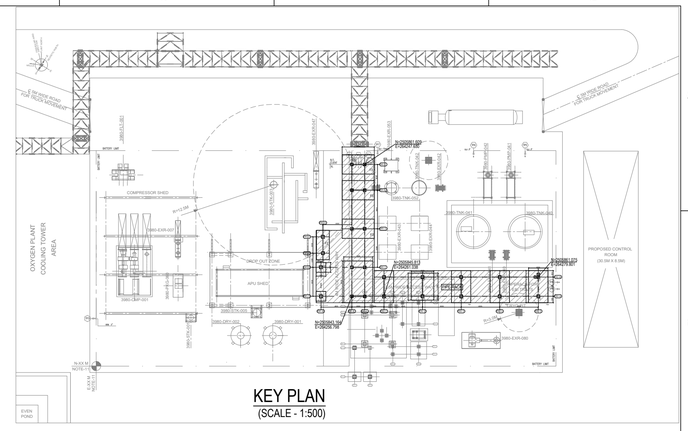


KEY PLAN
(SCALE - 1:500)

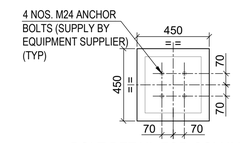

BOLT DETAIL FOR COLUMN - C1
(SCALE 1:20)

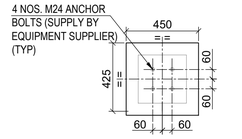

BOLT DETAIL FOR COLUMN - C2
(SCALE 1:20)

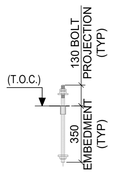

DETAIL OF M24 ANCHOR BOLT
(SUPPLY BY EQUIPMENT SUPPLIER)
(SCALE 1:20)

LEGEND :-

RL. - REDUCED LEVEL
F.G.L - FINISHED GROUND LEVEL
P.C.C - PLAIN CEMENT CONCRETE
T.O.C - TOP OF CONCRETE
B.O.F - BOTTOM OF FOUNDATION
THK. - THICK
TYP. - TYPICAL
DRG. - DRAWING

NOTES:-

1. ALL DIMENSIONS ARE IN MILLIMETRES AND LEVELS ARE IN METRES UNLESS OTHERWISE STATED.
2. GRADE OF CONCRETE SHALL BE C35 .
3. GRADE OF REINFORCEMENT SHALL BE DEFORMED BAR 420 MPa (GRADE 60)
4. NET SAFE BEARING CAPACITY CONSIDERED AT THE FOUNDING LEVEL IS 670 KN/SQ. M
5. IF ANY PART OF FOUNDATION COMES ON BACKFILL ZONE OF ADJACENT FOUNDATION OR ANY LOOSE POCKETS ARE ENCOUNTERED BELOW FOUNDATION LEVEL THE SAME SHALL BE REMOVED AND FILLED WITH PCC.
6. FOR REINFORCEMENT DRAWING REFER DRG. NO. MD-216-3980-EG-CV-DED-1477.

DOCUMENT NUMBER	REFERENCE DOCUMENTS	REV	DATE	REVISION DESCRIPTION	DRN	CHK	ENG	APP	EMP
		D01	22/02/2023	AS-BUILT	APM	BDA	STY	AG	
MD-216-3980-EG-CV-GAD-V551-1486	FOUNDATION LOAD DATA & ANCHORAGE-PIPE RACK - 1	C01	22/07/2020	ISSUED FOR CONSTRUCTION	APM	BDA	STY	AG	
MD-216-3980-EG-CV-GAD-V551-1476	FOUNDATION LOAD DATA & ANCHORAGE-PIPE RACK - 2	A01	23/06/2020	ISSUED FOR REFERENCE	APM	BDA	STY	AG	

RESERVED FOR VENDOR LOGO AND DRAWING NUMBER

LARSEN & TOUBRO
This drawing is the property of LARSEN & TOUBRO and must not be passed on to any person or body not authorized by us to receive it nor be copied or otherwise made use either in full or in part by such person or body without our prior permission in writing.

Outotec
The content of these documents are the sole property of Outotec Oyj. Any rights not expressly granted herein are reserved. Reproduction, transfer or distribution of part or all of the contents in any form without prior written permission of Outotec is prohibited.

MA'ADEN معادن
Saudi Arabian Mining Company شركة معادن العربية السعودية
This document and the information contained herein is Ma'aden proprietary know-how. This document or any part thereof should not be reproduced, stored in a retrieval system or transmitted by any means, electronic or otherwise, or divulged without prior written permission of Ma'aden.

LARSEN & TOUBRO DRAWING NUMBER	O19045_080_C_G_24197_008		REVISION 2
OUTOTEC DRAWING NUMBER	900707 __GAU01 __AG22__MTL01 __39863	DOCUMENT ID OU100689192	REVISION 2

DRAWN	APM	20/06/2020
CHECKED	BDA	22/06/2020
ENGINEER	STY	20/06/2020
APPROVED	AG	23/06/2020
EMPLOYER		
SCALE	1:100, 1:50	A1

MANSOURAH - MASSARAH GOLD PROJECT
GENERAL ARRANGEMENT DRAWING
OXYGEN PLANT
PIPERACK FOUNDATION

DRAWING NUMBER: MD-216-3980-EG-CV-GAD-1475 | REV: D01