


DRAWING NUMBER: MD-216-3980-EG-CV-GAD-1477 | REV: D01

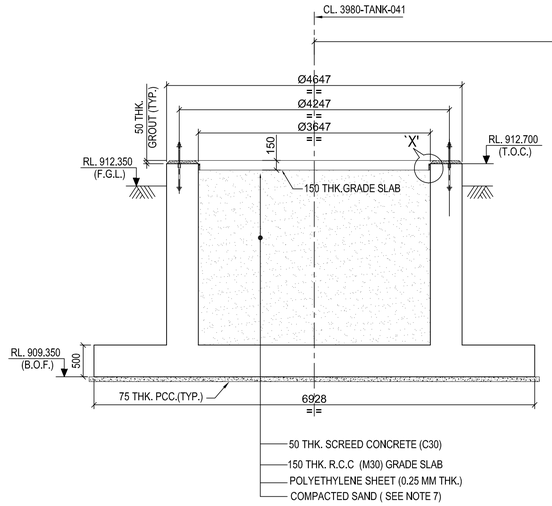



SECTION A-A
(SCALE - 1:50)

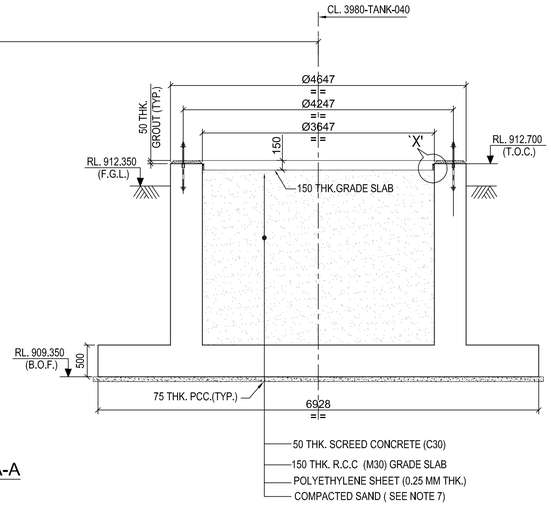




KEY PLAN
(SCALE - 1:500)

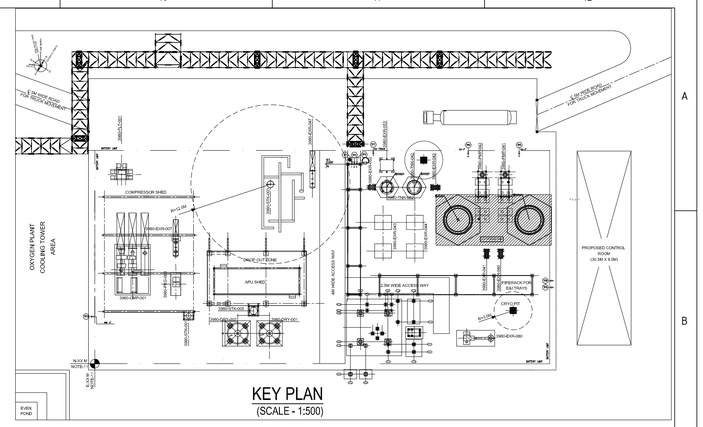

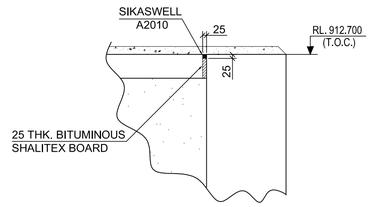
DETAIL - 'X'
(SCALE 1:20)

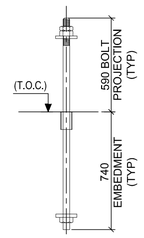


DETAIL OF M42 ANCHOR BOLT
(SUPPLY BY EQUIPMENT SUPPLIER)
(SCALE 1:20)

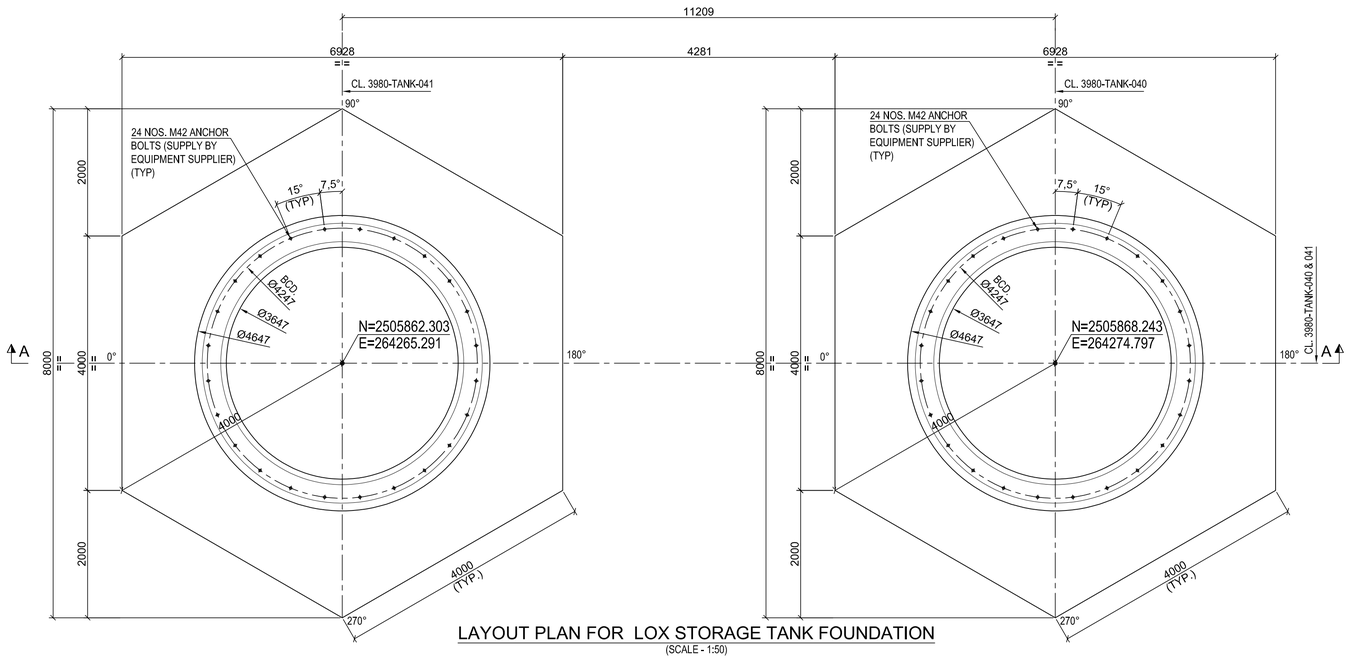


LAYOUT PLAN FOR LOX STORAGE TANK FOUNDATION
(SCALE - 1:50)

## LEGEND :-

RL. - REDUCED LEVEL
F.G.L - FINISHED GROUND LEVEL
P.C.C - PLAIN CEMENT CONCRETE
R.C.C - REINFORCED CEMENT CONCRETE
T.O.C - TOP OF CONCRETE
B.O.F - BOTTOM OF FOUNDATION
THK. - THICK
TYP. - TYPICAL
DRG. - DRAWING
CL. - CENTRE LINE
BCD - BOLT CIRCLE DIAMETER
Ø - DIAMETER
NO. - NUMBER
EQV. - EQUIVALENT

## NOTES:-

1. ALL DIMENSIONS ARE IN MILLIMETRES AND LEVELS ARE IN METRES UNLESS OTHERWISE STATED.
2. GRADE OF CONCRETE SHALL BE C35 .
3. GRADE OF REINFORCEMENT SHALL BE DEFORMED BAR 420 MPa (GRADE 60)
4. NET SAFE BEARING CAPACITY CONSIDERED AT THE FOUNDING LEVEL IS 670 KN/SQ. M
5. IF ANY PART OF FOUNDATION COMES ON BACKFILL ZONE OF ADJACENT FOUNDATION OR ANY LOOSE POCKETS ARE ENCOUNTERED BELOW FOUNDATION LEVEL THE SAME SHALL BE REMOVED AND FILLED WITH PCC.
6. FOR REINFORCEMENT DRAWING REFER DRG. NO. MD-216-3980-EG-CV-DED-1475.
7. SAND SHALL BE COMPACTED TO A MAXIMUM DEPTH OF 300 MM & SHALL BE COMPACTED TO 80% RELATIVE DENSITY AS DETERMINED BY ASTM D4253 & ASTM D4254

| DOCUMENT NUMBER | REFERENCE DOCUMENTS | REV | DATE | REVISION DESCRIPTION | DRN | CHK | ENG | APP | EMP |
|---|---|---|---|---|---|---|---|---|---|
| | | D01 | 18/02/2023 | AS-BUILT | NAEW-SN | BDA | STY | AG | |
| | | C02 | 16/09/2020 | ISSUED FOR CONSTRUCTION AND REVISED AS MARKED C02 | APM | BDA | STY | AG | |
| | | C01 | 20/08/2020 | ISSUED FOR CONSTRUCTION | APM | BDA | STY | AG | |
| MD-216-3980-EG-CV-GAD-V551-1490 | FOUNDATION LOAD & ANCHORAGE- LOX TANK | A01 | 30/07/2020 | ISSUED FOR REFERENCE | APM | BDA | STY | AG | |

RESERVED FOR VENDOR LOGO AND DRAWING NUMBER

LARSEN & TOUBRO

This drawing is the property of LARSEN & TOUBRO and must not be passed on to any person or body not authorized by us to receive it nor be copied or otherwise made use either in full or in part by such person or body without our prior permission in writing.

Outotec

The content of these documents are the sole property of Outotec Oyj. Any rights not expressly granted herein are reserved. Reproduction, transfer or distribution of part or all of the contents in any form without prior written permission of Outotec is prohibited.

MA'ADEN معادن
Saudi Arabian Mining Company شركة معادن العربية السعودية

This document and the information contained herein is Ma'aden proprietary know-how. This document or any part thereof should not be reproduced, stored in a retrieval system or transmitted by any means, electronic or otherwise, or divulged without prior written permission of Ma'aden.

LARSEN & TOUBRO DRAWING NUMBER: 019045_080_C_G_24197_010 | REVISION: 3
OUTOTEC DRAWING NUMBER: 900707 _GAU01 _AG22_MTL01 _39866 | DOCUMENT ID: OU100690687 | REVISION: 3

| | | |
|---|---|---|
| DRAWN | APM | 26/07/2020 |
| CHECKED | BDA | 27/07/2020 |
| ENGINEER | STY | 26/07/2020 |
| APPROVED | AG | 30/07/2020 |
| EMPLOYER | | |
| SCALE | 1:100, 1:50 | A1 |

MANSOURAH - MASSARAH GOLD PROJECT
GENERAL ARRANGEMENT DRAWING
OXYGEN PLANT
LOX TANK FOUNDATION

DRAWING NUMBER: MD-216-3980-EG-CV-GAD-1477 | REV: D01