


DRAWING NUMBER: MD - 216 - 3980 - EG - CV - GAD - 1481 | REV: D01

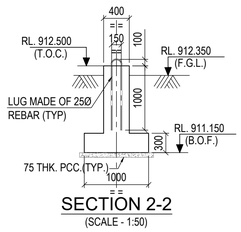


SECTION 2-2
(SCALE - 1:50)

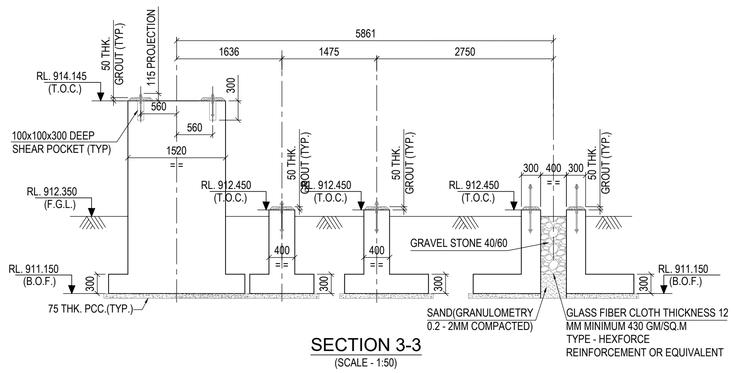


SECTION 3-3
(SCALE - 1:50)

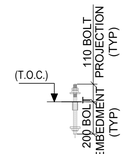


DETAIL OF M16 ANCHOR BOLT COLUMN C1
(SUPPLY BY EQUIPMENT SUPPLIER)
(SCALE 1:20)

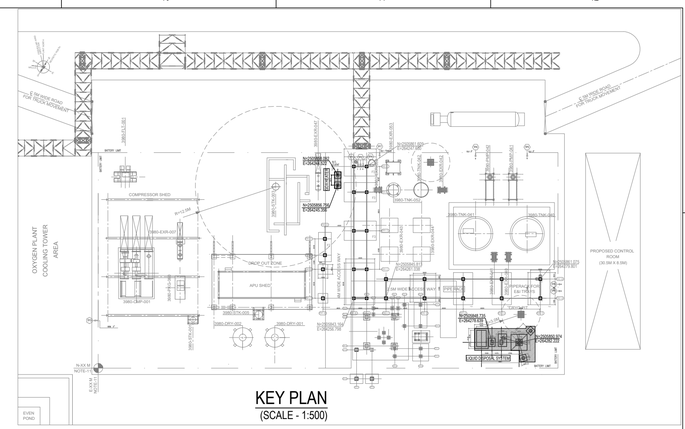


KEY PLAN
(SCALE - 1:500)

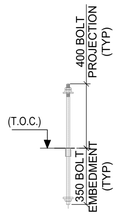


DETAIL OF M24 ANCHOR BOLT COLUMN C3
(SUPPLY BY EQUIPMENT SUPPLIER)
(SCALE 1:20)

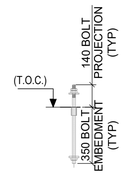


DETAIL OF M24 ANCHOR BOLT COLUMN C4
(SUPPLY BY EQUIPMENT SUPPLIER)
(SCALE 1:20)

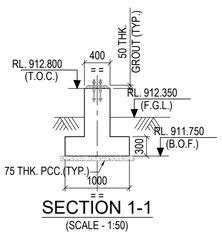


SECTION 1-1
(SCALE - 1:50)

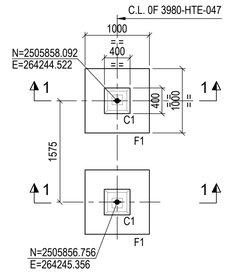


LAYOUT PLAN FOR GOX HEATER
(SCALE - 1:50)

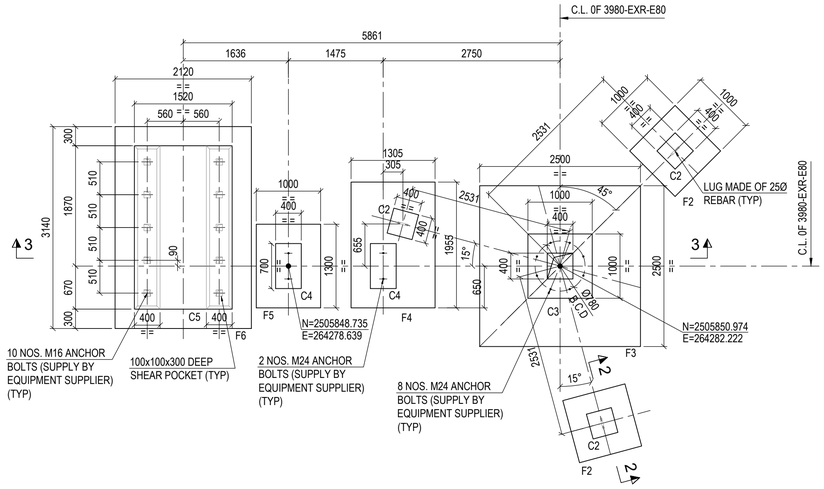

LAYOUT PLAN FOR LIQUID DISPOSAL SYSTEM
(SCALE - 1:50)

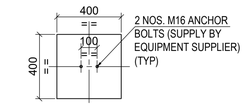

BOLT PLAN FOR COLUMN C1
(SCALE 1:20)

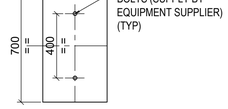

BOLT PLAN FOR COLUMN C4
(SCALE 1:20)

LEGEND :-

RL. - REDUCED LEVEL
F.G.L - FINISHED GROUND LEVEL
P.C.C - PLAIN CEMENT CONCRETE
T.O.C - TOP OF CONCRETE
B.O.F - BOTTOM OF FOUNDATION
Ø - DIAMETER
C.L. - CENTRE LINE
THK. - THICK
TYP. - TYPICAL
DRG. - DRAWING
B.C.D. - BOLT CENTRE DIAMETER

NOTES:-

1. ALL DIMENSIONS ARE IN MILLIMETRES AND LEVELS ARE IN METRES UNLESS OTHERWISE STATED.
2. GRADE OF CONCRETE SHALL BE C35 .
3. GRADE OF REINFORCEMENT SHALL BE DEFORMED BAR 420 MPa (GRADE 60)
4. NET SAFE BEARING CAPACITY CONSIDERED AT THE FOUNDING LEVEL IS 670 KN/SQ. M
5. IF ANY PART OF FOUNDATION COMES ON BACKFILL ZONE OF ADJACENT FOUNDATION OR ANY LOOSE POCKETS ARE ENCOUNTERED BELOW FOUNDATION LEVEL THE SAME SHALL BE REMOVED AND FILLED WITH PCC.
6. FOR REINFORCEMENT DRAWING REFER DRG. NO. MD-216-3980-EG-CV-DED-1483.

DOCUMENT NUMBER	REFERENCE DOCUMENTS	REV	DATE	REVISION DESCRIPTION	DRN	CHK	ENG	APP	EMP
		D01	22/02/2023	AS-BUILT	APM	BDA	STY	AG	
MD-216-3980-EG-CV-GAD-V551-1496	FOUNDATION LOAD - LIQUID DISPOSAL	C01	21/11/2020	ISSUED FOR CONSTRUCTION	APM	BDA	STY	AG	
MD-216-3980-EG-CV-GAD-V551-1497	FOUNDATION LOAD DATA & ANCHORAGE-GOX HEATER	A01	16/10/2020	ISSUED FOR REFERENCE	APM	BDA	STY	AG	

RESERVED FOR VENDOR LOGO AND DRAWING NUMBER

LARSEN & TOUBRO

This drawing is the property of LARSEN & TOUBRO and must not be passed on to any person or body not authorized by us to receive it nor be copied or otherwise made use either in full or in part by such person or body without our prior permission in writing.

Outotec

The content of these documents are the sole property of Outotec Oyj. Any rights not expressly granted herein are reserved. Reproduction, transfer or distribution of part or all of the contents in any form without prior written permission of Outotec is prohibited.

MA'ADEN معادن
Saudi Arabian Mining Company شركة التعدين العربية السعودية

This document and the information contained herein is Ma'aden proprietary know-how. This document or any part thereof should not be reproduced, stored in a retrieval system or transmitted by any means, electronic or otherwise, or divulged without prior written permission of Ma'aden.

LARSEN & TOUBRO DRAWING NUMBER: O19045_080_C_G_24197_014 | REVISION: 2
OUTOTEC DRAWING NUMBER: 900707__GAU01__AG22__MTL01__39879 | DOCUMENT ID: OU100704038 | REVISION: 2

DRAWN	APM	10/10/2020
CHECKED	BDA	13/10/2020
ENGINEER	STY	10/10/2020
APPROVED	AG	16/10/2020
EMPLOYER		
SCALE	1:100, 1:50	A1

MANSOURAH - MASSARAH GOLD PROJECT
GENERAL ARRANGEMENT DRAWING
OXYGEN PLANT
GOX HEATER AND LIQUID DISPOSAL SYSTEM

DRAWING NUMBER: MD - 216 - 3980 - EG - CV - GAD - 1481 | REV: D01