


DRAWING NUMBER: MD-216-3980-EG-CV-GAD-1484 | REV: D01

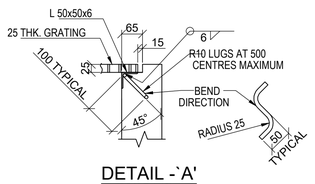


DETAIL -`A'
(SCALE 1:10)

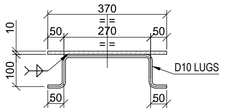


SECTION E1 - E1
(SCALE 1:10)

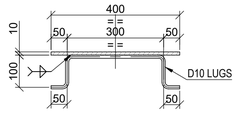


SECTION E3 - E3
(SCALE 1:10)

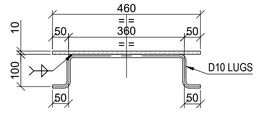


SECTION E6 - E6
(SCALE 1:10)

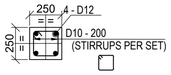


SECTION : G2-G2
(SCALE 1:25)

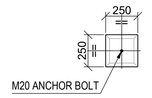


SECTION : G3-G3
(SCALE 1:25)

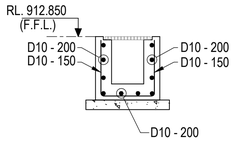


TYPICAL R.C. DETAIL OF DRAIN
(SCALE 1:25)

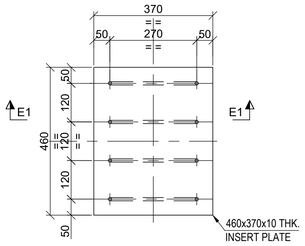


DETAIL OF INSERT PLATE - IP3
(SCALE 1:10)

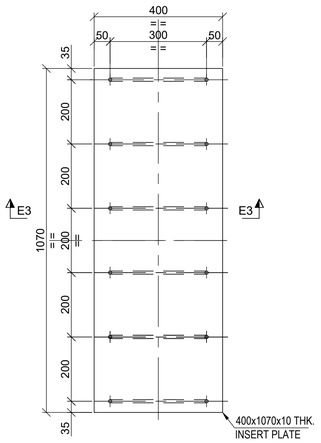


DETAIL OF INSERT PLATE - IP4
(SCALE 1:10)

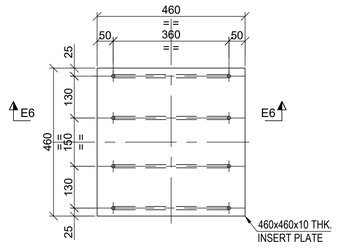


DETAIL OF INSERT PLATE - IP5
(SCALE 1:10)

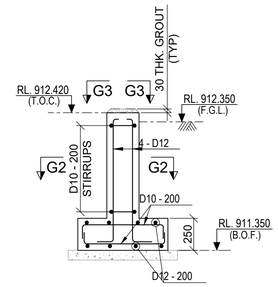


SECTION G1 - G1
(SCALE 1:25)

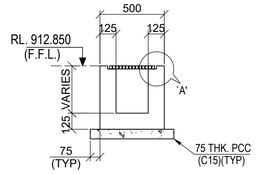


TYPICAL DETAIL OF DRAIN
(REF. DWG. NO. : MD-216-3980-EG-CV-GAD-1483)
(SCALE 1:25)

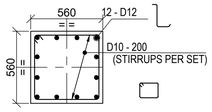


SECTION : E6A - E6A
(SCALE 1:25)

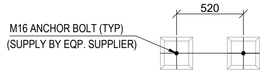


SECTION : F2-F2
(SCALE 1:25)

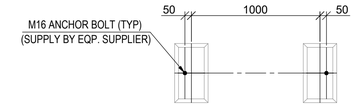


SECTION : F4-F4
(SCALE 1:25)

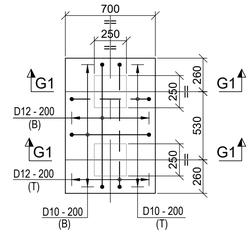


R.C. DETAIL OF FOUNDATION - F1A
(REF. DWG. NO. : MD-216-3980-EG-CV-GAD-1483)
(SCALE 1:25)

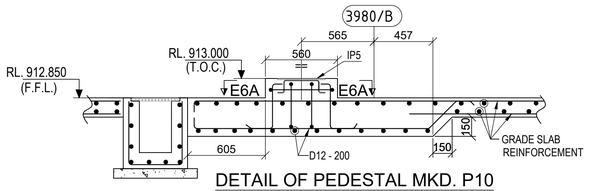


DETAIL OF PEDESTAL MKD. P10
(REF. DWG. NO. : MD-216-3980-EG-CV-GAD-1483)
(SCALE 1:25)

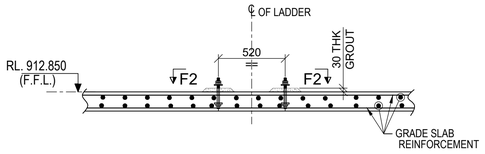

SECTION : F1-F1
(REF. DWG. NO. : MD-216-3980-EG-CV-GAD-1483)
(SCALE 1:25)

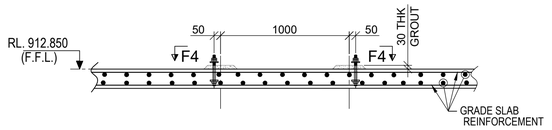


SECTION : F3-F3
(REF. DWG. NO. : MD-216-3980-EG-CV-GAD-1483)
(SCALE 1:25)

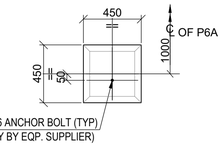


TOP VIEW OF P6A
(SCALE 1:25)

LEGEND :-


R.L. - REDUCED LEVEL
T.O.C. - TOP OF CONCRETE.
B.O.F. - BOTTOM OF FOUNDATION
F.G.L. - FINISHED GROUND LEVEL
F.F.L. - FINISHED FLOOR LEVEL
P.C.C - PLAIN CEMENT CONCRETE
TYP. - TYPICAL.
MKD. - MARKED.
THK. - THICK
℄ - CENTRE LINE
PL. - PLATE
BOTTOM REINFORCEMENT (B) ———
TOP REINFORCEMENT (T) - - — — — —
R.C. - REINFORCED CONCRETE

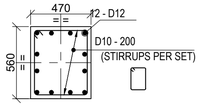


SECTION : E1A - E1A
(SCALE 1:25)

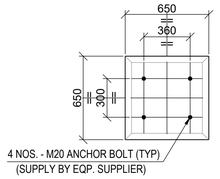


TOP VIEW OF P4
(SCALE 1:25)

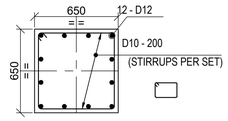


SECTION : E2 - E2
(SCALE 1:25)

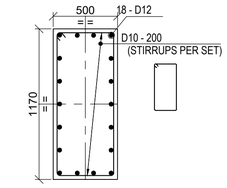


SECTION : E3A - E3A
(SCALE 1:25)

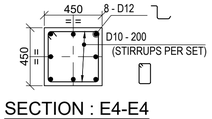

SECTION : E4-E4
(SCALE 1:25)

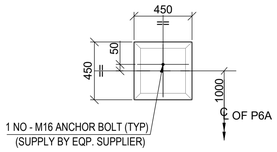


TOP VIEW OF P6
(SCALE 1:25)

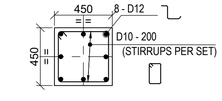


SECTION : E5-E5
(SCALE 1:25)

NOTES :-


1. ALL DIMENSIONS ARE IN MILLIMETRES AND LEVELS AND CO-ORDINATES ARE IN METRES. UNLESS OTHERWISE STATED.
2. GRADE OF CONCRETE SHALL BE C35.
3. GRADE OF REINFORCEMENT SHALL BE DEFORMED BAR ASTM A615 - GRADE 60 (fy = 420 MPa).
4. CLEAR COVER OF REINFORCEMENT SHALL BE AS FOLLOWS:
   a) FOUNDATION = 50 mm.
   b) COLUMN = 50 mm.
   c) WALL : 50 mm. (FOR DOUBLE LAYER REINF.)
      VERTICAL REINF. PLACED AT CENTRE (FOR SINGLE LAYER REINF.)
   d) SLAB : 20 mm.
5. IF ANY PART OF FOUNDATION COMES ON BACKFILL ZONE OF ADJACENT FOUNDATION OR ANY LOOSE POCKETS ARE ENCOUNTERED BELOW FOUNDATION LEVEL THE SAME SHALL BE REMOVED AND FILLED WITH PCC.
6. THIS DRAWING IS READ IN CONJUNCTION WITH DRG. NO : MD-216-3980-EG-CV-GAD-1470. MD-216-3980-EG-CV-GAD-1483.
7. FOR BOLT DETAILS REFER DRG. NO : MD-216-1000-EG-CV-DED-1003.
8. FOR GENERAL NOTE FOR CIVIL WORK REFER DRG. NO : MD-216-1000-EG-CV-DED-1001.
9. FOR STANDARD REINF. DETAIL REFER DRG. NO : MD-216-1000-EG-CV-DED-1005.
10. REINFORCEMENT MAY BE SLIGHTLY ADJUSTED AT SITE TO ACCOMMODATE EMBEDDED PART.

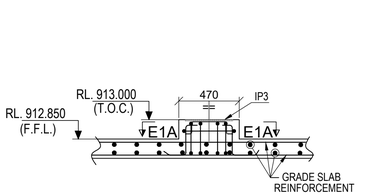


DETAIL OF PEDESTAL MKD. P2, P3, P7 & P8
(SCALE 1:25)

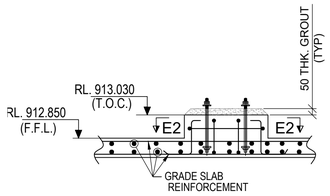


DETAIL OF PEDESTAL MKD. P4
(REF. DWG. NO. : MD-216-3980-EG-CV-GAD-1483)
(SCALE 1:25)

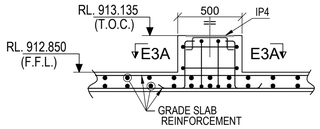

DETAIL OF PEDESTAL MKD. P5
(REF. DWG. NO. : MD-216-3980-EG-CV-GAD-1483)
(SCALE 1:25)

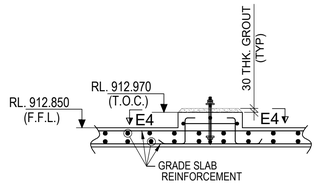

DETAIL OF PEDESTAL MKD. P6
(REF. DWG. NO. : MD-216-3980-EG-CV-GAD-1483)
(SCALE 1:25)

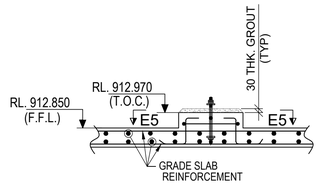

DETAIL OF PEDESTAL MKD. P6A
(REF. DWG. NO. : MD-216-3980-EG-CV-GAD-1483)
(SCALE 1:25)

DOCUMENT NUMBER	REFERENCE DOCUMENTS	REV	DATE	REVISION DESCRIPTION	DRN	CHK	ENG	APP	EMP
MD-216-3980-EG-CV-GAD-V551-1480	FOUNDATION LOAD & ANCHORAGE - COMPRESSOR								
MD-216-3980-EG-CV-GAD-V551-1482	FOUNDATION LOAD - AIR/WATER EXCHANGER E07								
MD-216-3980-EG-ST-GAD-V551-1489	GUIDE DRAWING COMPPESSOR ROOM (SHT 3 OF 3)								
MD-216-3980-EG-ST-GAD-V551-1488	GUIDE DRAWING COMPPESSOR ROOM (SHT 2 OF 3)	D01	22/02/2023	AS-BUILT	SBH	BDA	SUE	AG	
MD-216-3980-EG-ST-GAD-V551-1477	GUIDE DRAWING COMPPESSOR ROOM (SHT 1 OF 3)	C01	24/12/2020	ISSUED FOR CONSTRUCTION	SBH	BDA	SUE	AG	
MD-216-3980-EG-PI-PPD-V551-1001	OXYGEN PLANT PLOT PLAN	A01	19/11/2020	ISSUED FOR REVIEW	SBH	BDA	SUE	AG	

RESERVED FOR VENDOR LOGO AND DRAWING NUMBER

LARSEN & TOUBRO
This drawing is the property of *LARSEN & TOUBRO* and must not be passed on to any person or body not authorized by us to receive it nor be copied or otherwise made use either in full or in part by such person or body without our prior permission in writing.

Outotec
The content of these documents are the sole property of Outotec Oyj. Any rights not expressly granted herein are reserved. Reproduction, transfer or distribution of part or all of the contents in any form without prior written permission of Outotec is prohibited.

MA'ADEN معادن
Saudi Arabian Mining Company شركة التعدين العربية السعودية
This document and the information contained herein is Ma'aden proprietary know-how. This document or any part thereof should not be reproduced, stored in a retrieval system or transmitted by any means, electronic or otherwise, or divulged without prior written permission of Ma'aden.

LARSEN & TOUBRO DRAWING NUMBER	019045_080_C_G_24197_017		REVISION 2
OUTOTEC DRAWING NUMBER	900707 _GAU01 _AG22_MTL01 _39886	DOCUMENT ID OU100706471	REVISION 2

DRAWN	SBH	17/11/2020
CHECKED	BDA	18/11/2020
ENGINEER	SUE	17/11/2020
APPROVED	AG	19/11/2020
EMPLOYER		
SCALE	1:100, 1:75	A1

MANSOURAH - MASSARAH GOLD PROJECT
GENERAL ARRANGEMENT DRAWING
OXYGEN PLANT
COMPRESSOR SHED GRADE SLAB DETAILS

DRAWING NUMBER: MD - 216 - 3980 - EG - CV - GAD - 1484 | REV: D01