

DRAWING NUMBER: MD-216-3980-EG-CV-GAD-1486 | REV: D01

MATCH LINE A-A

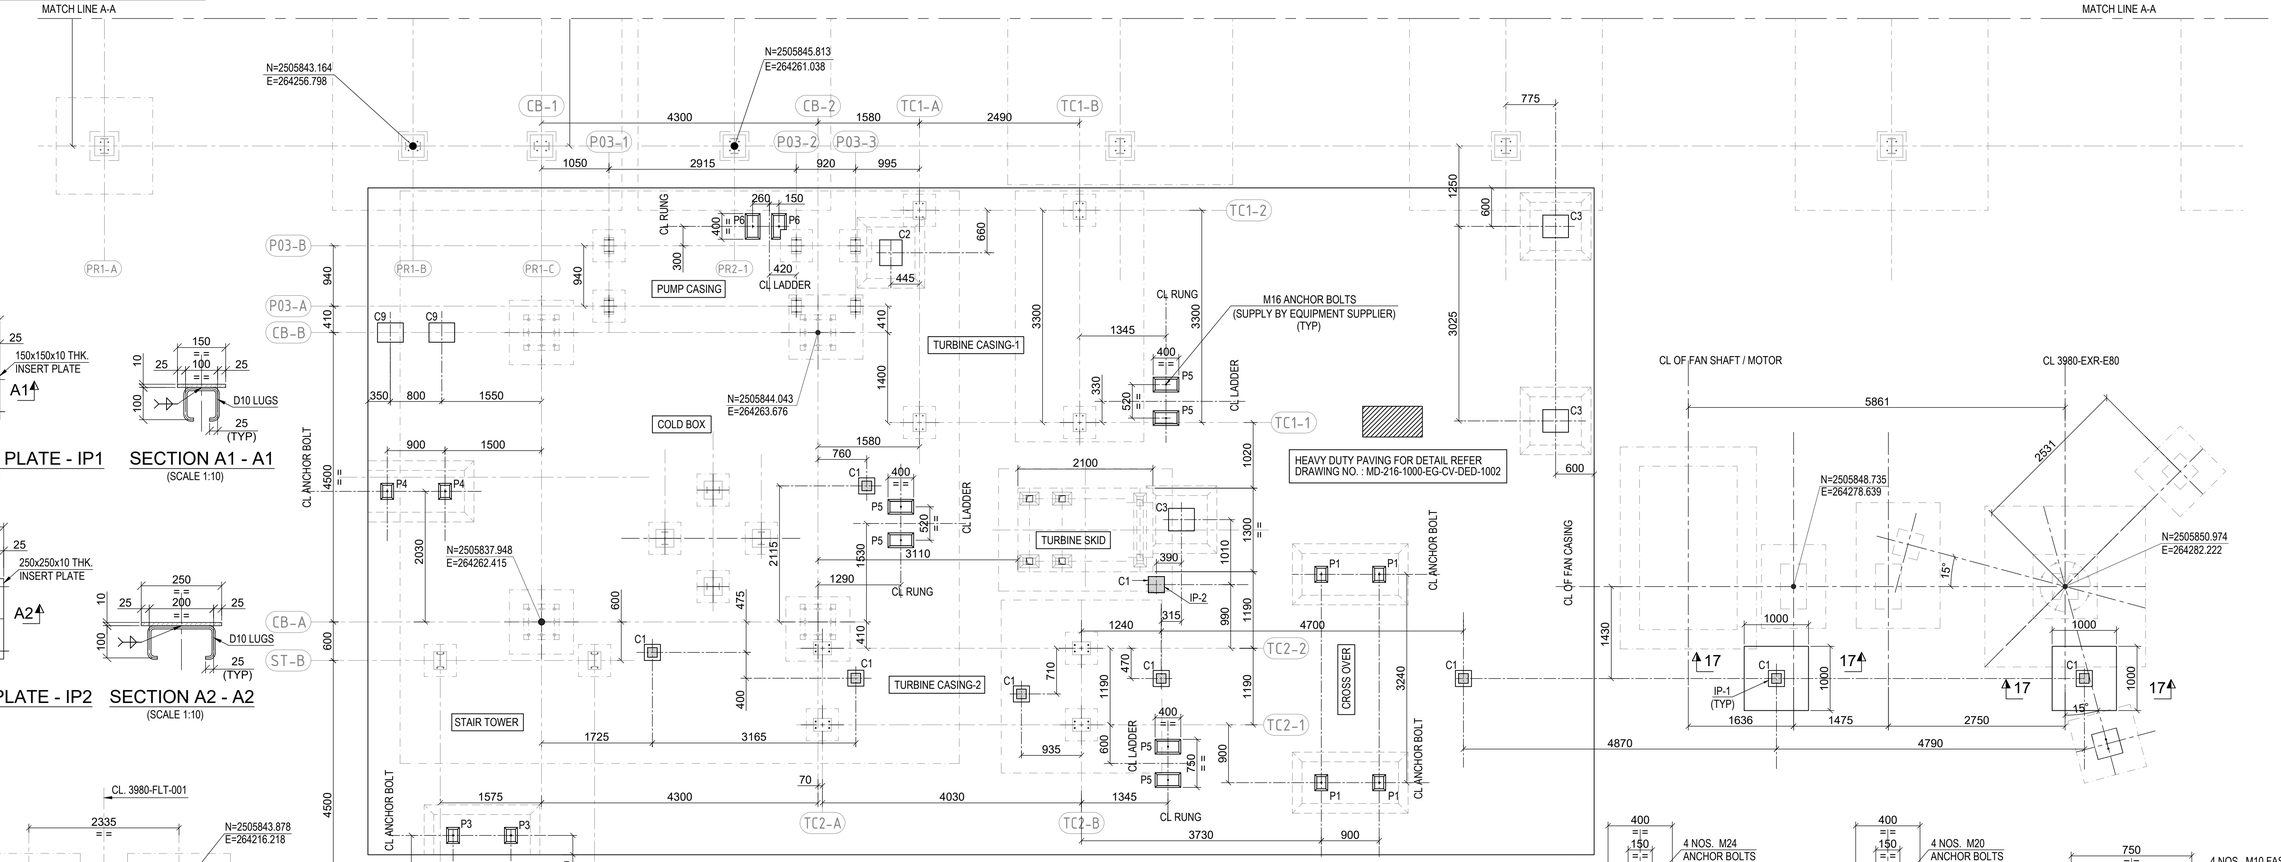


LAYOUT PLAN OF PIPE & TRAY SUPPORT
(SCALE 1:50)

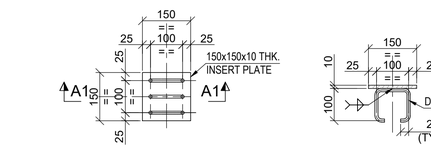


DETAIL OF INSERT PLATE - IP1
(SCALE 1:10)

SECTION A1 - A1
(SCALE 1:10)

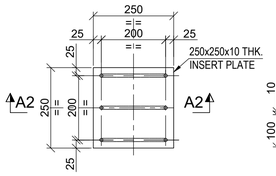


DETAIL OF INSERT PLATE - IP2
(SCALE 1:10)


SECTION A2 - A2
(SCALE 1:10)

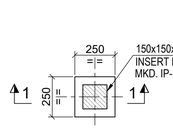


BOLT DETAIL FOR COLUMN - C1
(SCALE 1:20)

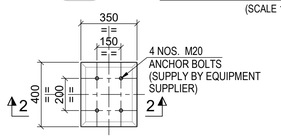


BOLT DETAIL FOR COLUMN - C2
(SCALE 1:20)

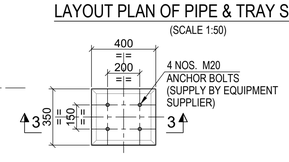


BOLT DETAIL FOR COLUMN - C3
(SCALE 1:20)

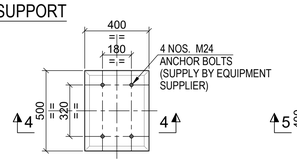


BOLT DETAIL FOR COLUMN - C4
(SCALE 1:20)

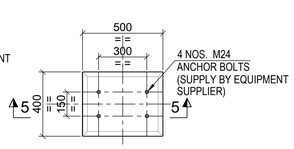


BOLT DETAIL FOR COLUMN - C5
(SCALE 1:20)

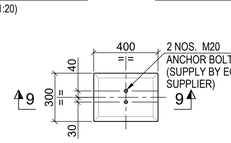


BOLT DETAIL FOR COLUMN - C9
(SCALE 1:20)

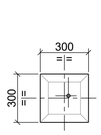


BOLT DETAIL FOR COLUMN - C10
(FOR BOLT POSITION REFER DETAIL '1' TO '4')
(SCALE 1:20)

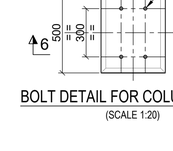


BOLT DETAIL FOR COLUMN - C6
(SCALE 1:20)

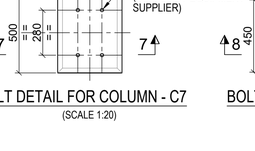


BOLT DETAIL FOR COLUMN - C7
(SCALE 1:20)

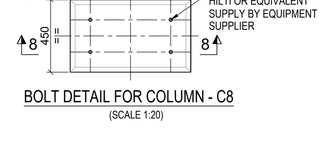


BOLT DETAIL FOR COLUMN - C8
(SCALE 1:20)

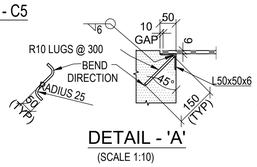


DETAIL - 'A'
(SCALE 1:10)

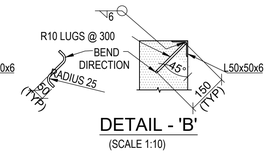


DETAIL - 'B'
(SCALE 1:10)

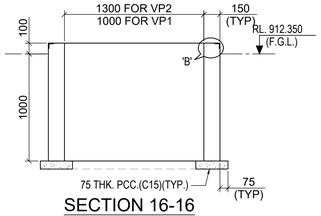

SECTION 16-16
(DETAIL OF VAPORIZATION PIT VP1 / VP2)
(SCALE - 1:30)

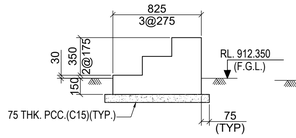

SECTION 14-14
DETAIL OF CONCRETE STEP MKD. - CSP1
(SCALE - 1:30)

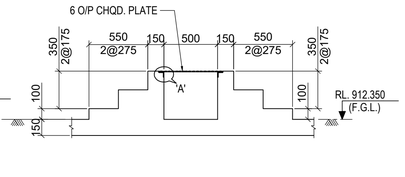

SECTION 15-15
DETAIL OF CONCRETE CROSS OVER MKD. - CCR1
(SCALE - 1:30)

LEGENDS :-

RL - REDUCED LEVEL
F.G.L - FINISHED GROUND LEVEL
P.C.C - PLAIN CEMENT CONCRETE
T.O.C - TOP OF CONCRETE
B.O.F - BOTTOM OF FOUNDATION
THK. - THICK
TYP. - TYPICAL
DRG. - DRAWING
CL. - CENTRE LINE
MKD. - MARKED
REF. - REFER
CHQD. - CHEQUERED

NOTES:-

1. ALL DIMENSIONS ARE IN MILLIMETRES AND LEVELS ARE IN METRES UNLESS OTHERWISE STATED.
2. GRADE OF CONCRETE SHALL BE C35 .
3. GRADE OF REINFORCEMENT SHALL BE DEFORMED BAR 420 MPa (GRADE 60)
4. FOR REINFORCEMENT DRAWING REFER DRG. NO. MD-216-3980-EG-CV-DED-1485.
5. FOR STANDARD DETAILS FOR PAVING REF. DRG. NO : MD-216-1000-EG-CV-DED-1002.

DOCUMENT NUMBER	REFERENCE DOCUMENTS	REV	DATE	REVISION DESCRIPTION	DRN	CHK	ENG	APP	EMP
MD-216-3980-EG-CV-GAD-V551-1503	FOUNDATION LOAD-PIPE & TRAY SUPPORT SHT-6								
MD-216-3980-EG-CV-GAD-V551-1502	FOUNDATION LOAD-PIPE & TRAY SUPPORT SHT-5								
MD-216-3980-EG-CV-GAD-V551-1501	FOUNDATION LOAD-PIPE & TRAY SUPPORT SHT-4								
MD-216-3980-EG-CV-GAD-V551-1499	FOUNDATION LOAD-PIPE & TRAY SUPPORT SHT-3	D01	22/02/2023	AS-BUILT	AMT	BDA	STY	AG	
MD-216-3980-EG-CV-GAD-V551-1498	FOUNDATION LOAD-PIPE & TRAY SUPPORT SHT-2	C01	26/03/2021	ISSUED FOR CONSTRUCTION	AMT	BDA	STY	AG	
MD-216-3980-EG-CV-GAD-V551-1487	FOUNDATION LOAD-PIPE & TRAY SUPPORT SHT-1	A01	18/02/2021	ISSUED FOR REVIEW	AMT	BDA	STY	AG	

RESERVED FOR VENDOR LOGO AND DRAWING NUMBER

LARSEN & TOUBRO

This drawing is the property of LARSEN & TOUBRO and must not be passed on to any person or body not authorized by us to receive it nor be copied or otherwise made use either in full or in part by such person or body without our prior permission in writing.

Outotec

The content of these documents are the sole property of Outotec Oyj. Any rights not expressly granted herein are reserved. Reproduction, transfer or distribution of part or all of the contents in any form without prior written permission of Outotec is prohibited.

MA'ADEN معادن
Saudi Arabian Mining Company شركة التعدين العربية السعودية

This document and the information contained herein is Ma'aden proprietary know-how. This document or any part thereof should not be reproduced, stored in a retrieval system or transmitted by any means, electronic or otherwise, or divulged without prior written permission of Ma'aden.

DRAWN	AMT	15/02/2021
CHECKED	BDA	16/02/2021
ENGINEER	STY	15/02/2021
APPROVED	AG	18/02/2021
EMPLOYER		
SCALE	1:100, 1:50	A1

LARSEN & TOUBRO DRAWING NUMBER: 019045_080_C_G_24197_019 | REVISION: 2
OUTOTEC DRAWING NUMBER: 900707__GAU01__AG22__MTL01__39888 | DOCUMENT ID: OU100707469 | REVISION: 2

MANSOURAH - MASSARAH GOLD PROJECT
GENERAL ARRANGEMENT DRAWING
OXYGEN PLANT
LAYOUT OF PIPE & TRAY SUPPORT (SHT 2 OF 3)

DRAWING NUMBER: MD - 216 - 3980 - EG - CV - GAD - 1486 | REV: D01