

DRAWING NUMBER: MD - 216 - 3980 - EG - CV - GAD - 1488 | REV: D01

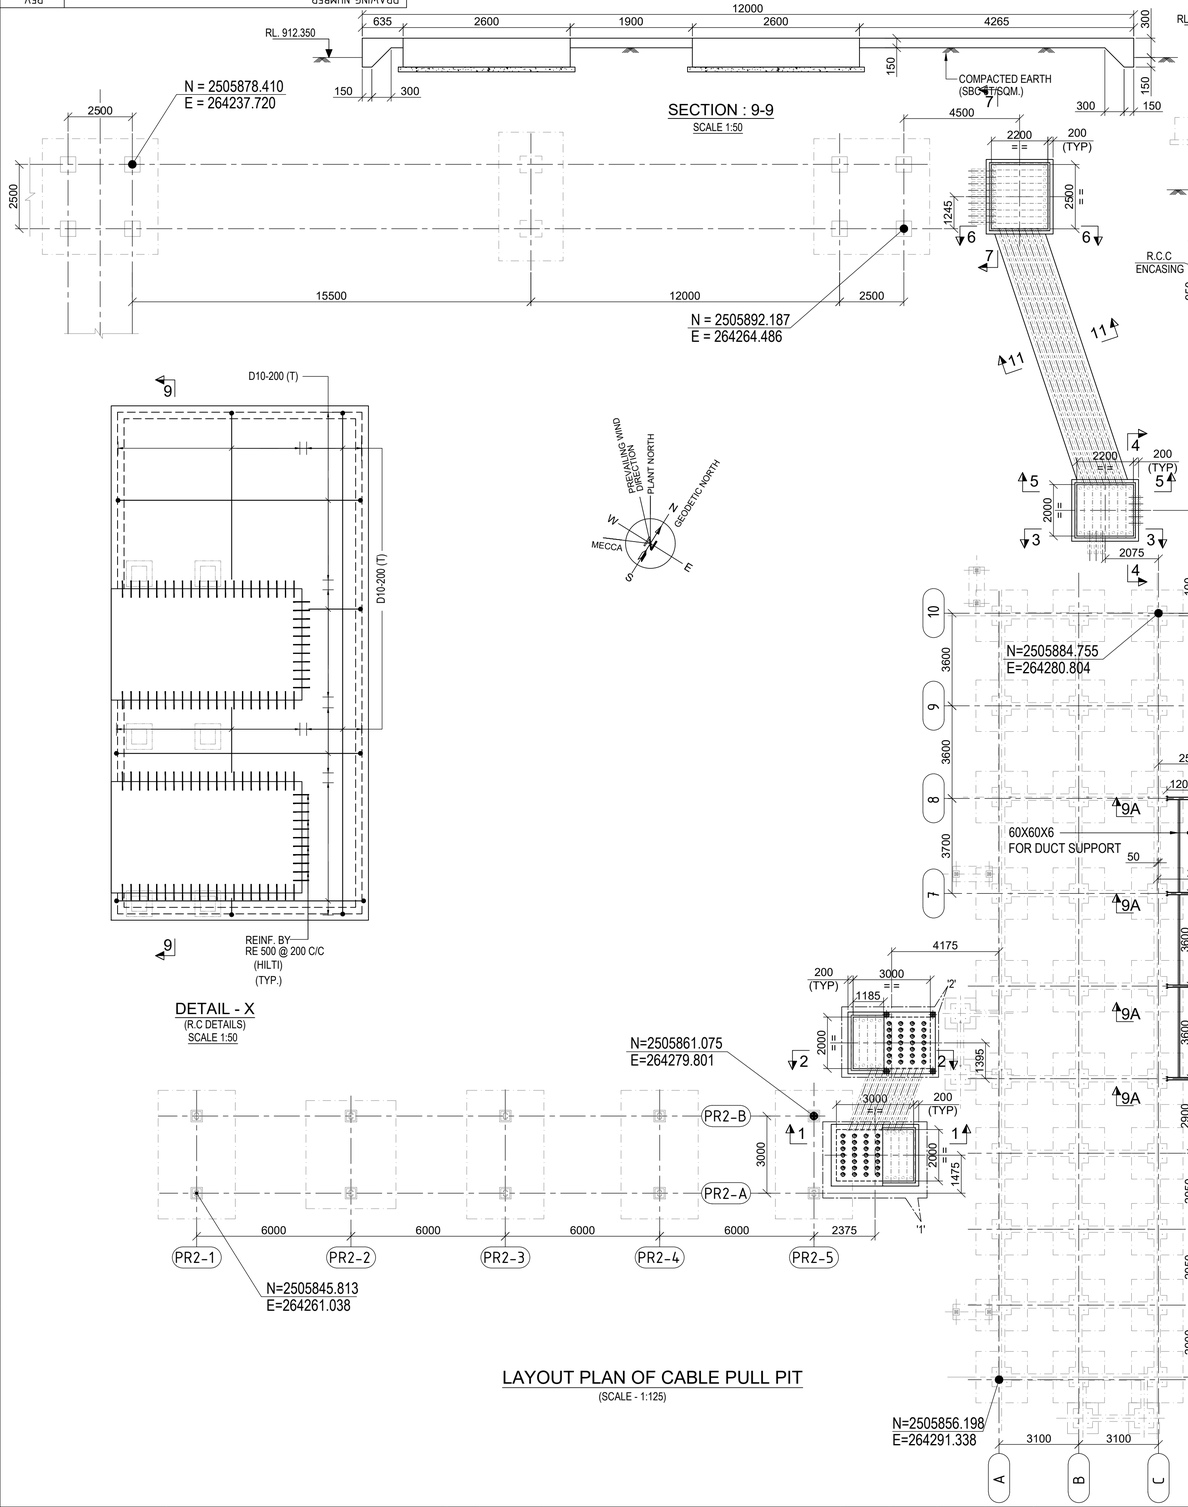


SECTION : 9-9
SCALE 1:50

DETAIL - X
(R.C DETAILS)
SCALE 1:50


LAYOUT PLAN OF CABLE PULL PIT
(SCALE - 1:125)

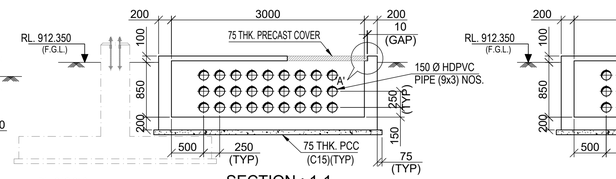


SECTION : 1-1
SCALE 1:50

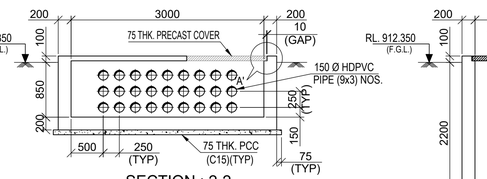


SECTION : 2-2
SCALE 1:50

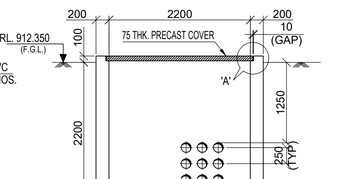


SECTION : 3-3
SCALE 1:50

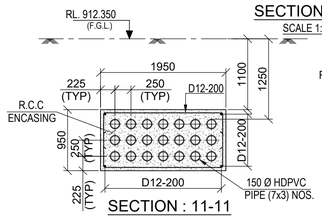


SECTION : 11-11
SCALE 1:50

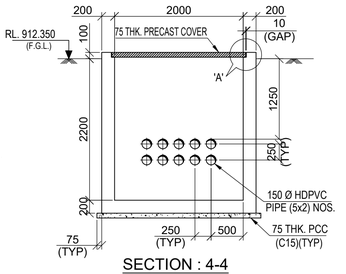


SECTION : 4-4
SCALE 1:50

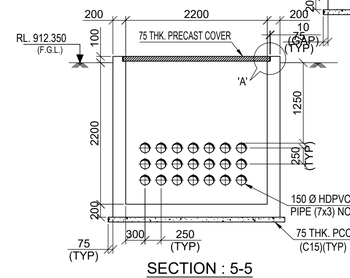


SECTION : 5-5
SCALE 1:50

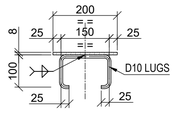


SECTION 10 - 10
(SCALE 1:10)

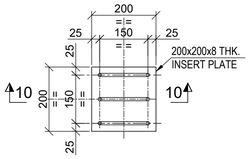


DETAIL OF INSERT PLATE - IP1
(SCALE 1:10)

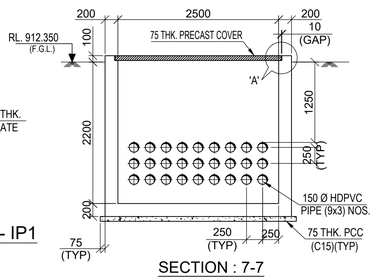


SECTION : 7-7
SCALE 1:50

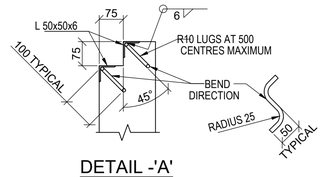


DETAIL -'A'
(SCALE 1:10)

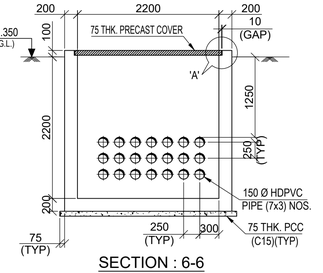


SECTION : 6-6
SCALE 1:50

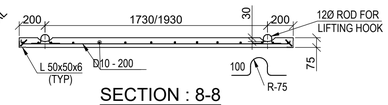


SECTION : 8-8

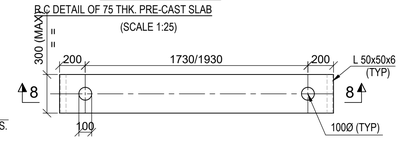


DETAIL OF 75 THK. PRE-CAST SLAB
(SCALE 1:25)

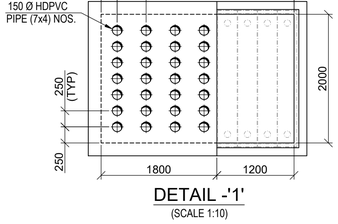


DETAIL -'1'
(SCALE 1:10)

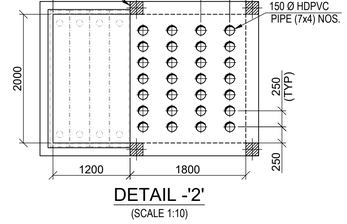


DETAIL -'2'
(SCALE 1:10)

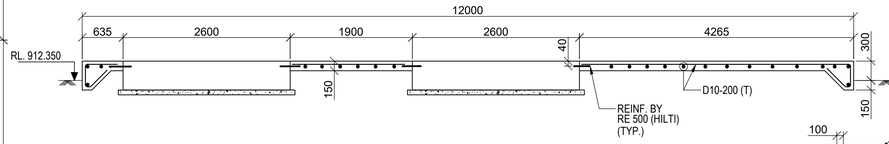


SECTION : 9-9
(R.C DETAILS)
SCALE 1:50

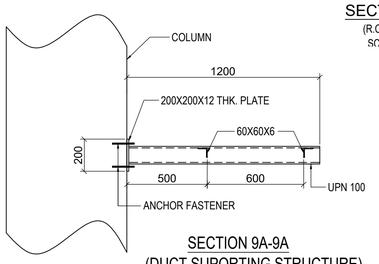

SECTION 9A-9A
(DUCT SUPORTING STRUCTURE)
(SCALE 1:20)

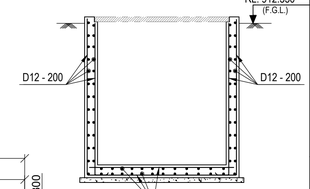

RC DETAILS OF PIT
(FOR 2300 DEPTH)
(SCALE 1:50)

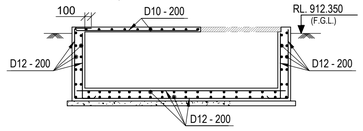

RC DETAILS OF PIT
(FOR 950 DEPTH)
(SCALE 1:50)

LEGEND :-

RL. - REDUCED LEVEL
F.G.L - FINISHED GROUND LEVEL
P.C.C - PLAIN CEMENT CONCRETE
T.O.C - TOP OF CONCRETE
B.O.F - BOTTOM OF FOUNDATION
THK. - THICK
TYP. - TYPICAL
DRG. - DRAWING
CL. - CENTRE LINE
MKD. - MARKED
MAX. - MAXIMUM
RC. - REINFORCED CONCRETE
Ø - DIAMETER
R.C.C. - REINFORCED CEMENT CONCRETE
REINF. - REINFORCEMENT

NOTES:-

1. ALL DIMENSIONS ARE IN MILLIMETRES AND LEVELS ARE IN METRES UNLESS OTHERWISE STATED.
2. GRADE OF CONCRETE SHALL BE C35 .
3. GRADE OF REINFORCEMENT SHALL BE DEFORMED BAR 420 MPa (GRADE 60)
4. NET SAFE BEARING CAPACITY CONSIDERED AT THE FOUNDING LEVEL IS 460 KN/SQ. M
5. IF ANY PART OF FOUNDATION COMES ON BACKFILL ZONE OF ADJACENT FOUNDATION OR ANY LOOSE POCKETS ARE ENCOUNTERED BELOW FOUNDATION LEVEL THE SAME SHALL BE REMOVED AND FILLED WITH PCC.
6. CLEAR COVER TO MAIN REINFORCEMENT SHALL BE PEDESTALS = 50 MM., WALL & BOTTOM SLAB = 50MM.

DOCUMENT NUMBER	REFERENCE DOCUMENTS	REV	DATE	REVISION DESCRIPTION	DRN	CHK	ENG	APP	EMP
		D01	22/02/2023	AS-BUILT	SYA	SJM	AVG	AG	
		C02	13/08/2021	ISSUED FOR CONSTRUCTION & REVISED AS MARKED	SYA	SJM	AVG	AG	
		C01	05/04/2021	ISSUED FOR CONSTRUCTION & REVISED AS PER	AMT	BDA	STY	AG	
MD-216-3980-EG-EL-LAD-1021	CABLE ROUTE LAYOUT - SUBSTATION AREA			EMPOLYER'S COMMENT ON 30/03/2021 & AS MKD.					
MD-216-3980-EG-EL-LAD-1021	CABLE ROUTE LAYOUT - SUBSTATION AREA	A01	02/03/2021	ISSUED FOR REVIEW	AMT	BDA	STY	AG	

RESERVED FOR VENDOR LOGO AND DRAWING NUMBER

LARSEN & TOUBRO DRAWING NUMBER: O19045_080_C_G_24197_021 | REVISION: 3

OUTOTEC DRAWING NUMBER: 900707 __GAU01 __AG22__MTL01 __39890 | DOCUMENT ID: OU100707471 | REVISION: 3

LARSEN & TOUBRO

This drawing is the property of LARSEN & TOUBRO and must not be passed on to any person or body not authorized by us to receive it nor be copied or otherwise made use either in full or in part by such person or body without our prior permission in writing.

Outotec

The content of these documents are the sole property of Outotec Oyj. Any rights not expressly granted herein are reserved. Reproduction, transfer or distribution of part or all of the contents in any form without prior written permission of Outotec is prohibited.

MA'ADEN معادن
Saudi Arabian Mining Company شركة التعدين العربية السعودية

This document and the information contained herein is Ma'aden proprietary know-how. This document or any part thereof should not be reproduced, stored in a retrieval system or transmitted by any means, electronic or otherwise, or divulged without prior written permission of Ma'aden.

DRAWN	AMT	25/02/2021	MANSOURAH - MASSARAH GOLD PROJECT
CHECKED	BDA	26/02/2021	GENERAL ARRANGEMENT DRAWING
ENGINEER	STY	25/02/2021	OXYGEN PLANT
APPROVED	AG	02/03/2021	DETAILS OF CABLE PULL PIT & PACKAGE UNIT
EMPLOYER			
SCALE	1:125, 1:50, 1:25	A1	DRAWING NUMBER: MD - 216 - 3980 - EG - CV - GAD - 1488 | REV: D01