


DRAWING NUMBER: MD-216-3980-EG-CV-GAD-1489 | REV: D01

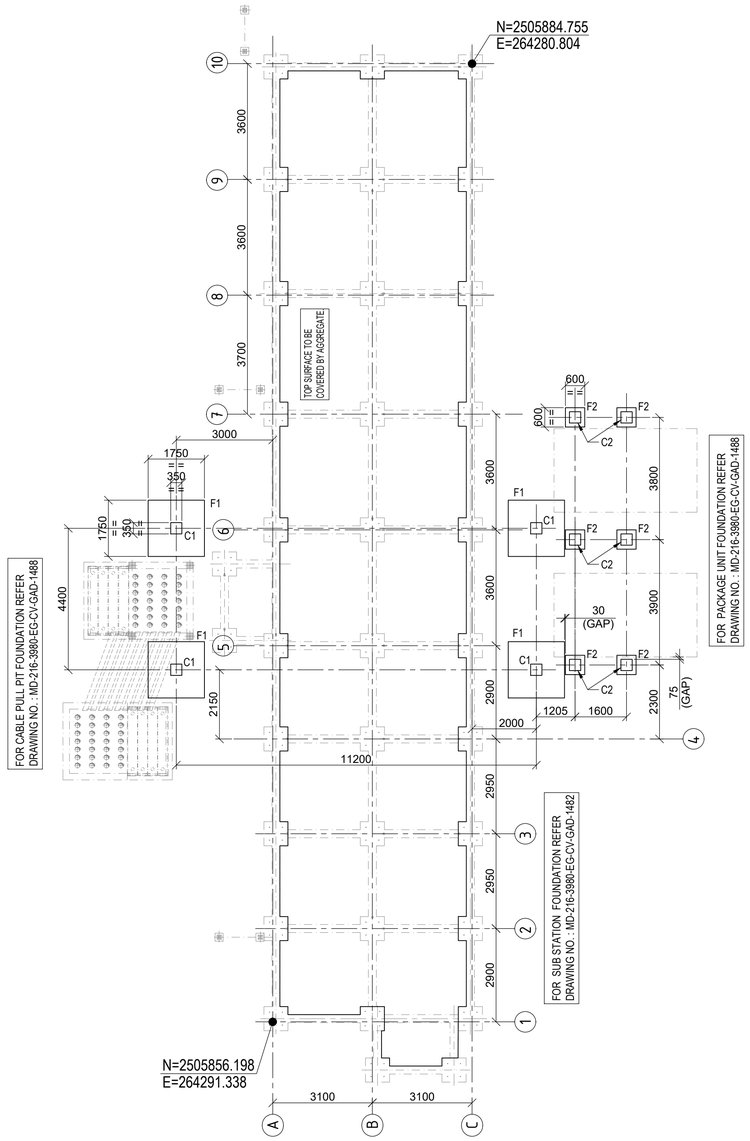


LAYOUT PLAN OF FOUNDATION & GRADE SLAB
(SCALE - 1:100)

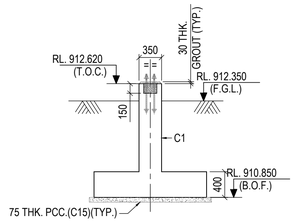


SECTION 1-1
(SCALE - 1:50)

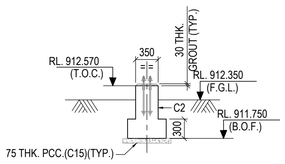


SECTION 2-2
(SCALE - 1:50)

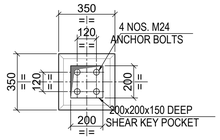


DETAIL OF COLUMN MKD. - C1
(SCALE 1:20)

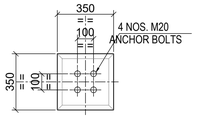


DETAIL OF COLUMN MKD. - C2
(SCALE 1:20)

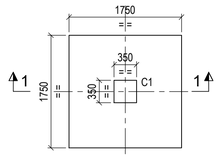


DETAIL OF FOUNDATION MKD. - F1
(SCALE - 1:50)

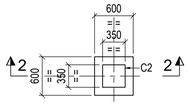


DETAIL OF FOUNDATION MKD. - F2
(SCALE - 1:50)

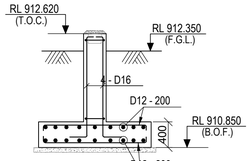


SECTION 1-1
(SCALE-1:50)

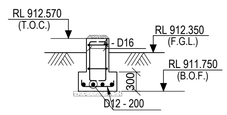


SECTION 2-2
(SCALE-1:50)

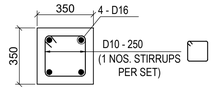

R.C DETAIL OF COLUMN MKD - C1 & C2
(SCALE 1:20)

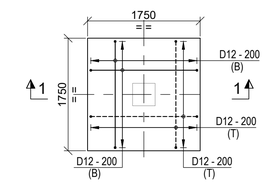

R.C DETAIL OF FOUNDATION MKD. - F1
(SCALE 1:50)

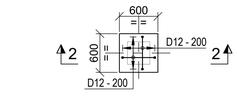

R.C DETAIL OF FOUNDATION MKD. - F2
(SCALE 1:50)

LEGEND :-

RL. - REDUCED LEVEL
F.G.L - FINISHED GROUND LEVEL
P.C.C - PLAIN CEMENT CONCRETE
T.O.C - TOP OF CONCRETE
B.O.F - BOTTOM OF FOUNDATION
THK. - THICK
TYP. - TYPICAL
DRG. - DRAWING
CL. - CENTRE LINE
MKD. - MARKED
BOTTOM REINFORCEMENT (B) -
TOP REINFORCEMENT (T) -
R.C - REINFORCED CONCRETE

NOTES:-

1. ALL DIMENSIONS ARE IN MILLIMETRES AND LEVELS ARE IN METRES UNLESS OTHERWISE STATED.
2. GRADE OF CONCRETE SHALL BE C35 .
3. GRADE OF REINFORCEMENT SHALL BE DEFORMED BAR 420 MPa (GRADE 60)
4. NET SAFE BEARING CAPACITY CONSIDERED AT THE FOUNDING LEVEL IS 460 KN/SQ. M
5. IF ANY PART OF FOUNDATION COMES ON BACKFILL ZONE OF ADJACENT FOUNDATION OR ANY LOOSE POCKETS ARE ENCOUNTERED BELOW FOUNDATION LEVEL THE SAME SHALL BE REMOVED AND FILLED WITH PCC.
6. CLEAR COVER TO MAIN REINFORCEMENT SHALL BE FOUNDATION = 50MM, PEDESTALS = 50 MM.

DOCUMENT NUMBER	REFERENCE DOCUMENTS	REV	DATE	REVISION DESCRIPTION	DRN	CHK	ENG	APP	EMP
		D01	22/02/2023	AS-BUILT	APM	BDA	STY	AG	
MD-216-3980-EG-CV-GAD-1482	SUB STATION FOUNDATION	C01	16/04/2021	ISSUED FOR CONSTRUCTION & REVISED AS PER	AMT	BDA	STY	AG	
MD-216-3980-EG-CV-GAD-1488	PULL PIT & PACKAGE UNIT FOUNDATION			EMPOLYER'S COMMENT ON 12/04/21 & AS MKD.					
MD-216-3980-EG-ST-GAD-2404	DUCT SUPPORTS- PLAN, ELEVATION & SECTION	A01	18/03/2021	ISSUED FOR REVIEW	AMT	BDA	STY	AG	

RESERVED FOR VENDOR LOGO AND DRAWING NUMBER

LARSEN & TOUBRO

This drawing is the property of LARSEN & TOUBRO and must not be passed on to any person or body not authorized by us to receive it nor be copied or otherwise made use either in full or in part by such person or body without our prior permission in writing.

Outotec

The content of these documents are the sole property of Outotec Oyj. Any rights not expressly granted herein are reserved. Reproduction, transfer or distribution of part or all of the contents in any form without prior written permission of Outotec is prohibited.

MA'ADEN معادن
Saudi Arabian Mining Company شركة التعدين العربية السعودية

This document and the information contained herein is Ma'aden proprietary know-how. This document or any part thereof should not be reproduced, stored in a retrieval system or transmitted by any means, electronic or otherwise, or divulged without prior written permission of Ma'aden.

LARSEN & TOUBRO DRAWING NUMBER: 019045_080_C_G_24197_022 | REVISION: 2
OUTOTEC DRAWING NUMBER: 900707__GAU01__AG22__MTL01__39891 | DOCUMENT ID: OU100707472 | REVISION: 2

DRAWN	AMT	15/03/2021
CHECKED	BDA	16/03/2021
ENGINEER	STY	15/03/2021
APPROVED	AG	18/03/2021
EMPLOYER		
SCALE	1:100, 1:50, 1:20	A1

MANSOURAH - MASSARAH GOLD PROJECT
GENERAL ARRANGEMENT DRAWING
OXYGEN PLANT
GRADE SLAB & DUCT SUPPORT FOUNDATION DETAILS

DRAWING NUMBER: MD-216-3980-EG-CV-GAD-1489 | REV: D01