

DRAWING NUMBER: MD-216-3980-EG-CV-GAD-1504
REV: D01

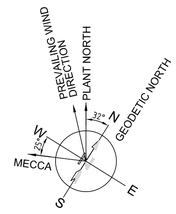

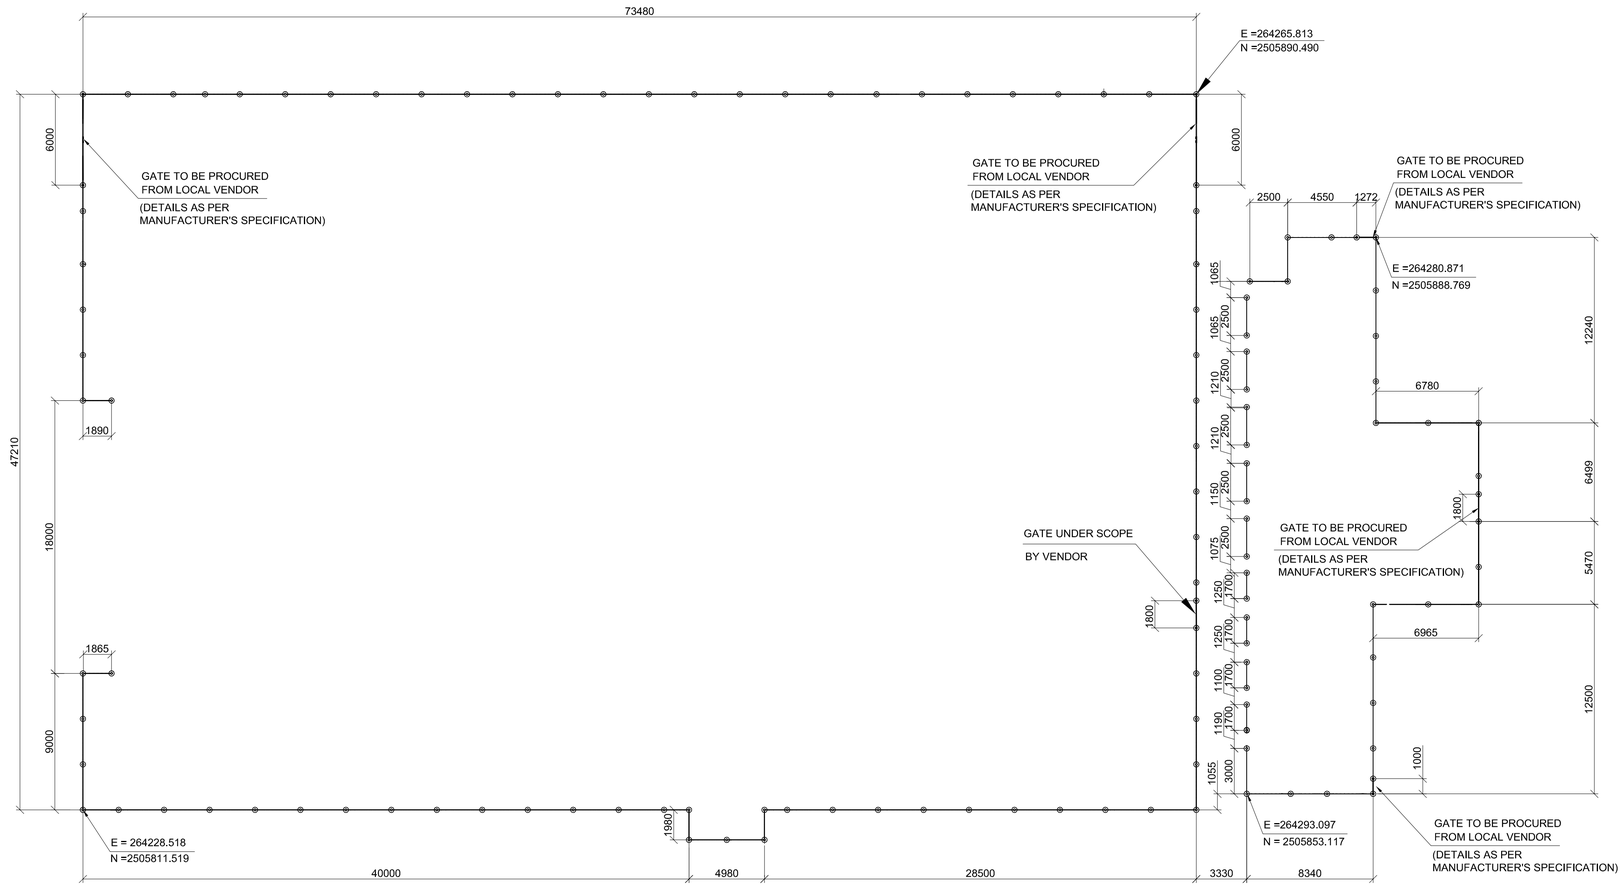

OXYGEN PLANT DEMARCATION FENCE

SCALE 1:200

NOTES :-

1. ALL DIMENSION ARE IN MILLMETRE UNLESS OTHERWISE NOTED.
2. ALL COORDINATES ARE IN METRE.
3. FOR OTHER NOTES REFER DRAWING NO. MD-216-1800-EG-CV-GAD-1535.
4. GATE POST AND FOUNDATION DETAILS SHALL BE AS PER GATE SUPPLIERS REQUIREMENT.

DOCUMENT NUMBER	REFERENCE DOCUMENTS	REV	DATE	REVISION DESCRIPTION	DRN	CHK	ENG	APP	EMP
		D01	22/02/2023	AS-BUILT	SUP	SJM	AVG	AG	
		C02	28/12/2021	ISSUED FOR CONSTRUCTION AND REVISED AS MARKED (C02)	SUP	SJM	AVG	AG	
MD-216-1800-EG-CV-GAD-1535	SECURITY SYSTEM-MINING BOUNDARY OVERALL PERIMETER FENCE,	C01	08/07/2021	ISSUED FOR CONSTRUCTION, REVISED AS PER EMPLOYER	SUP	SJM	AVG	AG	
	PLAN, SECTIONS & DETAILS			COMMENTS DATED 25/06/21 AS MARKED					
		A01	28/05/2021	ISSUED FOR APPROVAL	SUP	SJM	AVG	AG	

RESERVED FOR VENDOR LOGO AND DRAWING NUMBER

LARSEN & TOUBRO

This drawing is the property of LARSEN & TOUBRO and must not be passed on to any person or body not authorized by us to receive it nor be copied or otherwise made use either in full or in part by such person or body without our prior permission in writing.

Outotec

The content of these documents are the sole property of Outotec Oyj. Any rights not expressly granted herein are reserved. Reproduction, transfer or distribution of part or all of the contents in any form without prior written permission of Outotec is prohibited.

MA'ADEN معادن
Saudi Arabian Mining Company شركة التعدين العربية السعودية

This document and the information contained herein is Ma'aden proprietary know-how. This document or any part thereof should not be reproduced, stored in a retrieval system or transmitted by any means, electronic or otherwise, or divulged without prior written permission of Ma'aden.

LARSEN & TOUBRO DRAWING NUMBER: 019045_080_C_G_24684_001 — REVISION: 3
OUTOTEC DRAWING NUMBER: 900707__GAU01__AG22__MTL01__39897 — DOCUMENT ID: OU100724239 — REVISION: 3

DRAWN	SUP	19/05/2021
CHECKED	SJM	25/05/2021
ENGINEER	AVG	20/05/2021
APPROVED	AG	28/05/2021
EMPLOYER		
SCALE	1:200	A1

MANSOURAH - MASSARAH GOLD PROJECT
GENERAL ARRANGEMENT DRAWING
OXYGEN PLANT
DEMARCATION FENCE LAYOUT

DRAWING NUMBER: MD-216-3980-EG-CV-GAD-1504 — REV: D01