


DRAWING NUMBER MD-216-3840-EG-CV-DED-1426 REV D01

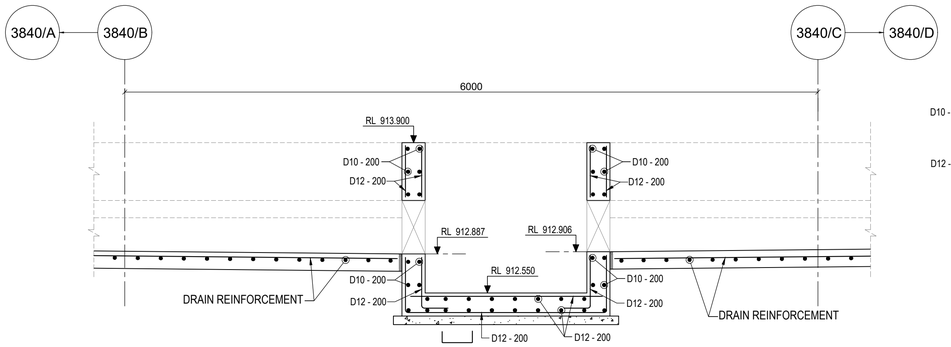


SECTION : A-A
SHOWING RC DETAIL
SCALE 1:25

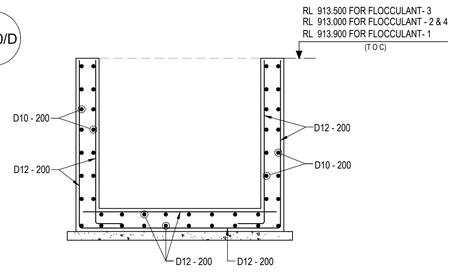


TYPICAL RC DETAIL OF PIT
SCALE 1:25

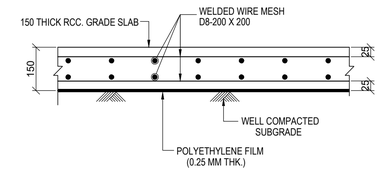


TYP. DETAIL OF 150 THICK HEAVY DUTY GRADE SLAB
FLOOR LOAD 15 KN / SQM. TO 50 KN / SQM.
SCALE 1:10

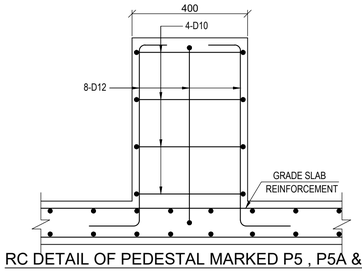


RC DETAIL OF PEDESTAL MARKED P5 , P5A & P9
SCALE 1:10

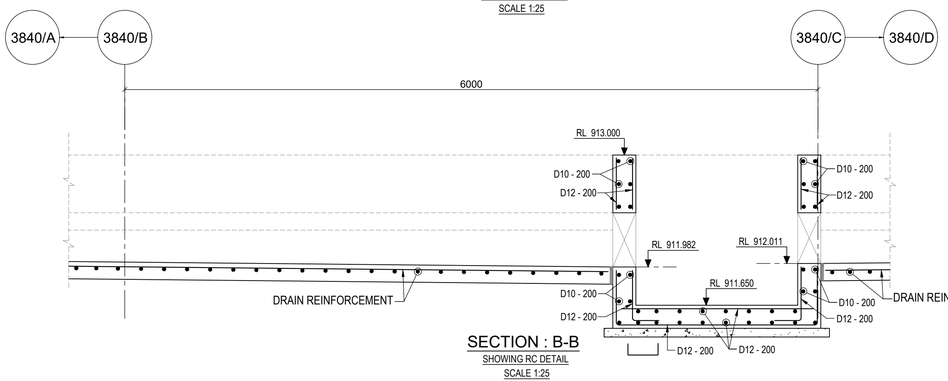


SECTION : B-B
SHOWING RC DETAIL
SCALE 1:25

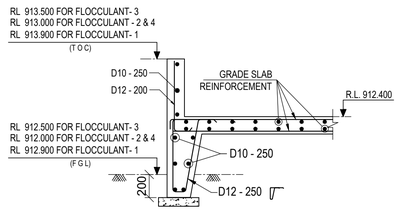

SECTION : A1-A1
SHOWING RC DETAIL
SCALE 1:25

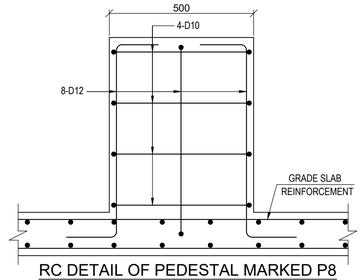


SCALE 1:10

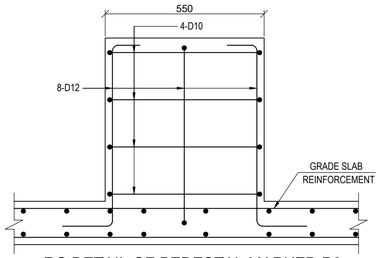


RC DETAIL OF PEDESTAL MARKED P6
SCALE 1:10


RC DETAIL OF PEDESTAL MARKED P8
SCALE 1:10

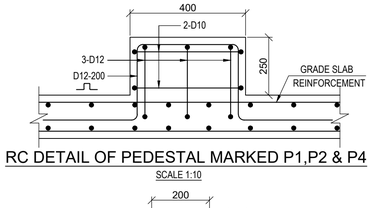


RC DETAIL OF PEDESTAL MARKED P1,P2 & P4
SCALE 1:10

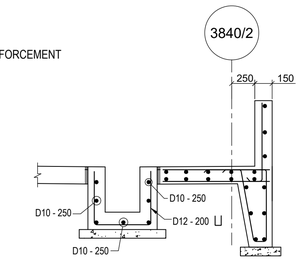


SECTION : A2-A2
SHOWING RC DETAIL OF DRAIN
SCALE 1:25

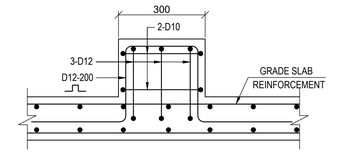


RC DETAIL OF PEDESTAL MARKED P10,P11&P12
SCALE 1:10

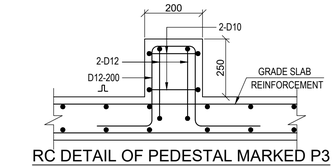


RC DETAIL OF PEDESTAL MARKED P3
SCALE 1:10

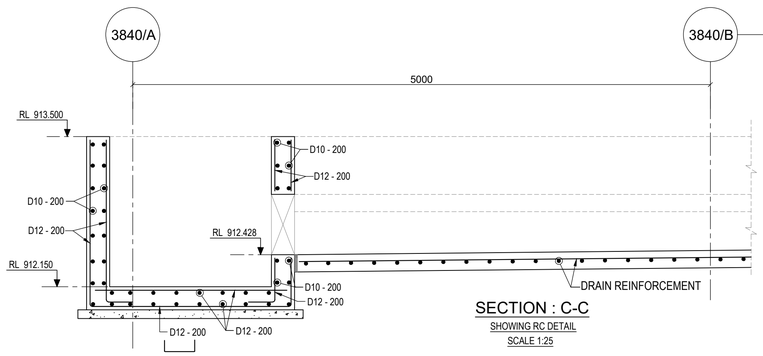

SECTION : C-C
SHOWING RC DETAIL
SCALE 1:25

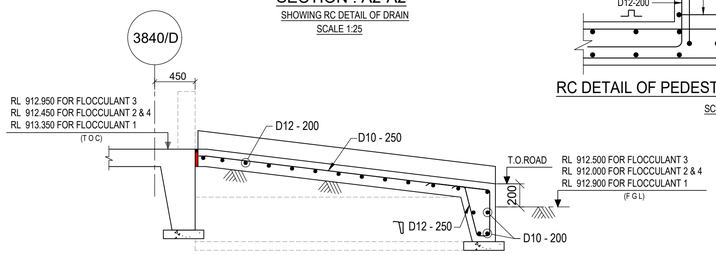

SECTION : A3-A3
TYPICAL RC DETAIL OF RAMP
SCALE 1:25

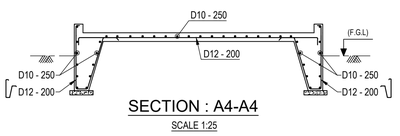

SECTION : A4-A4
SCALE 1:25

LEGENDS:-
R L - REDUCED LEVEL
T O C - TOP OF CONCRETE
F G L - FINISHED GROUND LEVEL
P C C - PLAIN CEMENT CONCRETE
R C C - REINFORCED CEMENT CONCRETE
RC - REINFORCED CONCRETE
TYP - TYPICAL
MKD. - MARKED
REF. - REFER
GA - GENERAL ARRANGEMENT
DWG. - DRAWING
℄ - CENTRE LINE
REINF. - REINFORCEMENT

NOTES:-
1. ALL DIMENSIONS ARE IN MILLIMETRES AND LEVELS ARE IN METRES UNLESS OTHERWISE STATED.
2. GRADE OF CONCRETE SHALL BE C35 UNLESS OTHERWISE NOTED.
3. GRADE OF REINFORCEMENT SHALL BE DEFORMED BAR ASTM A615 - GRADE 60 (fy=420 MPa)
4. CLEAR COVER TO REINFORCEMENT SHALL BE AS FOLLOWS:
   a) WALL : 50 mm. (FOR DOUBLE LAYER REINF.)
      75 mm. (FOR SINGLE LAYER REINF.)
   b) SLAB : 50 mm.
   c) PEDESTAL : 50 mm.
5. FOR GA DRAWING REF. DWG. NO. MD-216-3840-EG-CV-GAD-1424.
6. FOR SPLICE LENGTHS OF REINF. REF. DWG. NO. MD-261-1000-EG-CV-DED-1001. - CLAUSE NO. 5.3 & 5.4
7. FOR GENERAL NOTE FOR CIVIL WORK REF. DWG. NO : MD-216-1000-EG-CV-DED-1001.
8. FOR STANDERD REINF. DETAIL REF. DWG. NO : MD-216-1000-EG-CV-DED-1005.
9. REINFORCEMENT MAY BE SLIGHTLY ADJUSTED AT SITE TO ACCOMMODATE EMBEDDED PART.

DOCUMENT NUMBER	REFERENCE DOCUMENTS	REV	DATE	REVISION DESCRIPTION	DRN	CHK	ENG	APP	EMP
		D01	16/03/2023	AS-BUILT	AMT	BDA	SML	AG	
		C04	22/01/2021	ISSUED FOR CONSTRUCTION & REVISED AS MKD. C04	AMT	BDA	SML	AG	
MD-216-3840-EG-AR-GAD-3068	BUILDING PLAN, ELEVATIONS & SECTIONS	C03	11/11/2020	ISSUED FOR CONSTRUCTION & REVISED AS MKD. C03	AMT	BDA	SML	AG	
MD-216-3840-EG-ST-GAD-1002	3840 FLOCCULANT : PLAN VIEW	C02	01/10/2020	ISSUED FOR CONSTRUCTION & REVISED AS MKD. C02	AMT	BDA	SML	AG	
MD-216-3840-EG-ST-GAD-1001	3840 FLOCCULANT : 3D VIEW	C01	28/07/2020	ISSUED FOR CONSTRUCTION	AMT	BDA	SML	AG	
MD-216-3840-EG-CV-GAD-1001	3840 FLOCCULANT : PLAN VIEW	A01	30/06/2020	ISSUED FOR REFERENCE	AMT	BDA	SML	AG	

RESERVED FOR VENDOR LOGO AND DRAWING NUMBER

LARSEN & TOUBRO

This drawing is the property of LARSEN & TOUBRO and must not be passed on to any person or body not authorized by us to receive it nor be copied or otherwise made use either in full or in part by such person or body without our prior permission in writing.

Outotec

The content of these documents are the sole property of Outotec Oyj. Any rights not expressly granted herein are reserved. Reproduction, transfer or distribution of part or all of the contents in any form without prior written permission of Outotec is prohibited.

MA'ADEN معادن
Saudi Arabian Mining Company شركة فتحين العربية السعودية

This document and the information contained herein is Ma'aden proprietary know-how. This document or any part thereof should not be reproduced, stored in a retrieval system or transmitted by any means, electronic or otherwise, or divulged without prior written permission of Ma'aden.

LARSEN & TOUBRO DRAWING NUMBER: 019045_450_C_D_24162_002 — REVISION: 5
OUTOTEC DRAWING NUMBER: 900707__GAU01__AA02__CTB17__38412 — DOCUMENT ID: OU100688489 — REVISION: 5

DRAWN	AMT	24/06/2020
CHECKED	BDA	26/06/2020
ENGINEER	SML	24/06/2020
APPROVED	AG	30/06/2020
EMPLOYER		
SCALE	1:30	A1

MANSOURAH - MASSARAH GOLD PROJECT
DETAIL DRAWING
FLOCCULANT
RC DETAILS

DRAWING NUMBER: MD-216-3840-EG-CV-DED-1426 — REV: D01