

DRAWING NUMBER: MD-216-3840-EG-CV-GAD-1423 | REV: D01

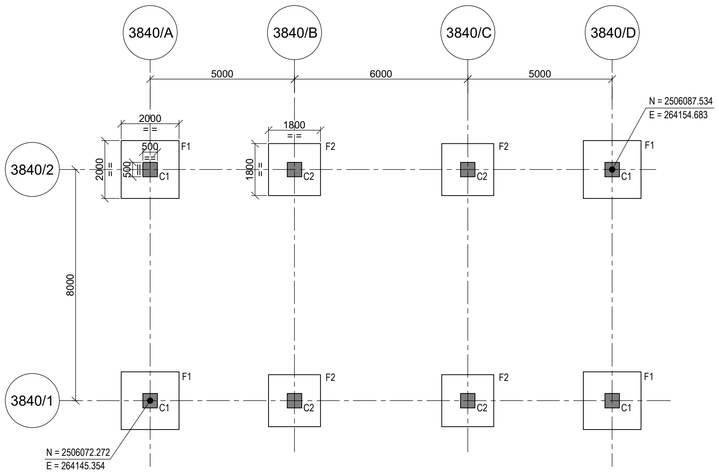


LAYOUT OF FOUNDATION FOR FLOCCULANT 1 - ACIDULATION

SCALE 1:100

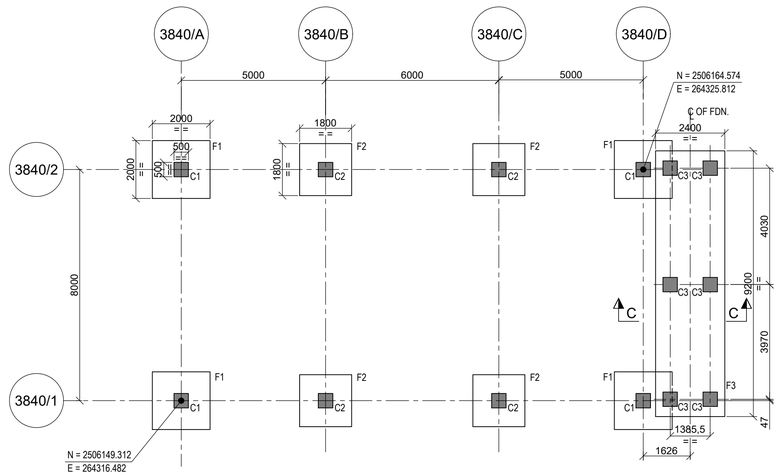


LAYOUT OF FOUNDATION FOR FLOCCULANT 2 - FLOTATION

SCALE 1:100

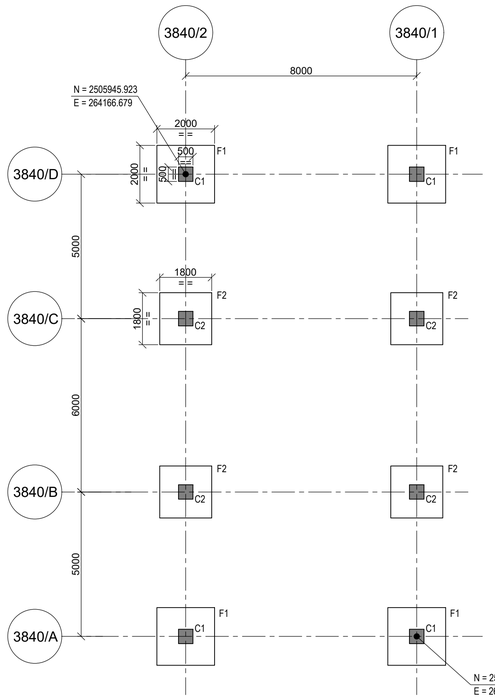


LAYOUT OF FOUNDATION FOR FLOCCULANT 3 - CCD

SCALE 1:100

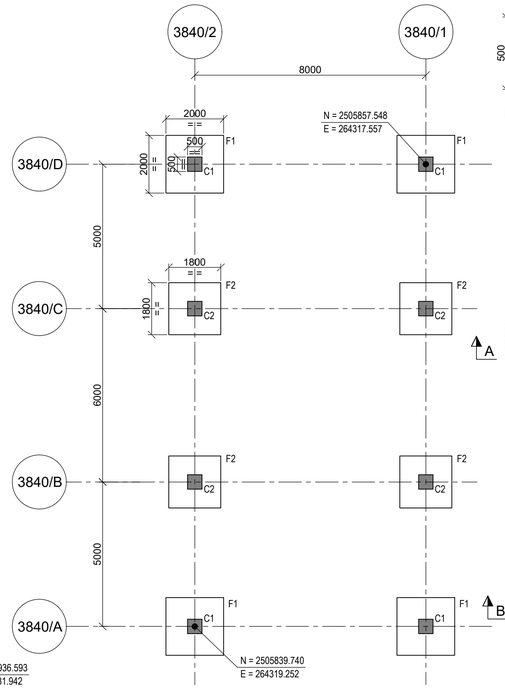


LAYOUT OF FOUNDATION FOR FLOCCULANT 4 - TAILINGS PASTE

SCALE 1:100

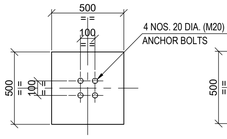


DETAIL OF COLUMN MARKED C1 & C2

SCALE 1:20

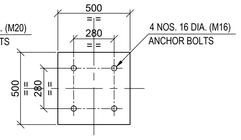


DETAIL OF COLUMN MARKED C3

SCALE 1:20

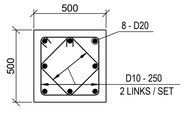


RC. DETAIL OF C3

SCALE 1:20

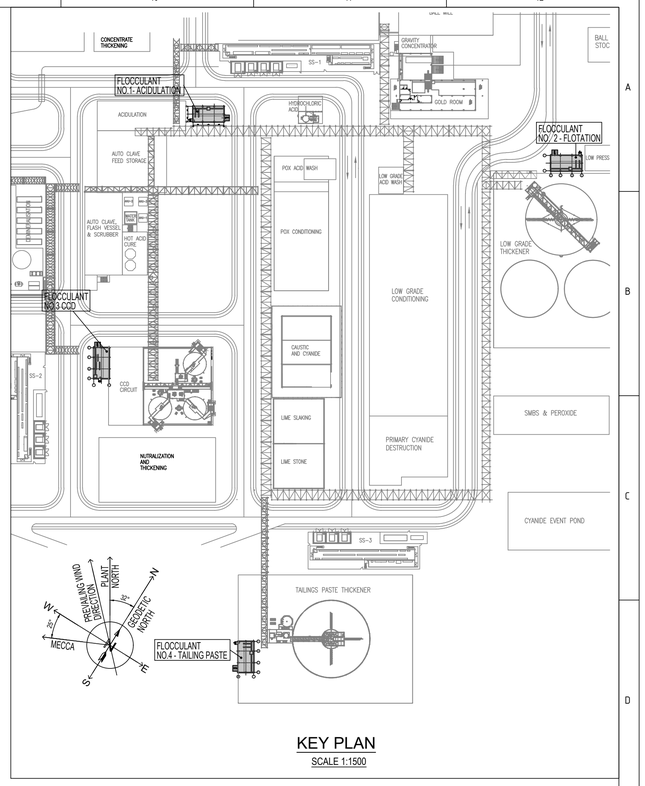

KEY PLAN


SCALE 1:1500

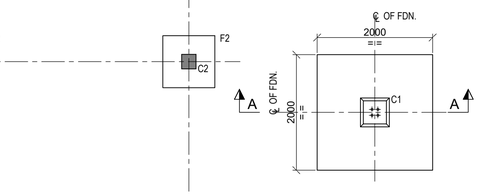

PLAN OF FOUNDATION MKD. F1

(16 NOS. REQD.)

SCALE 1:50

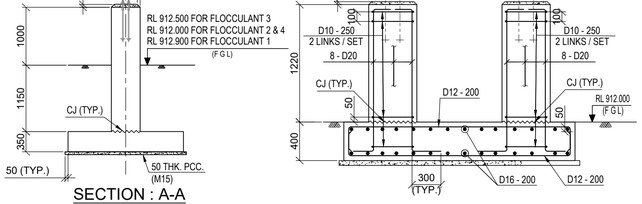


SECTION : A-A

SCALE 1:50

SECTION : C-C

(R.C DETAIL OF FDN. MKD. F3)


SCALE 1:30

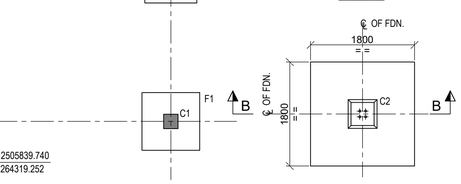

PLAN OF FOUNDATION MKD. F2


(16 NOS. REQD.)

SCALE 1:50

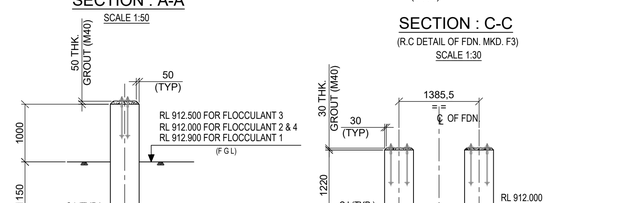

SECTION : B-B

SCALE 1:50

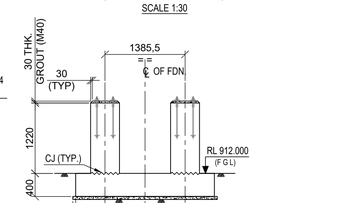

SECTION : C-C

SCALE 1:50

LEGENDS:-

RL - REDUCED LEVEL
T O C - TOP OF CONCRETE
F G L - FINISHED GROUND LEVEL
P C C - PLAIN CEMENT CONCRETE
TYP - TYPICAL
CJ - CONSTRUCTION JOINT
MKD - MARKED
THK - THICK
REF. - REFER
GA - GENERAL ARRANGEMENT
DWG. - DRAWING
℄ - CENTRE LINE
T O G - TOP OF GROUT
DIA - DIAMETER
REQD. - REQUIRED

NOTES :-

1. ALL DIMENSIONS ARE IN MILLIMETRES AND LEVELS AND CO-ORDINATES ARE IN METRES. UNLESS OTHERWISE STATED.
2. GRADE OF CONCRETE SHALL BE C35.
3. GRADE OF REINFORCEMENT SHALL BE DEFORMED BAR ASTM A615 - GRADE 60 (fy = 420 MPa).
4. NET SAFE BEARING CAPACITY CONSIDERED AT FOUNDING LEVEL IS 400 KN/SQ.M.
5. IF ANY PART OF FOUNDATION COMES ON BACKFILL ZONE OF ADJACENT FOUNDATION OR ANY LOOSE POCKETS ARE ENCOUNTERED BELOW FOUNDATION LEVEL THE SAME SHALL BE REMOVED AND FILLED WITH PCC.
6. FOR FOUNDATION BOLT DETAILS REFER. DWG. NO : MD-216-3840-EG-ST-GAD-2352.
7. FOR REINFORCEMENT DETAIL REFER DWG. NO : MD-216-3840-EG-CV-DED-1425.
8. GENERAL NOTE FOR CIVIL WORK REFER DWG. NO : MD-216-1000-EG-CV-DED-1001.
9. FOR EMBEDDED CONDUIT AND ELECTRICAL INSERT, REFER CABLE ROUTING LAYOUT DRAWING.

DOCUMENT NUMBER	REFERENCE DOCUMENTS	REV	DATE	REVISION DESCRIPTION	DRN	CHK	ENG	APP	EMP
		D01	16/03/2023	AS-BUILT	SYA	SJM	AVG	AG	
		C04	18/09/2021	ISSUED FOR CONSTRUCTION & REVISED AS MKD. C01	SYA	SJM	AVG	AG	
MD-216-3840-EG-ST-GAD-2352	ANCHOR BOLT PLAN & REACTIONS	C03	16/10/2020	ISSUED FOR CONSTRUCTION & REVISED AS MKD. C03	AMT	BDA	SML	AG	
MD-216-3840-EG-ST-GAD-1002	3840 FLOCCULANT : PLAN VIEW	C02	01/10/2020	ISSUED FOR CONSTRUCTION & REVISED AS MKD. C02	AMT	BDA	SML	AG	
MD-216-3840-EG-ST-GAD-1001	3840 FLOCCULANT : 3D VIEW	C01	28/07/2020	ISSUED FOR CONSTRUCTION & REVISED AS MKD. C01	AMT	BDA	SML	AG	
MD-216-3840-EG-CV-GAD-1001	3840 FLOCCULANT : PLAN VIEW	A01	30/06/2020	ISSUED FOR REFERENCE	AMT	BDA	SML	AG	

RESERVED FOR VENDOR LOGO AND DRAWING NUMBER

LARSEN & TOUBRO

This drawing is the property of LARSEN & TOUBRO and must not be passed on to any person or body not authorized by us to receive it nor be copied or otherwise made use either in full or in part by such person or body without our prior permission in writing.

Outotec

The content of these documents are the sole property of Outotec Oyj. Any rights not expressly granted herein are reserved. Reproduction, transfer or distribution of part or all of the contents in any form without prior written permission of Outotec is prohibited.

MA'ADEN معادن
Saudi Arabian Mining Company شركة معادن العربية السعودية

This document and the information contained herein is Ma'aden proprietary know-how. This document or any part thereof should not be reproduced, stored in a retrieval system or transmitted by any means, electronic or otherwise, or divulged without prior written permission of Ma'aden.

DRAWN	AMT	24/06/2020	
CHECKED	BDA	26/06/2020	
ENGINEER	SML	24/06/2020	
APPROVED	AG	30/06/2020	
EMPLOYER			
SCALE	1:30	A1	

LARSEN & TOUBRO DRAWING NUMBER: 019045_450_C_G_24161_001 | REVISION: 5

OUTOTEC DRAWING NUMBER: 900707__GAU01__AA02__MTL01__38409 | DOCUMENT ID: OU100688486 | REVISION: 5

MANSOURAH - MASSARAH GOLD PROJECT
GENERAL ARRANGEMENT
FLOCCULANT
PLAN & SECTIONS

DRAWING NUMBER: MD-216-3840-EG-CV-GAD-1423 | REV: D01