

DRAWING NUMBER: MD-216-3840-EG-CV-GAD-1424 REV D01

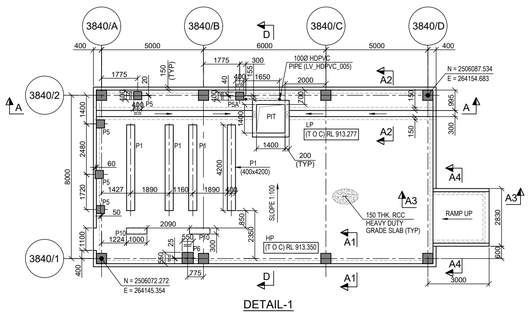

DETAIL-1

FLOCCULANT 1 - ACIDULATION


SCALE 1:100

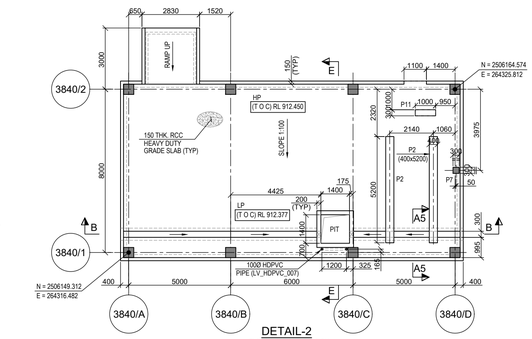

DETAIL-2

FLOCCULANT 2 - FLOTATION


SCALE 1:100

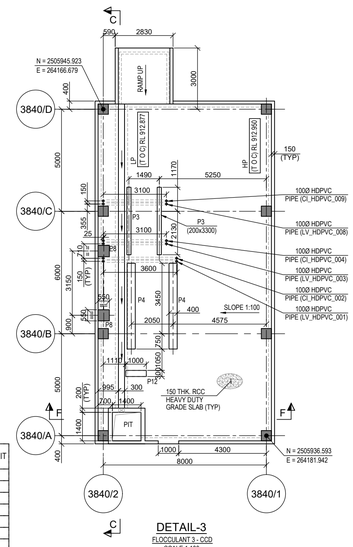

DETAIL-3

FLOCCULANT 3 - CCD


SCALE 1:100

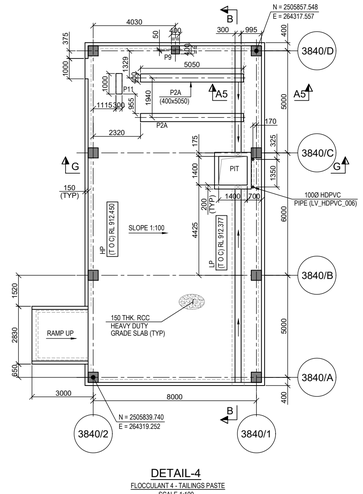

DETAIL-4


FLOCCULANT 4 - TAILINGS PASTE

SCALE 1:100

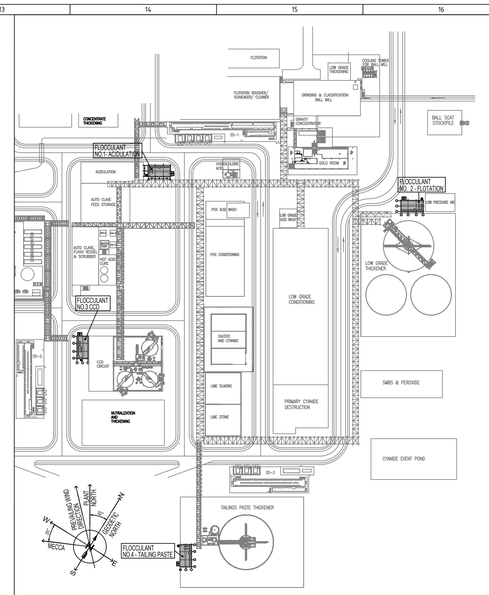

KEY PLAN

SCALE 1:1500

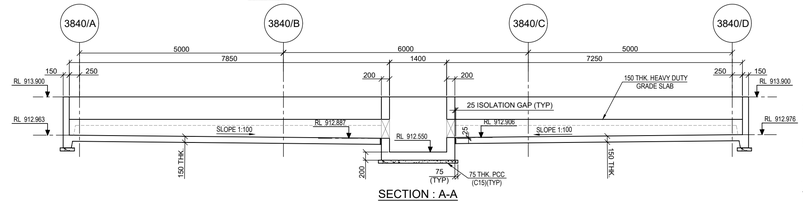

SECTION : A-A

SCALE 1:50




TYPICAL DETAIL OF CONDUIT

SCALE 1:50


SCHEDULE OF CONDUIT ℄ :-

CONDUIT MKD.	℄ OF CONDUIT
LV_HDPVC_001	RL 912.050
CI_HDPVC_002	RL 912.050
LV_HDPVC_003	RL 912.050
CI_HDPVC_004	RL 912.050
LV_HDPVC_005	RL 912.660
LV_HDPVC_006	RL 911.750
LV_HDPVC_007	RL 911.650
LV_HDPVC_008	RL 912.050
CI_HDPVC_009	RL 912.050

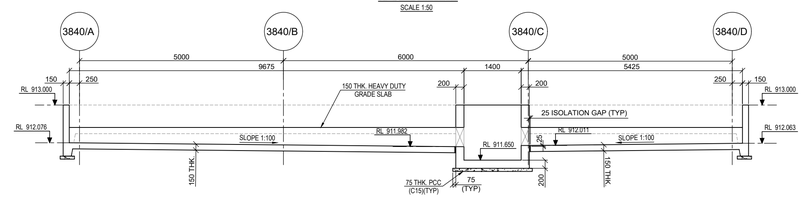


SECTION : B-B

SCALE 1:50

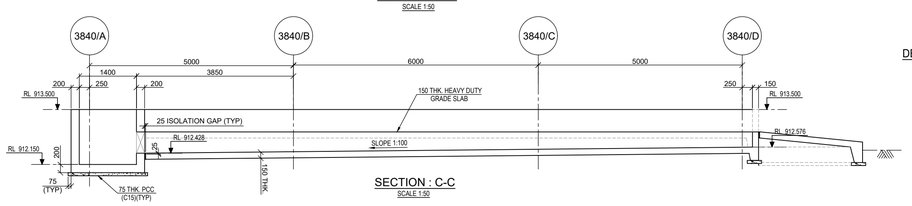


SECTION : C-C

SCALE 1:50

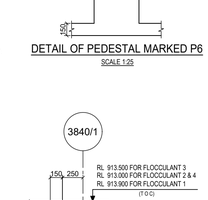

SECTION : A1-A1


SCALE 1:25

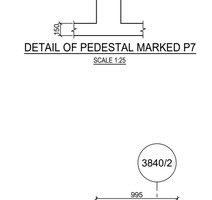

SECTION : A2-A2

TYPICAL DETAIL OF DRAIN

SCALE 1:25

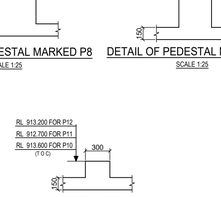

SECTION : A5-A5

SCALE 1:25


SECTION : A4-A4

SCALE 1:25

SECTION : A3-A3


TYPICAL DETAIL OF RAMP

SCALE 1:25

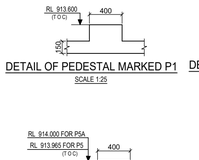

SECTION : D-D

SCALE 1:50

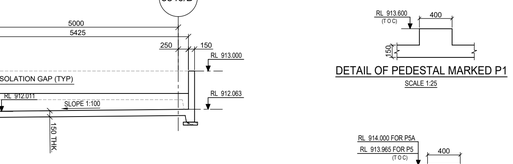


SECTION : E-E

SCALE 1:50

SECTION : F-F

SCALE 1:50

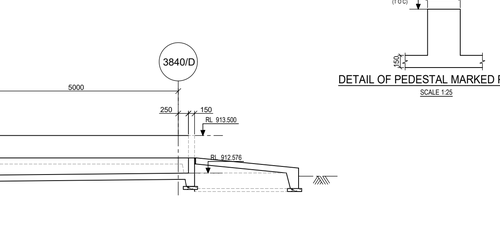


SECTION : G-G

SCALE 1:50


DETAIL OF PEDESTAL MARKED P1

SCALE 1:25

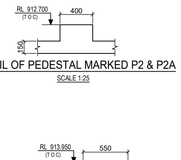


DETAIL OF PEDESTAL MARKED P2 & P2A

SCALE 1:25

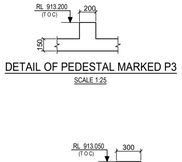


DETAIL OF PEDESTAL MARKED P3

SCALE 1:25

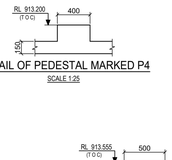


DETAIL OF PEDESTAL MARKED P4

SCALE 1:25

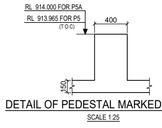


DETAIL OF PEDESTAL MARKED P5 & 5A

SCALE 1:25

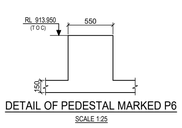


DETAIL OF PEDESTAL MARKED P6

SCALE 1:25

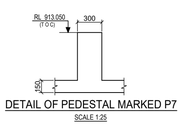


DETAIL OF PEDESTAL MARKED P7

SCALE 1:25

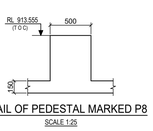


DETAIL OF PEDESTAL MARKED P8

SCALE 1:25

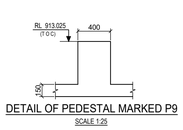


DETAIL OF PEDESTAL MARKED P9

SCALE 1:25

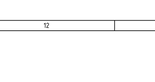

DETAIL OF PEDESTAL MARKED P10,P11 & P12

SCALE 1:25

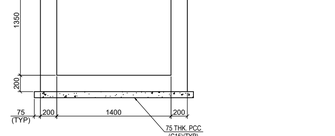

TYPICAL DETAIL OF PIT

SCALE 1:25

TYP. DETAIL OF 150 THK. HEAVY DUTY GRADE SLAB

SCALE 1:20

LEGENDS:-

R L - REDUCED LEVEL
T O C - TOP OF CONCRETE
B O C - BOTTOM OF CONCRETE
THK. - THICK
TYP - TYPICAL
F G L - FINISHED GROUND LEVEL
P C C - PLAIN CEMENT CONCRETE
R C C - REINFORCED CEMENT CONCRETE
HP - HIGH POINT
LP - LOW POINT
MKD. - MARKED
DWG. - DRAWING
T.O.ROAD - TOP OF ROAD
℄ - CENTER LINE

NOTES:-

1. ALL DIMENSIONS ARE IN MILLIMETRES AND LEVELS ARE IN METRES UNLESS OTHERWISE STATED.
2. GRADE OF CONCRETE SHALL BE C35
3. GRADE OF REINFORCEMENT SHALL BE DEFORMED BAR ASTM A615-GRADE 60 (fy=420 MPa)
4. NET SAFE BEARING CAPACITY CONSIDERED AT THE FOUNDING LEVEL IS 400 KN/SQ. M.
5. IF ANY PART OF FOUNDATION COMES ON BACKFILL ZONE OF ADJACENT FOUNDATION OR ANY LOOSE POCKETS ARE ENCOUNTERED BELOW FOUNDATION LEVEL THE SAME SHALL BE REMOVED AND FILLED WITH PCC.
6. FOR DETAILS OF GRADE SLAB REFER DWG. NO. MD-216-1000-EG-CV-DED-1002.
7. FOR REINFORCEMENT DETAIL REFER DWG. NO : MD-216-3840-EG-CV-DED-1426.
8. GENERAL NOTE FOR CIVIL WORK REFER DWG. NO : MD-216-1000-EG-CV-DED-1001.
9. FOR EMBEDDED CONDUIT AND ELECTRICAL INSERT, REFER CABLE ROUTING LAYOUT DRAWING.
10. FOR ELECTRICAL CONDUIT DETAIL REFER DWG. NO : MD-216-3840-EG-EL-LAD-1011. MD-216-3840-EG-EL-LAD-1012. MD-216-3840-EG-EL-LAD-1013. MD-216-3840-EG-EL-LAD-1014.

DOCUMENT NUMBER	REFERENCE DOCUMENTS	REV	DATE	REVISION DESCRIPTION	DRN	CHK	ENG	APP	EMP
		D01	16/03/2023	AS-BUILT	AMT	BDA	SML	AG	
		C07	10/03/2021	ISSUED FOR CONSTRUCTION & REVISED AS MKD. (7)	AMT	BDA	SML	AG	
		C06	21/01/2021	ISSUED FOR CONSTRUCTION & REVISED AS MKD. (6)	AMT	BDA	SML	AG	
		C05	09/01/2021	ISSUED FOR CONSTRUCTION & REVISED AS MKD. (5)	AMT	BDA	SML	AG	
MD-216-3840-EG-ST-GAD-2352	ANCHOR BOLT PLAN & REACTIONS	C04	11/11/2020	ISSUED FOR CONSTRUCTION & REVISED AS MKD. (4)	AMT	BDA	SML	AG	
MD-216-3840-EG-AR-GAD-3068	BUILDING PLAN, ELEVATIONS & SECTIONS	C03	16/10/2020	ISSUED FOR CONSTRUCTION & REVISED AS MKD. (3)	AMT	BDA	SML	AG	
MD-216-3840-EG-ST-GAD-1002	3840 FLOCCULANT : PLAN VIEW	C02	01/10/2020	ISSUED FOR CONSTRUCTION & REVISED AS MKD. (2)	AMT	BDA	SML	AG	
MD-216-3840-EG-ST-GAD-1001	3840 FLOCCULANT : 3D VIEW	C01	28/07/2020	ISSUED FOR CONSTRUCTION & REVISED AS MKD. (1)	AMT	BDA	SML	AG	
MD-216-3840-EG-CV-GAD-1001	3840 FLOCCULANT : PLAN VIEW	A01	30/06/2020	ISSUED FOR REFERENCE	AMT	BDA	SML	AG	

RESERVED FOR VENDOR LOGO AND DRAWING NUMBER

LARSEN & TOUBRO

This drawing is the property of LARSEN & TOUBRO and must not be passed on to any person or body not authorized by us to receive it nor be copied or otherwise made use either in full or in part by such person or body without our prior permission in writing.

Outotec

The content of these documents are the sole property of Outotec Oyj. Any rights not expressly granted herein are reserved. Reproduction, transfer or distribution of part or all of the contents in any form without prior written permission of Outotec is prohibited.

MA'ADEN معادن Saudi Arabian Mining Company

This document and the information contained herein is Ma'aden proprietary know-how. This document or any part thereof should not be reproduced, stored in a retrieval system or transmitted by any means, electronic or otherwise, or divulged without prior written permission of Ma'aden.

LARSEN & TOUBRO DRAWING NUMBER	019045_450_C_G_24161_002
REVISION	8
OUTOTEC DRAWING NUMBER	900707__GAU01__AA02_MTL01__38410
DOCUMENT ID	OU100688487
REVISION	8
DRAWN	AMT 24/06/2020
CHECKED	BDA 26/06/2020
ENGINEER	SML 24/06/2020
APPROVED	AG 30/06/2020
EMPLOYER	
SCALE	1:100 A0

MANSOURAH - MASSARAH GOLD PROJECT

GENERAL ARRANGEMENT

FLOCCULANT

PLAN & SECTIONS

DRAWING NUMBER: MD - 216 - 3840 - EG - CV - GAD - 1424

REV: D01