


DRAWING NUMBER: MD-216-3850-EG-CV-DED-1429 | REV: D01

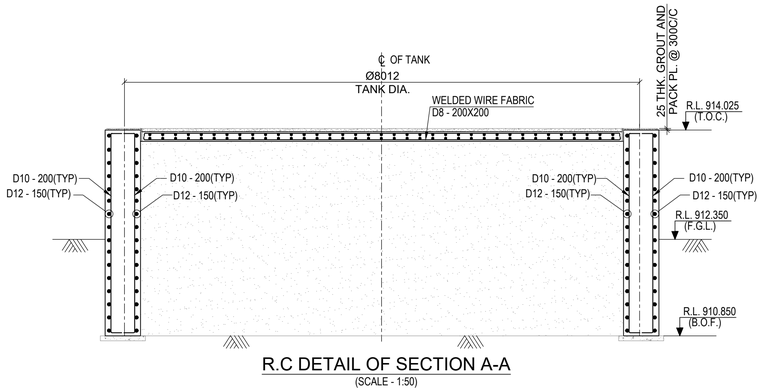


R.C DETAIL OF SECTION A-A
(SCALE - 1:50)

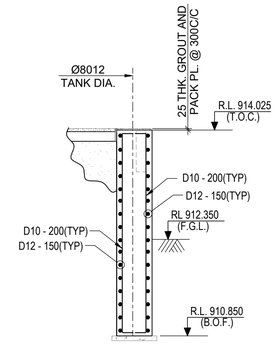

R.C DETAIL OF SECTION B-B
(SCALE - 1:50)

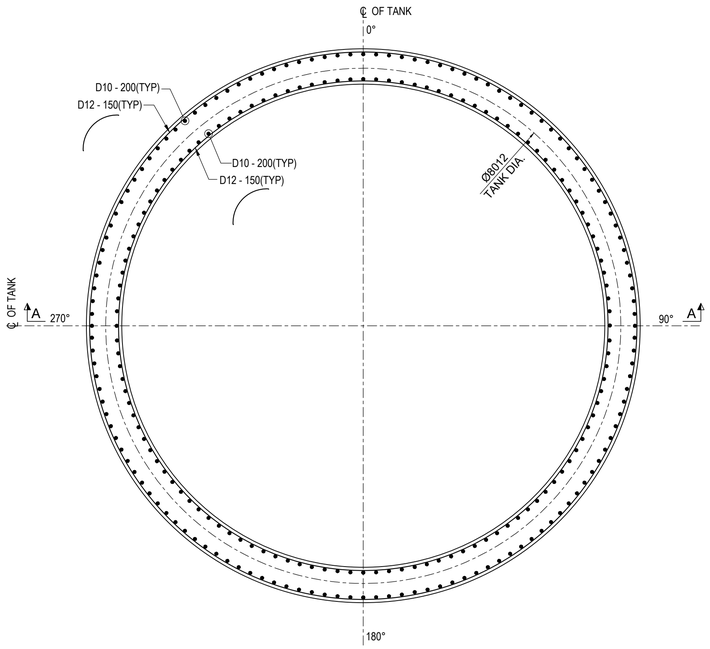

PLAN AT BOTTOM OF FOUNDATION
(SCALE - 1:50)

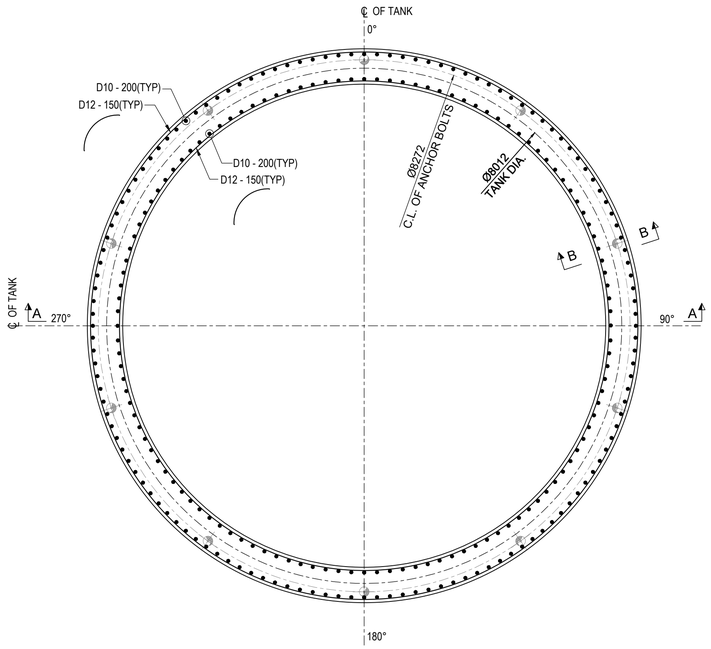

PLAN AT BOTTOM OF FOUNDATION
(SCALE - 1:50)

LEGEND.:-

R.L. - REDUCED LEVEL
T.O.C - TOP OF CONCRETE
B.O.F - BOTTOM OF FOUNDATION
F.G.L - FINISHED GROUND LEVEL
P.C.C - PLAIN CEMENT CONCRETE
TYP - TYPICAL
MKD - MARKED
C.L. - CENTRE LINE
R.C.C. - REINFORCED CONCRETE
REINF. - REINFORCEMENT
DIA. - DIAMETER
THK. - THICKNESS
PL. - PLATE

NOTES:-

1. ALL DIMENSIONS ARE IN MILLIMETRES AND LEVELS ARE IN METRES UNLESS OTHERWISE STATED.
2. GRADE OF CONCRETE SHALL BE C35 UNLESS OTHERWISE NOTED.
3. GRADE OF REINFORCEMENT SHALL BE DEFORMED BAR ASTM A615 - GRADE 60 (fy=420 MPa)
4. CLEAR COVER TO MAIN REINFORCEMENT SHALL BE AS FOLLOWS:
   a) RING WALL : 50 mm.
   b) SLAB : 25 mm.
5. FOR GA DRAWING REFER DRG. NO. : MD-216-3850-EG-CV-GAD-1428.
6. FOR SPLICE LENGTHS OF REINF. REFER. DWG. NO. MD-261-1000-EG-CV-DED-1001. - CL. NO. 5.3 & 5.4
7. GENERAL NOTE FOR CIVIL WORK REFER DRG. NO : MD-216-1000-EG-CV-DED-1001.
8. FOR STANDARD REINF. DETAIL REFER DRG. NO : MD-216-1000-EG-CV-DED-1005.
9. REINFORCEMENT MAY BE SLIGHTLY ADJUSTED AT SITE TO ACCOMMODATE EMBEDDED PART.

DOCUMENT NUMBER	REFERENCE DOCUMENTS	REV	DATE	REVISION DESCRIPTION	DRN	CHK	ENG	APP	EMP
MD-216-3850-EG-ME-GAD-1004	PLAN AT EL (+) 912.350	D01	22/02/2023	AS-BUILT	SBH	BDA	SUE	AG	
MD-216-3850-EG-CV-GAD-1001	PLAN AT EL (+)912.350 SECTION	C01	21/07/2020	ISSUED FOR CONSTRUCTION	SBH	BDA	SUE	AG	
MD-216-3850-EG-ME-PLN-1001	3850-REA-001-MILK OF LIME DOSING TANK	A01	25/06/2020	ISSUED FOR REFERENCE	SBH	BDA	SUE	AG	

RESERVED FOR VENDOR LOGO AND DRAWING NUMBER

LARSEN & TOUBRO DRAWING NUMBER: 019045_450_C_D_24165_001 | REVISION: 2
OUTOTEC DRAWING NUMBER: 900707__GAU01__AA03__CTB17__38501 | DOCUMENT ID: OU100688400 | REVISION: 2

LARSEN & TOUBRO
This drawing is the property of LARSEN & TOUBRO and must not be passed on to any person or body not authorized by us to receive it nor be copied or otherwise made use either in full or in part by such person or body without our prior permission in writing.

Outotec
The content of these documents are the sole property of Outotec Oyj. Any rights not expressly granted herein are reserved. Reproduction, transfer or distribution of part or all of the contents in any form without prior written permission of Outotec is prohibited.

MA'ADEN معادن
Saudi Arabian Mining Company شركة التعدين العربية السعودية
This document and the information contained herein is Ma'aden proprietary know-how. This document or any part thereof should not be reproduced, stored in a retrieval system or transmitted by any means, electronic or otherwise, or divulged without prior written permission of Ma'aden.

DRAWN	SBH	23/06/2020	MANSOURAH - MASSARAH GOLD PROJECT
CHECKED	BDA	24/06/2020	DETAIL DRAWING
ENGINEER	SUE	23/06/2020	REAGENTS - LIME SLAKING EQUIPMENT
APPROVED	AG	25/06/2020	MILK OF LIME DOSING TANK FOUNDATION RC DETAIL
EMPLOYER			
SCALE	1:100, 1:50	A1	DRAWING NUMBER: MD-216-3850-EG-CV-DED-1429 | REV: D01