


DRAWING NUMBER: MD - 216 - 3850 - EG - CV - GAD - 1428
REV: D01

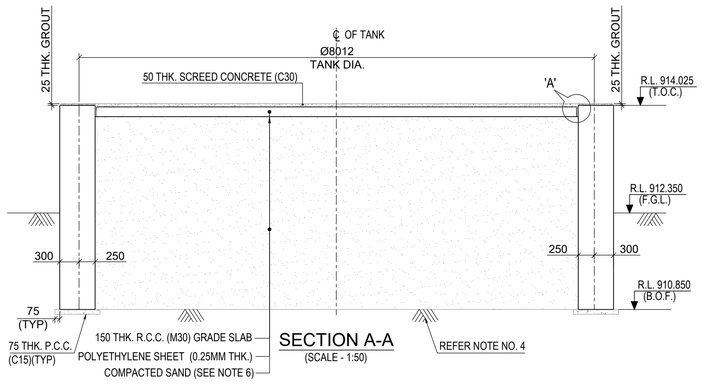


SECTION A-A
(SCALE - 1:50)

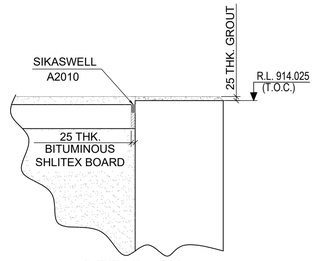

DETAIL - 'A'
(SCALE 1:20)

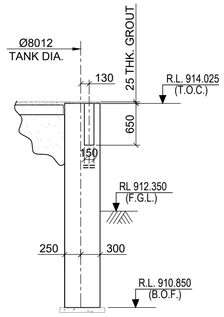


SECTION B-B
(SCALE - 1:50)

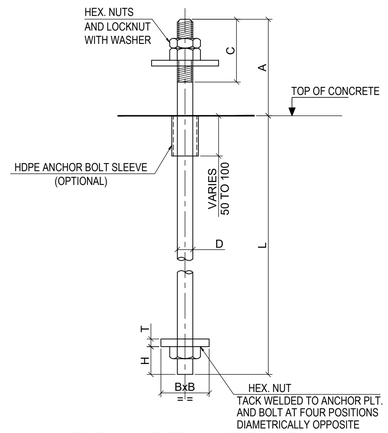


TYPICAL DETAIL OF BOLT
(SCALE - 1:50)


SCHEDULE OF BOLTS							
D BOLT DIA. MM	NO. OF BOLTS	BxB BOTTOM PLATE (SQUARE) SQ MM	DIMENSIONS (MM)				
			L	A	C	T	H
24	10	75x75	600	370	85	12	30

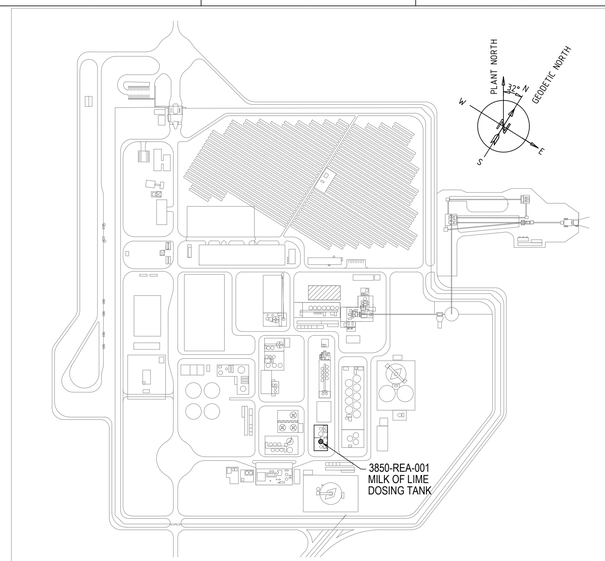

KEY PLAN
(SCALE 1:500)

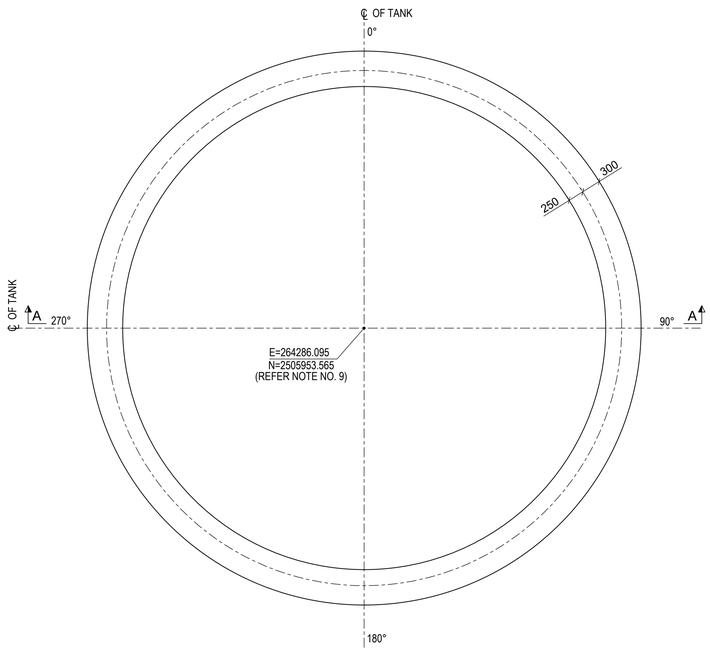

PLAN AT BOTTOM OF FOUNDATION
(3850-REA-001 MILK OF LIME DOSING TANK)
(SCALE - 1:50)

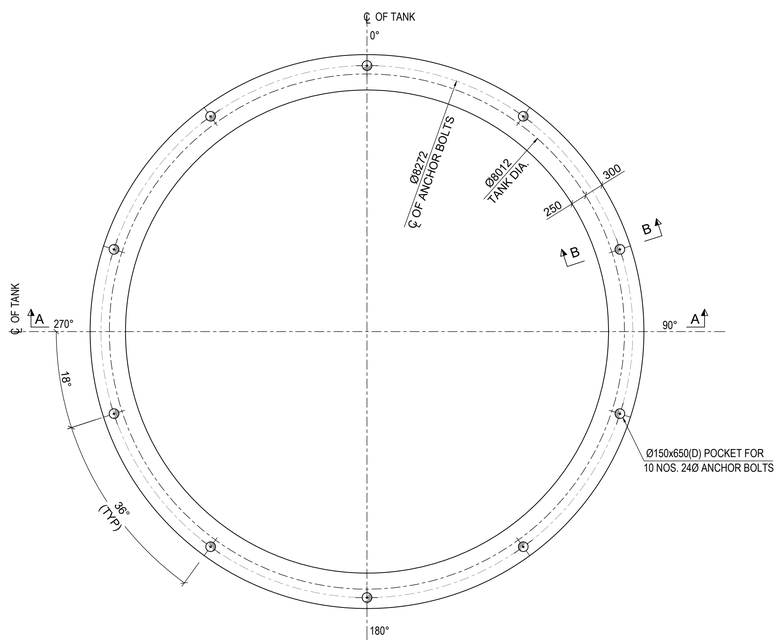

PLAN AT TOP OF FOUNDATION
(3850-REA-001 MILK OF LIME DOSING TANK)
(SCALE - 1:50)

LEGEND :-

R.L. - REDUCED LEVEL
T.O.C. - TOP OF CONCRETE.
T.O.G. - TOP OF GROUT
B.O.F. - BOTTOM OF FOUNDATION
F.G.L. - FINISHED GROUND LEVEL
TYP. - TYPICAL.
P.C.C - PLAIN CEMENT CONCRETE
R.C.C - REINFORCED CEMENT CONCRETE
PL. - PLATE
THK. - THICK
℄ - CENTRE LINE

NOTES:-

1. ALL DIMENSIONS ARE IN MILLIMETRE AND LEVELS ARE IN METRES UNLESS OTHERWISE STATED.
2. GRADE OF CONCRETE SHALL BE C35 UNLESS NOTED OTHERWISE.
3. GRADE OF REINFORCEMENT SHALL BE DEFORMED BAR ASTM A615-GRADE 60 (fy=420 MPa)
4. NET SAFE BEARING CAPACITY CONSIDERED AT THE FOUNDING LEVEL IS 670 KN/SQ. M
5. IF ANY PART OF FOUNDATION COMES ON BACKFILL ZONE OF ADJACENT FOUNDATION OR ANY LOOSE POCKETS ARE ENCOUNTERED BELOW FOUNDATION LEVEL THE SAME SHALL BE REMOVED AND FILLED WITH PCC.
6. SAND SHALL BE COMPACTED TO A MAXIMUM DEPTH OF 300MM & SHALL BE COMPACTED TO 80% RELATIVE DENSITY AS DETERMINED BY ASTM D4253 & ASTM D4254
7. FOR REINFORCEMENT DRAWING REFER DRG. NO. : MD-216-3850-EG-CV-DED-1429.
8. GENERAL NOTE FOR CIVIL WORK REFER DRG. NO : MD-216-1000-EG-CV-DED-1001.
9. TANK CO-ORDINATE MENTIONED IN THIS DRAWING ARE BASED AS ON DATE E3D LAYOUT. HOWEVER, BEFORE CONSTRUCTION FINAL CO-ORDINATES SHOULD BE VERIFIED.

DOCUMENT NUMBER	REFERENCE DOCUMENTS	REV	DATE	REVISION DESCRIPTION	DRN	CHK	ENG	APP	EMP
		D01	22/02/2023	AS-BUILT	SBH	BDA	SUE	AG	
MD-216-3850-EG-ME-GAD-1004	PLAN AT EL (+) 912.350	C02	03/09/2020	ISSUED FOR CONSTRUCTION & REVISED AS MKD △C02	SBH	BDA	SUE	AG	
MD-216-3850-EG-CV-GAD-1001	PLAN AT EL (+) 912.350 SECTIONS	C01	21/07/2020	ISSUED FOR CONSTRUCTION	SBH	BDA	SUE	AG	
MD-216-3850-EG-ME-PLN-1001	3850-REA-001 MILK OF LIME DOSING TANK	A01	25/06/2020	ISSUED FOR REFERENCE	SBH	BDA	SUE	AG	

RESERVED FOR VENDOR LOGO AND DRAWING NUMBER

LARSEN & TOUBRO

This drawing is the property of LARSEN & TOUBRO and must not be passed on to any person or body not authorized by us to receive it nor be copied or otherwise made use either in full or in part by such person or body without our prior permission in writing.

Outotec

The content of these documents are the sole property of Outotec Oyj. Any rights not expressly granted herein are reserved. Reproduction, transfer or distribution of part or all of the contents in any form without prior written permission of Outotec is prohibited.

MA'ADEN معادن
Saudi Arabian Mining Company شركة التعدين العربية السعودية

This document and the information contained herein is Ma'aden proprietary know-how. This document or any part thereof should not be reproduced, stored in a retrieval system or transmitted by any means, electronic or otherwise, or divulged without prior written permission of Ma'aden.

LARSEN & TOUBRO DRAWING NUMBER: O19045_450_C_G_24164_001 — REVISION: 3
OUTOTEC DRAWING NUMBER: 900707 __GAU01 __AA03__MTL01 __38511 — DOCUMENT ID: OU100688394 — REVISION: 3

DRAWN	SBH	23/06/2020
CHECKED	BDA	24/06/2020
ENGINEER	SUE	23/06/2020
APPROVED	AG	25/06/2020
EMPLOYER		
SCALE	1:100, 1:50	A1

MANSOURAH - MASSARAH GOLD PROJECT
GENERAL ARRANGEMENT DRAWING
REAGENTS - LIME SLAKING EQUIPMENT
MILK OF LIME DOSING TANK FOUNDATION

DRAWING NUMBER: MD - 216 - 3850 - EG - CV - GAD - 1428 — REV: D01