


DRAWING NUMBER MD - 216 - 3850 - EG - CV - GAD - 1429 REV D01

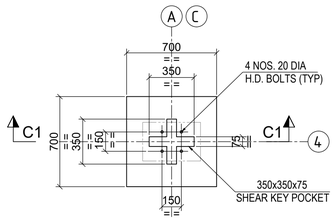


DETAIL OF COLUMN
MKD. - C1
(SCALE-1:25)

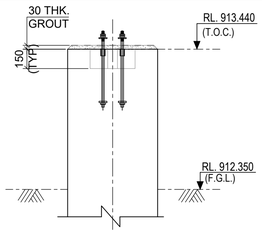


SECTION : C1-C1
(SCALE-1:25)

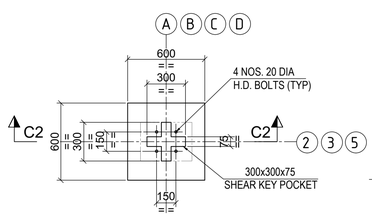


DETAIL OF COLUMN
MKD. - C2
(SCALE-1:25)

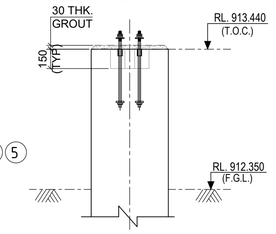


SECTION : C2-C2
(SCALE-1:25)

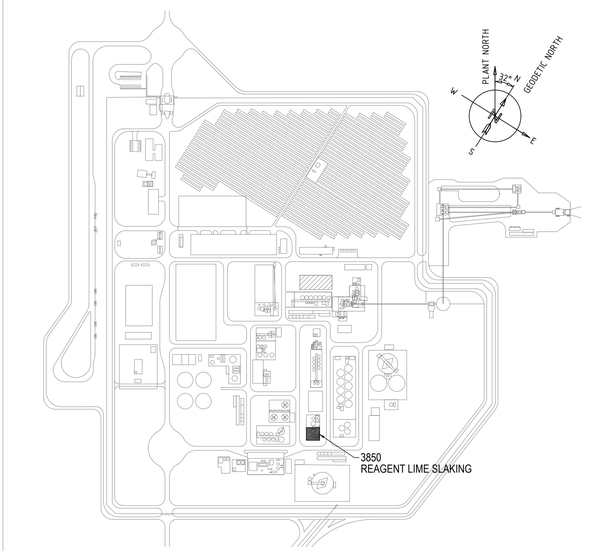


KEY PLAN
(SCALE 1:500)

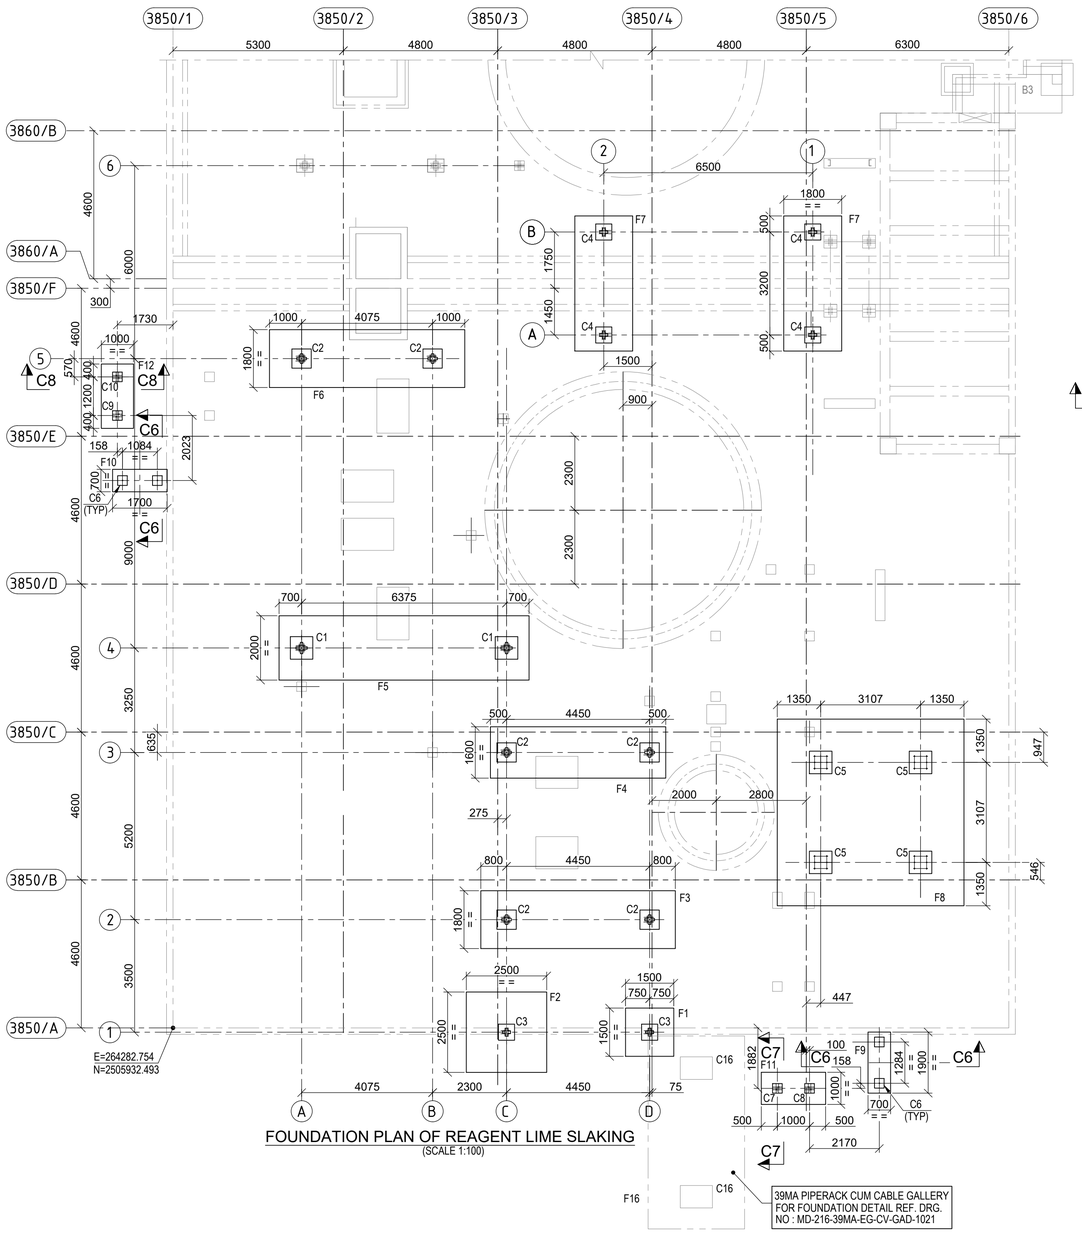


FOUNDATION PLAN OF REAGENT LIME SLAKING
(SCALE 1:100)

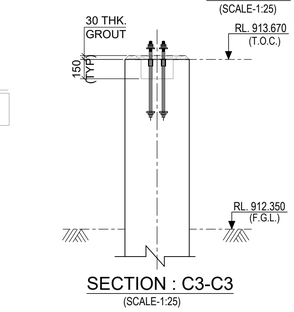


SECTION : C3-C3
(SCALE-1:25)

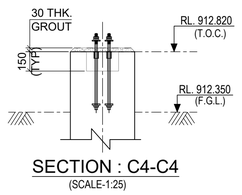


SECTION : C4-C4
(SCALE-1:25)

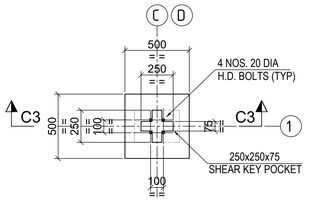


DETAIL OF COLUMN
MKD. - C3
(SCALE-1:25)

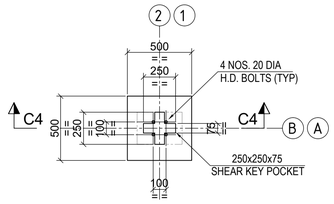


DETAIL OF COLUMN
MKD. - C4
(SCALE-1:25)

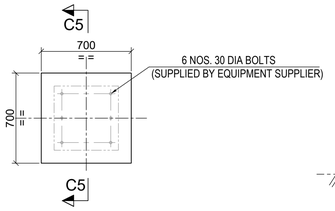


DETAIL OF COLUMN
MKD. - C5
(SCALE-1:25)

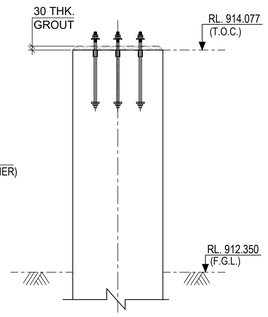


SECTION : C5-C5
(SCALE-1:25)

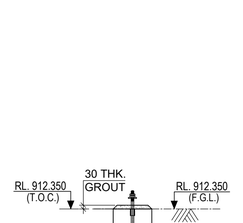


SECTION : C6-C6
(SCALE-1:25)

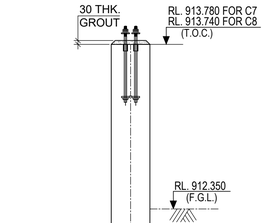


SECTION : C7-C7
(SCALE-1:25)

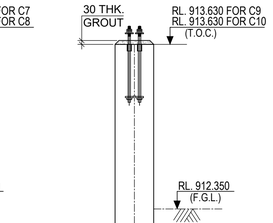


SECTION : C8-C8
(SCALE-1:25)

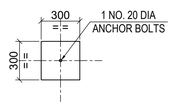

DETAIL OF COLUMN
MKD. - C6
(SCALE-1:25)

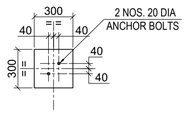

DETAIL OF COLUMN
MKD. - C7 & C9
(SCALE-1:25)

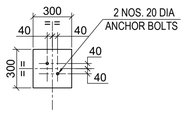

DETAIL OF COLUMN
MKD. - C8 & C10
(SCALE-1:25)

LEGEND :-

R.L. - REDUCED LEVEL
T.O.C. - TOP OF CONCRETE.
F.G.L. - FINISHED GROUND LEVEL.
TYP. - TYPICAL.
P.C.C - PLAIN CEMENT CONCRETE
MKD. - MARKED.
THK. - THICK
℄ - CENTRE LINE

NOTES:-

1. ALL DIMENSIONS ARE IN MILLIMETRES AND LEVELS ARE IN METRES UNLESS OTHERWISE STATED.
2. GRADE OF CONCRETE SHALL BE C35 UNLESS NOTED OTHERWISE.
3. GRADE OF REINFORCEMENT SHALL BE DEFORMED BAR ASTM A615-GRADE 60 (fy=420 MPa)
4. NET SAFE BEARING CAPACITY OF SOIL AT BOTTOM OF FOUNDATION CONSIDERED 670KN/SQ.M.
5. IF ANY PART OF FOUNDATION COMES ON BACKFILL ZONE OF ADJACENT FOUNDATION OR ANY LOOSE POCKETS ARE ENCOUNTERED BELOW FOUNDATION LEVEL THE SAME SHALL BE REMOVED AND FILLED WITH PCC.
6. FOR REINFORCEMENTS DETAIL REFER DRG. NO. MD - 216 - 3850 - EG - CV - DED - 1430.
7. FOR FOUNDATION BOLT DETAILS REFER DRG. NO : MD-216-1000-EG-CV-DED-1003.
8. FOR GENERAL NOTE FOR CIVIL WORK REFER DRG. NO : MD-216-1000-EG-CV-DED-1001.

39MA PIPERACK CUM CABLE GALLERY FOR FOUNDATION DETAIL REF. DRG. NO : MD-216-39MA-EG-CV-GAD-1021

DOCUMENT NUMBER	REFERENCE DOCUMENTS	REV	DATE	REVISION DESCRIPTION	DRN	CHK	ENG	APP	EMP
MD-216-3850-EG-ME-GAD-1004	PLAN AT EL. +912.350								
MD-216-3850-EG-CV-GAD-1001	PLAN AT EL. +912.350 AND SECTIONS								
MD-216-3850-EG-ME-GAD-1012	LOAD PLAN								
MD-216-3850-EG-ST-GAD-2355	PLAN, ELEVATIONS & DETAILS								
MD-216-3850-EG-ST-GAD-2005	MONORAIL BEAM SUPRTS & WLKWAY DET	D01	22/02/2023	AS-BUILT	SBH	BDA	SUE	AG	
MD-216-3850-EG-ST-GAD-2004	MONORAIL BEAM SUPRTS & WLKWAY DET	C01	03/11/2020	ISSUED FOR CONSTRUCTION & REVISED AS MKD. C01	SBH	BDA	SUE	AG	
MD-216-3850-EG-ST-GAD-2003	MONORAIL BEAM SUPRTS & WLKWAY DET	A01	23/09/2020	ISSUED FOR REFERENCE	AMT	BDA	SUE	AG	

RESERVED FOR VENDOR LOGO AND DRAWING NUMBER

LARSEN & TOUBRO
This drawing is the property of LARSEN & TOUBRO and must not be passed on to any person or body not authorized by us to receive it nor be copied or otherwise made use either in full or in part by such person or body without our prior permission in writing.

Outotec
The content of these documents are the sole property of Outotec Oyj. Any rights not expressly granted herein are reserved. Reproduction, transfer or distribution of part or all of the contents in any form without prior written permission of Outotec is prohibited.

MA'ADEN معادن
Saudi Arabian Mining Company شركة التعدين العربية السعودية
This document and the information contained herein is Ma'aden proprietary know-how. This document or any part thereof should not be reproduced, stored in a retrieval system or transmitted by any means, electronic or otherwise, or divulged without prior written permission of Ma'aden.

LARSEN & TOUBRO DRAWING NUMBER	019045_450_C_G_24164_002		REVISION 2
OUTOTEC DRAWING NUMBER	900707 _GAU01 _AA03_MTL01 _38512	DOCUMENT ID OU100688395	REVISION 2

DRAWN	AMT	23/09/2020
CHECKED	BDA	24/09/2020
ENGINEER	SUE	23/09/2020
APPROVED	AG	25/09/2020
EMPLOYER		
SCALE	1:100 1:25	A1

MANSOURAH - MASSARAH GOLD PROJECT
GENERAL ARRANGEMENT DRAWING
REAGENTS - LIME SLAKING EQUIPMENT
FOUNDATION PLAN

DRAWING NUMBER MD - 216 - 3850 - EG - CV - GAD - 1429 REV D01