


DRAWING NUMBER: MD-216-3850-EG-CV-GAD-1431
REV: D01

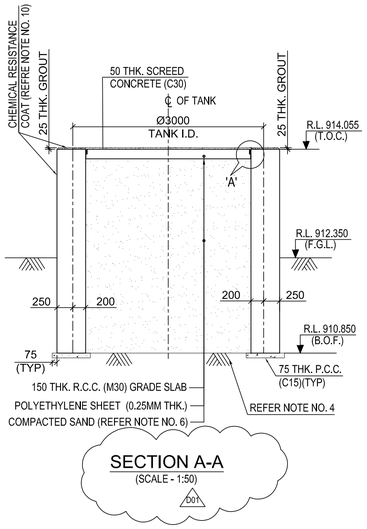


SECTION A-A
(SCALE - 1:50)

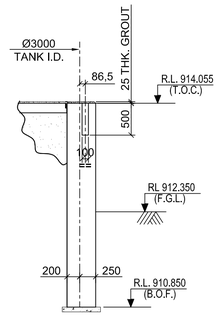


SECTION B-B
(SCALE - 1:50)

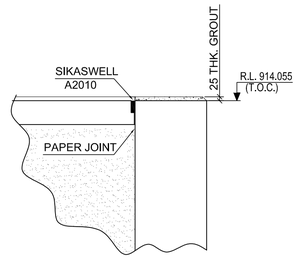

DETAIL - 'A'
(SCALE 1:20)

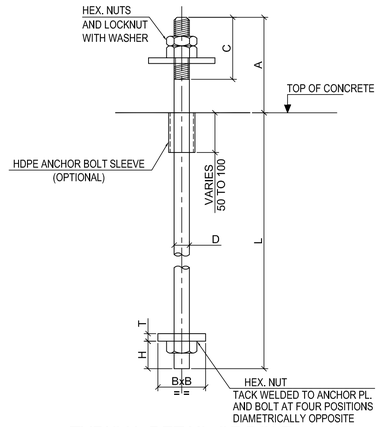


TYPICAL DETAIL OF BOLT
(SCALE - 1:50)

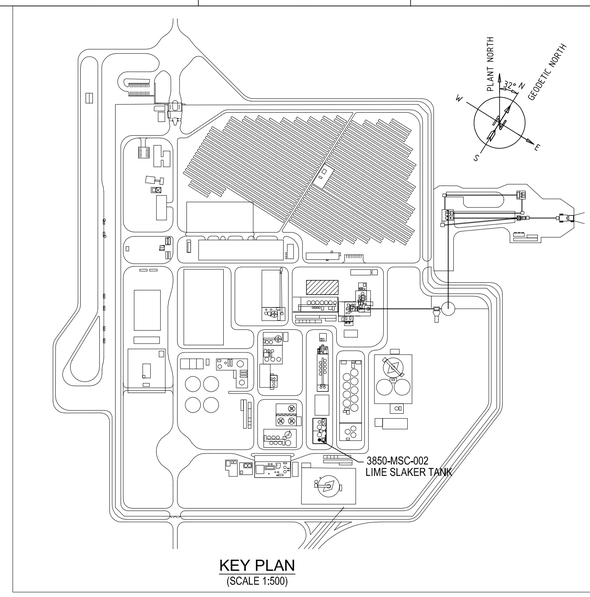


KEY PLAN
(SCALE 1:500)

SCHEDULE OF BOLTS


D BOLT DIA. MM	NO. OF BOLTS	BxB BOTTOM PLATE (SQUARE) SQ MM	DIMENSIONS (MM)				
			L	A	C	T	H
20	6	60x60	450	300	150	10	30

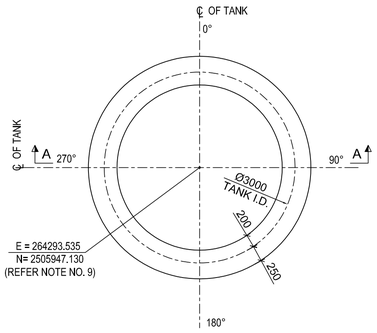


PLAN AT BOTTOM OF FOUNDATION
(3850-MSC-002 LIME SLAKER TANK)
(SCALE - 1:50)

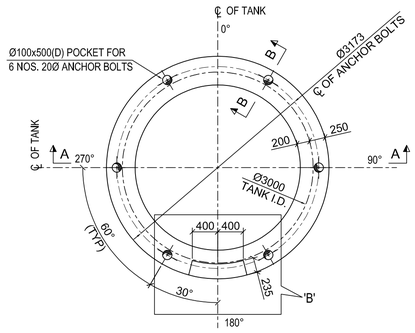

PLAN AT TOP OF FOUNDATION
(3850-MSC-002 LIME SLAKER TANK)
(SCALE - 1:50)

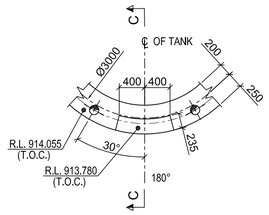

DETAIL - 'B'
(SCALE - 1:50)

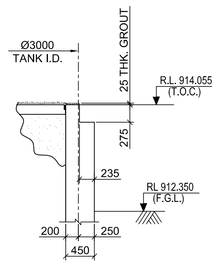

SECTION C-C
(SCALE - 1:50)

LEGEND :-

R.L. - REDUCED LEVEL
T.O.C. - TOP OF CONCRETE.
T.O.G. - TOP OF GROUT
B.O.F. - BOTTOM OF FOUNDATION
F.G.L. - FINISHED GROUND LEVEL
TYP. - TYPICAL.
P.C.C - PLAIN CEMENT CONCRETE
R.C.C - REINFORCED CEMENT CONCRETE
PL - PLATE
THK. - THICK
℄ - CENTRE LINE
I.D. - INNER DIAMETER

NOTES:-

1. ALL DIMENSIONS ARE IN MILLIMETRE AND LEVELS ARE IN METRES UNLESS OTHERWISE STATED.
2. GRADE OF CONCRETE SHALL BE C35 UNLESS NOTED OTHERWISE.
3. GRADE OF REINFORCEMENT SHALL BE DEFORMED BAR ASTM A615-GRADE 60 (fy=420 MPa)
4. NET SAFE BEARING CAPACITY CONSIDERED AT THE FOUNDING LEVEL IS 670 KN/SQ. M
5. IF ANY PART OF FOUNDATION COMES ON BACKFILL ZONE OF ADJACENT FOUNDATION OR ANY LOOSE POCKETS ARE ENCOUNTERED BELOW FOUNDATION LEVEL THE SAME SHALL BE REMOVED AND FILLED WITH PCC.
6. SAND SHALL BE COMPACTED TO A MAXIMUM DEPTH OF 300MM & SHALL BE COMPACTED TO 80% RELATIVE DENSITY AS DETERMINED BY ASTM D4253 & SATM 4254.
7. FOR REINFORCEMENT DRAWING REFER DRG. NO. : MD-216-3850-EG-CV-DED-1431.
8. GENERAL NOTE FOR CIVIL WORK REFER DRG. NO : MD-216-1000-EG-CV-DED-1001.
9. TANK CO-ORDINATE MENTIONED IN THIS DRAWING ARE BASED AS ON DATE E3D LAYOUT. HOWEVER, BEFORE CONSTRUCTION FINAL CO-ORDINATES SHOULD BE VERIFIED.
10. CHEMICAL RESISTANT COATING SHALL BE APPLIED FOR PROTECTING CONCRETE AGAINST CYANIDE, ACID AND ALKALI.

DOCUMENT NUMBER	REFERENCE DOCUMENTS	REV	DATE	REVISION DESCRIPTION	DRN	CHK	ENG	APP	EMP
		D01	13/03/2023	AS-BUILT	NAEW PC	BDA	SUE	AG	
MD-216-3850-EG-ME-GAD-1011	MIXING TANK 3850-MSC-002	C02	28/11/2020	ISSUED FOR CONSTRUCTION & REVISED AS MKD. (C02)	SBH	BDA	SUE	AG	
MD-216-3850-EG-ME-GAD-1004	PLAN AT EL. +912.350	C01	03/11/2020	ISSUED FOR CONSTRUCTION	SBH	BDA	SUE	AG	
MD-216-3850-EG-CV-GAD-1001	PLAN AT EL. +912.350 AND SECTIONS	A01	10/10/2020	ISSUED FOR REFERENCE	AMT	BDA	SUE	AG	

RESERVED FOR VENDOR LOGO AND DRAWING NUMBER

LARSEN & TOUBRO
This drawing is the property of LARSEN & TOUBRO and must not be passed on to any person or body not authorized by us to receive it nor be copied or otherwise made use either in full or in part by such person or body without our prior permission in writing.

Outotec
The content of these documents are the sole property of Outotec Oyj. Any rights not expressly granted herein are reserved. Reproduction, transfer or distribution of part or all of the contents in any form without prior written permission of Outotec is prohibited.

MA'ADEN معادن
Saudi Arabian Mining Company شركة المعادن العربية السعودية
This document and the information contained herein is Ma'aden proprietary know-how. This document or any part thereof should not be reproduced, stored in a retrieval system or transmitted by any means, electronic or otherwise, or divulged without prior written permission of Ma'aden.

LARSEN & TOUBRO DRAWING NUMBER		REVISION
019045_450_C_G_24164_004		3
OUTOTEC DRAWING NUMBER	DOCUMENT ID	REVISION
900707__GAU01__AA03__MTL01__38519	OU100695874	3

DRAWN	AMT	08/10/2020
CHECKED	BDA	09/10/2020
ENGINEER	SUE	08/10/2020
APPROVED	AG	10/10/2020
EMPLOYER		
SCALE	1:100, 1:50	A1

MANSOURAH - MASSARAH GOLD PROJECT
GENERAL ARRANGEMENT DRAWING
REAGENTS-LIME SLAKING EQUIPMENT
LIME SLAKER TANK FOUNDATION

DRAWING NUMBER: MD - 216 - 3850 - EG - CV - GAD - 1431
REV: D01