


DRAWING NUMBER: MD-216-3120-EG-CV-DED-1004 R/EV D01

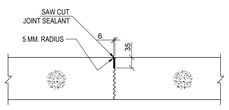


CONSTRUCTION JOINT
SCALE 1:10

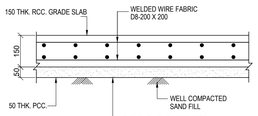


TYP. DETAIL OF 150 THK. GRADE SLAB
SCALE 1:10

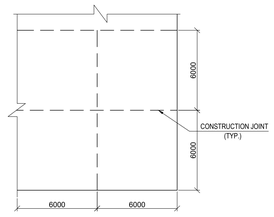


TYP. PLAN OF CONSTRUCTION JOINT
(CONCRETE GRADE SLAB AREA)
(SCALE - 1:100)

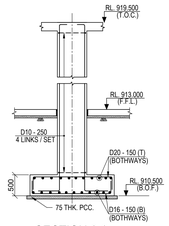


SECTION 6-6
(SCALE-1:50)

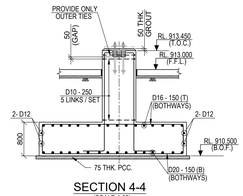


SECTION 4-4
(SCALE-1:50)

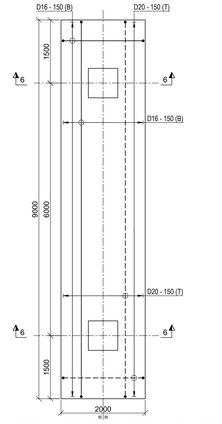


R.C. DETAIL OF FOUNDATION MKD. CF2
(SCALE-1:50)

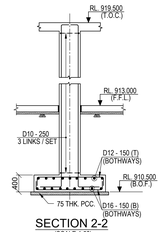


SECTION 2-2
(SCALE-1:50)

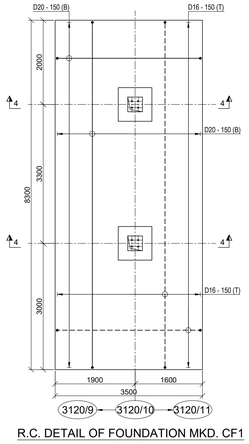


R.C. DETAIL OF FOUNDATION MKD. CF1
(SCALE-1:50)

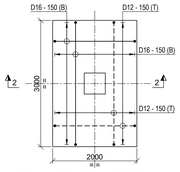


R.C. DETAIL OF FOUNDATION MKD. F1A
(SCALE-1:50)

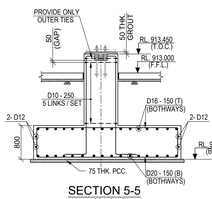


SECTION 5-5
(SCALE-1:50)

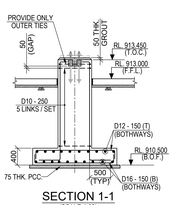


SECTION 1-1
(SCALE-1:50)

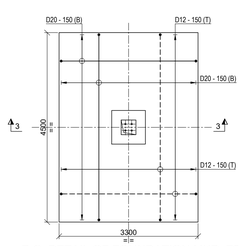


R.C. DETAIL OF FOUNDATION MKD. F2
(SCALE-1:50)

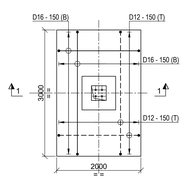


R.C. DETAIL OF FOUNDATION MKD. F1
(SCALE-1:50)

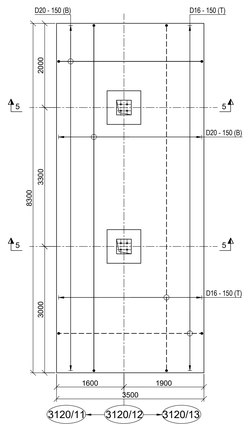


R.C. DETAIL OF FOUNDATION MKD. CF1A
(SCALE-1:50)

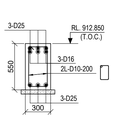


TYP. CROSS SECTION OF
BEAM MKD. TB1
(SLAB REIN. NOT SHOWN FOR CLARITY)
(SCALE- 1:25)

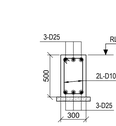


TYP. CROSS SECTION OF
BEAM MKD. TB2
(SLAB REIN. NOT SHOWN FOR CLARITY)
(SCALE- 1:25)

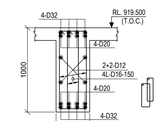


TYP. CROSS SECTION OF
BEAM MKD. FB1
(SLAB REIN. NOT SHOWN FOR CLARITY)
(SCALE- 1:25)

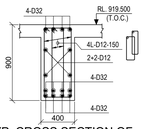


TYP. CROSS SECTION OF
BEAM MKD. FB2
(SLAB REIN. NOT SHOWN FOR CLARITY)
(SCALE- 1:25)

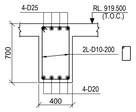


TYP. CROSS SECTION OF
BEAM MKD. FB3
(SLAB REIN. NOT SHOWN FOR CLARITY)
(SCALE- 1:25)

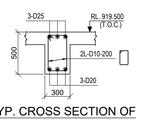


TYP. CROSS SECTION OF
BEAM MKD. FB4
(SLAB REIN. NOT SHOWN FOR CLARITY)
(SCALE- 1:25)

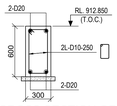


TYP. CROSS SECTION OF
GRADE BEAM
(SCALE- 1:25)

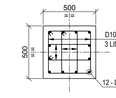


R.C. DETAIL OF COLUMN
MKD. C1
SCALE 1:20

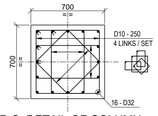

R.C. DETAIL OF COLUMN
MKD. C2
SCALE 1:20

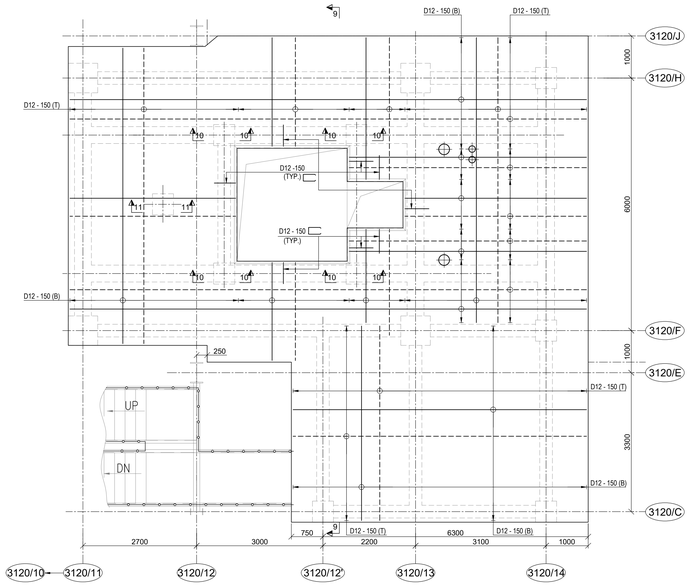


R.C. DETAIL OF SLAB AT RL. 919.500 (T.O.C)
(SCALE - 1:50)

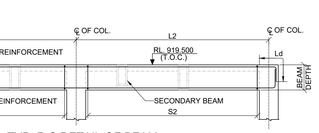


R.C. DETAIL OF PEDESTAL
MKD. P1, P2 & P3
SCALE 1:20


TYP. R.C DETAIL OF BEAM
(SLAB REIN. NOT SHOWN FOR CLARITY)
(SCALE- 1:50)

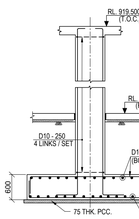


SECTION 8-8
(SCALE-1:50)

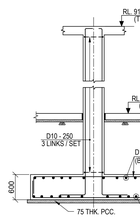


SECTION 7-7
(SCALE-1:50)

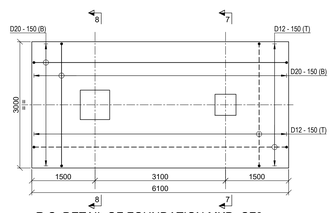


R.C. DETAIL OF FOUNDATION MKD. CF3
(SCALE-1:50)

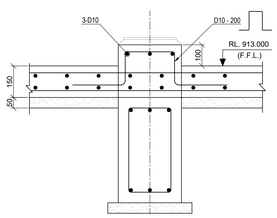


TYP. R.C. DETAIL OF SECTION D-D
(REFER DRAWING NUMBER MD-216-3120-EG-CV-GAD-1004)
SCALE 1:10

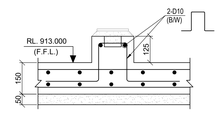

TYP. R.C. DETAIL OF SECTION B-B
(REFER DRAWING NUMBER MD-216-3120-EG-CV-GAD-1004)
SCALE 1:10

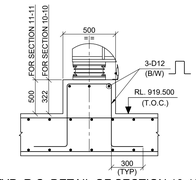

TYP. R.C. DETAIL OF SECTION 10-10
AND SECTION 11-11
(SCALE 1:20)

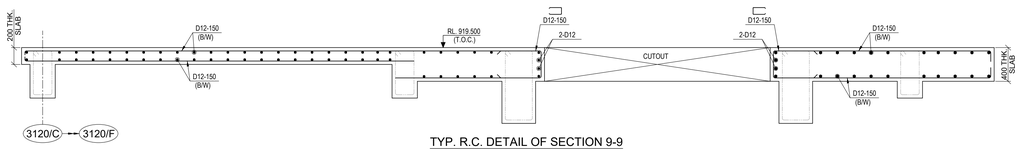

TYP. R.C. DETAIL OF SECTION 9-9
(BEAM REIN. NOT SHOWN FOR CLARITY)
(SCALE- 1:25)

LEGEND :-
R.L - REDUCED LEVEL
℄ - CENTRE LINE
C.J - CONSTRUCTION JOINT
FDN. - FOUNDATION.
T.O.C. - TOP OF CONCRETE.
F.G.L. - FINISHED GROUND LEVEL.
F.F.L. - FINISHED FLOOR LEVEL.
B.O.F. - BOTTOM OF FOUNDATION
TYP. - TYPICAL
R.C. - REINFORCED CONCRETE.
P.C.C - PLAIN CEMENT CONCRETE
MKD. - MARKED.
THK. - THICK.
D - DIAMETER OF BAR
B/W - BOTH WAYS.
Ld - DEVELOPMENT LENGTH
BOTTOM REINFORCEMENT (B) ———
TOP REINFORCEMENT (T) - - - - -

NOTES :-
1. ALL DIMENSIONS ARE IN MILLIMETRES AND LEVELS AND CO-ORDINATES ARE IN METRES. UNLESS OTHERWISE STATED.
2. GRADE OF CONCRETE SHALL BE C35 FOR FOUNDATION.
3. GRADE OF REINFORCEMENT SHALL BE DEFORMED BAR ASTM A615 - GRADE 60 (fy = 420 MPa).
4. NET SAFE BEARING CAPACITY OF SOIL AT BOTTOM OF FOUNDATION CONSIDERED 500KN/SQ. M.
5. CLEAR COVER TO MAIN REINFORCEMENT SHALL BE AS
   a) FOUNDATION = 75 mm (BOTTOM & SIDE) 50 mm. (TOP)
   b) COLUMN & PEDESTAL = 50mm
   c) BEAM = 50mm
   d) SLAB = 40mm
6. MINIMUM LAP LENGTH OF REINFORCEMENT SHALL BE 40 x DIA. OF BAR.
7. READ THIS DRAWING IN CONJUNCTION WITH DRG: MD-216-3120-EG-CV-GAD-1004

REV	DATE	REVISION DESCRIPTION	DRN	CHK	ENG	APP	EMP
D01	10/03/2023	AS-BUILT	HSK	SBY	APR	AG	
C01	11/03/2020	ISSUED FOR CONSTRUCTION	HSK	SBY	APR	AG	
A01	27/01/2020	ISSUED FOR REFERENCE	JKM	SBY	APR	AG	

DOCUMENT NUMBER	REFERENCE DOCUMENTS
MD-216-1000-EG-ST-CRT-1001	CIVIL,STRUCTURAL & ARCHITECTURAL DESIGN CRITERIA
MD-216-3120-EG-CV-GAD-1004-RA01	GAD, SECONDARY CRUSHING, LAYOUT & DETAILS

RESERVED FOR VENDOR LOGO AND DRAWING NUMBER

LARSEN & TOUBRO

This drawing is the property of LARSEN & TOUBRO and must not be passed on to any person or body not authorized by us to receive it nor be copied or otherwise made use either in full or in part by such person or body without our prior permission in writing.

Outotec

The content of these documents are the sole property of Outotec Oyj. Any rights not expressly granted herein are reserved. Reproduction, transfer or distribution of part or all of the contents in any form without prior written permission of Outotec is prohibited.

MA'ADEN معادن
Saudi Arabian Mining Company شركة معادن العربية السعودية

This document and the information contained herein is Ma'aden proprietary know-how. This document or any part thereof should not be reproduced, stored in a retrieval system or transmitted by any means, electronic or otherwise, or divulged without prior written permission of Ma'aden.

LARSEN & TOUBRO DRAWING NUMBER	019045_100_C_D_24063_001		REVISION 2
OUTOTEC DRAWING NUMBER	900707__GAU01__ZC01__CTB17__31202	DOCUMENT ID OU100670444	REVISION 2
DRAWN	JKM	10/01/2020	
CHECKED	SBY	23/01/2020	
ENGINEER	APR	20/01/2020	
APPROVED	AG	27/01/2020	
EMPLOYER			
SCALE	1:100,50,25,20	A0	

MANSOURAH - MASSARAH GOLD PROJECT
DETAIL DRAWING
SECONDARY CRUSHING
RC DETAILS

DRAWING NUMBER: MD-216-3120-EG-CV-DED-1004 REV: D01