

SCHEDULE OF FOOTING REINFORCEMENT


FDN. MKD.	FOUNDATION SIZE			REINFORCEMENT DETAIL		BOTTOM OF FDN.	NOS.
	L	B	D	BOTTOM REIN. (a)	TOP REIN. (b)		
F1 & F1A	2500	2500	450	D16-150 (B/W)	D12-150 (B/W)	RL. 910.500	7
F2, F2A & F2B	3000	3000	600	D16-150 (B/W)	D12-150 (B/W)	RL. 910.500	12
F3 & F3A	3200	3200	700	D20-150 (B/W)	D12-150 (B/W)	RL. 910.500	7
F4	4000	4000	600	D20-200 (B/W)	D12-200 (B/W)	RL. 910.500	2
CF1	3000	4035	650	D25-200 (B/W)	D12-200 (B/W)	RL. 910.500	1
F4A	4000	4000	800	D25-200 (B/W)	D16-200 (B/W)	RL. 910.500	1

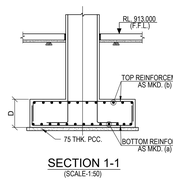


SECTION 1-1
(SCALE-1:50)

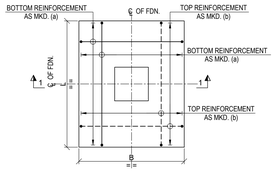


TYPICAL RCC. DET. OF FOUNDATION
(SCALE-1:50)

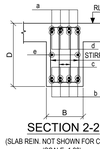

SECTION 2-2
(SLAB REIN. NOT SHOWN FOR CLARITY)
(SCALE- 1:20)

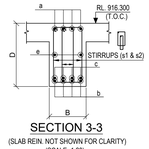


SECTION 3-3
(SLAB REIN. NOT SHOWN FOR CLARITY)
(SCALE- 1:20)

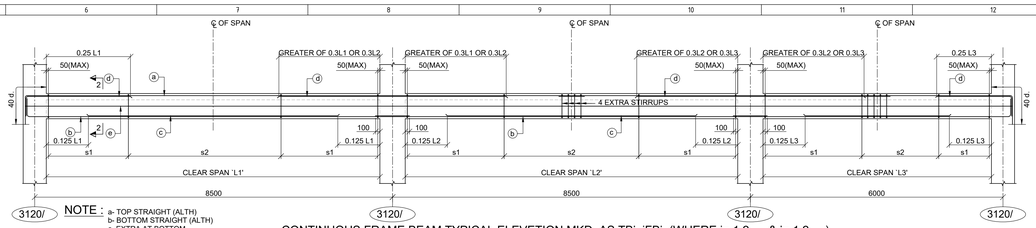

NOTE :
a- TOP STRAIGHT (ALTH)
b- BOTTOM STRAIGHT (ALTH)
c- EXTRA AT BOTTOM
d- EXTRA AT SUPPORT
e- SIDE REINFORCEMENT
s1- STIRRUPS
s2- STIRRUPS

CONTINUOUS FRAME BEAM TYPICAL ELEVETION MKD. AS TBj, iFBj (WHERE i= 1,2,.... & j= 1,2,....)
(SLAB REIN. NOT SHOWN FOR CLARITY)
(SCALE- 1:50)

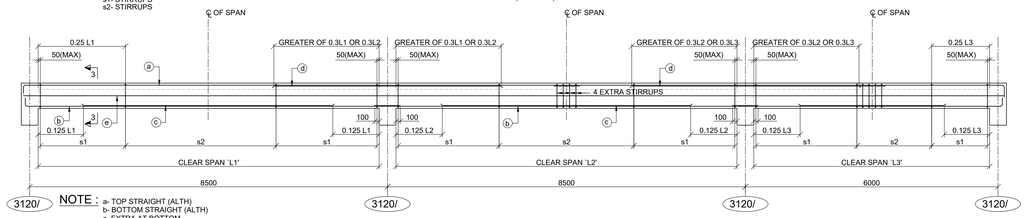

NOTE :
a- TOP STRAIGHT (ALTH)
b- BOTTOM STRAIGHT (ALTH)
c- EXTRA AT BOTTOM
d- EXTRA AT SUPPORT
e- SIDE REINFORCEMENT
s1- STIRRUPS
s2- STIRRUPS

CONTINUOUS SECONDARY BEAM TYPICAL ELEVETION MKD. AS iBj (WHERE i= 1,2,.... & j=1,2,....)
(SLAB REIN. NOT SHOWN FOR CLARITY)
(SCALE- 1:50)

SCHEDULE OF TIE BEAM REINFORCEMENT AT RL. 912.850


BEAM MKD.	SIZE	TOP REINFORCEMENT		BOTTOM REINFORCEMENT		STIRRUP	
		CONTINUOUS (a)	EXTRA (d)	CONTINUOUS (b)	EXTRA (c)	STIRRUP (s1)	STIRRUP (s2)
TB1	300x550	2-D16 + 1-D12	–	2-D16 + 1-D12	–	2L-D10-150	2L-D10-250
TB2 & TB2A	300x550	3-D25	–	3-D20	–	2L-D10-150	2L-D10-250
TB3 & TB3A	300x550	3-D25	–	2-D25 + 1-D12	–	2L-D10-150	2L-D10-250
TB4	300x500	2-D16 + 1-D12	–	2-D16 + 1-D12	–	2L-D10-150	2L-D10-250
TB5	300x500	2-D20 + 1-D12	–	2-D16 + 1-D12	–	2L-D10-150	2L-D10-250
TB5A	300x500	3-D20	2-D16	3-D20	2-D12	2L-D10-150	2L-D10-250

SCHEDULE OF BEAM REINFORCEMENT AT RL. 916.300


BEAM MKD.	SIZE	TOP REINFORCEMENT		BOTTOM REINFORCEMENT		STIRRUP	
		CONTINUOUS (a)	EXTRA (d)	CONTINUOUS (b)	EXTRA (c)	STIRRUP (s1)	STIRRUP (s2)
1FB7	300x550	3-D20+3-D20	–	3-D20+3-D16	–	2L-D12-150	2L-D10-250
1FB8	300x550	3-D16	–	3-D16	–	2L-D10-150	2L-D10-250
1B1	300x500	3-D16	–	3-D16	–	2L-D10-150	2L-D10-250
1B2	300x500	3-D16	–	3-D16	–	2L-D10-150	2L-D10-250
1B3	300x500	3-D20	3-D12	3-D16	–	2L-D10-150	2L-D10-250
1B4	300x500	2-D25+1-D20	2-D16	3-D20	2-D12	2L-D10-150	2L-D10-250
1B5	300x500	3-D16	2-D12	3-D16	–	2L-D10-150	2L-D10-250

SCHEDULE OF FRAME BEAM REINFORCEMENT AT RL. 920.025 & LANDING BEAMS


BEAM MKD.	SIZE	TOP REINFORCEMENT		BOTTOM REINFORCEMENT		STIRRUP	
		CONTINUOUS (a)	EXTRA (d)	CONTINUOUS (b)	EXTRA (c)	STIRRUP (s1)	STIRRUP (s2)
2FB1	350x650	3-D20	3-D16	3-D20	–	2L-D10-150	2L-D10-250
2FB2	350x650	3-D20	3-D20	2-D25+1-16	–	2L-D10-150	2L-D10-250
2FB3	350x1000	3-D32	3-D20	3-D25	3-D16	2L-D12-125	2L-D12-250
LB1	350x650	3-D25	–	3-D25	–	2L-D10-150	2L-D10-250
LB2	300x750	3-D20	–	3-D20	–	2L-D10-150	2L-D10-250

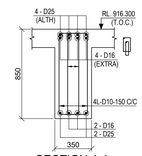


SECTION 4-4
(SLAB REIN. NOT SHOWN FOR CLARITY)
(SCALE- 1:20)

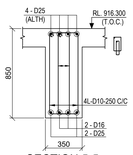


SECTION 5-5
(SLAB REIN. NOT SHOWN FOR CLARITY)
(SCALE- 1:20)

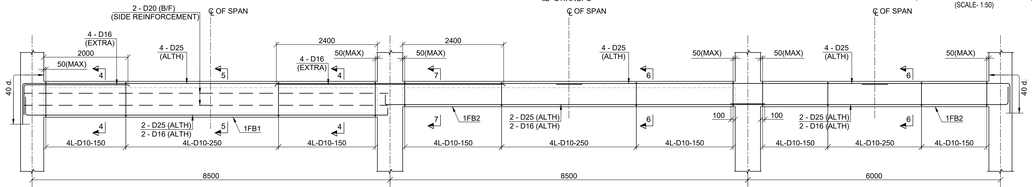


R.C. DETAIL OF FLOOR BEAM AT RL. 916.300 ON AXIS 3120/L
(SLAB REIN. NOT SHOWN FOR CLARITY)
(SCALE- 1:50)

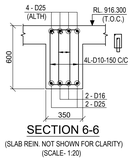


SECTION 6-6
(SLAB REIN. NOT SHOWN FOR CLARITY)
(SCALE- 1:20)

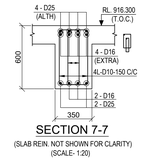


SECTION 7-7
(SLAB REIN. NOT SHOWN FOR CLARITY)
(SCALE- 1:20)

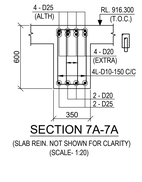


SECTION 7A-7A
(SLAB REIN. NOT SHOWN FOR CLARITY)
(SCALE- 1:20)

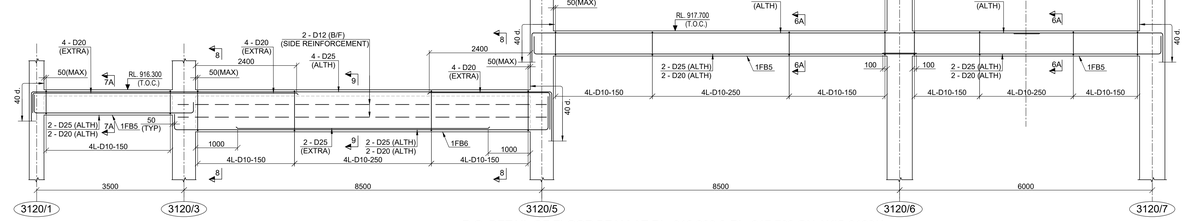


R.C. DETAIL OF FLOOR BEAM AT RL. 916.300 & RL. 917.700 ON AXIS 3120/J
(SLAB REIN. NOT SHOWN FOR CLARITY)
(SCALE- 1:50)

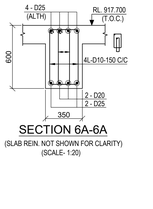


SECTION 6A-6A
(SLAB REIN. NOT SHOWN FOR CLARITY)
(SCALE- 1:20)

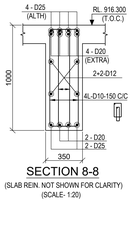


SECTION 8-8
(SLAB REIN. NOT SHOWN FOR CLARITY)
(SCALE- 1:20)

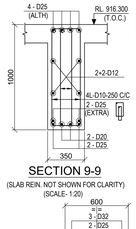


SECTION 9-9
(SLAB REIN. NOT SHOWN FOR CLARITY)
(SCALE- 1:20)

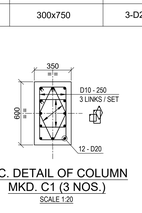


R.C. DETAIL OF COLUMN MKD. C1 (3 NOS.)
SCALE 1:20

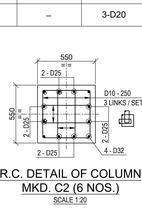


R.C. DETAIL OF COLUMN MKD. C2 (6 NOS.)
SCALE 1:20

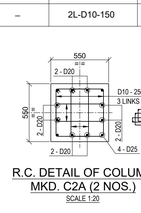


R.C. DETAIL OF COLUMN MKD. C2A (2 NOS.)
SCALE 1:20

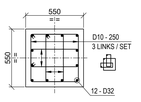


R.C. DETAIL OF COLUMN MKD. C2B (1 NO.)
SCALE 1:20

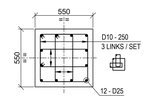


R.C. DETAIL OF COLUMN MKD. C2C (3 NOS.)
SCALE 1:20

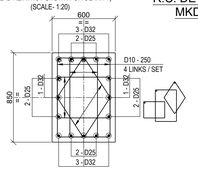


R.C. DETAIL OF COLUMN MKD. C3 (7 NOS.)
SCALE 1:20

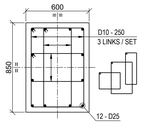


R.C. DETAIL OF COLUMN MKD. C3A (2 NOS.)
SCALE 1:20

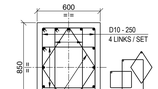


R.C. DETAIL OF COLUMN MKD. C3B (1 NO.)
SCALE 1:20

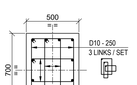


R.C. DETAIL OF PEDESTAL MKD. P1, P2 & P3 (2 NOS., 3 NOS. & 2 NOS.)
SCALE 1:20

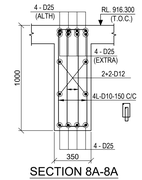


SECTION 8A-8A
(SLAB REIN. NOT SHOWN FOR CLARITY)
(SCALE- 1:20)

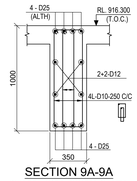


SECTION 9A-9A
(SLAB REIN. NOT SHOWN FOR CLARITY)
(SCALE- 1:20)

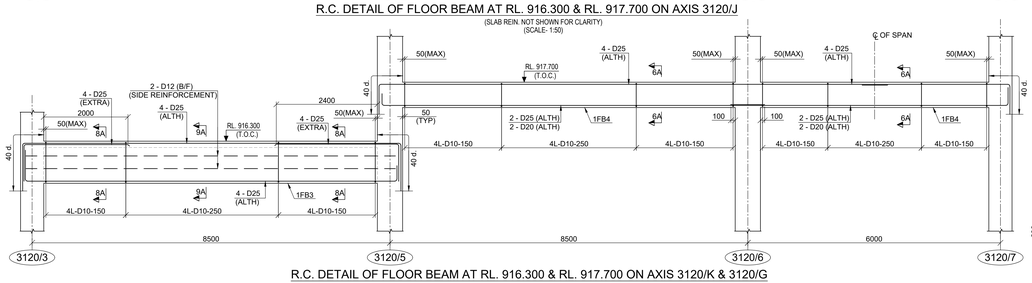


R.C. DETAIL OF FLOOR BEAM AT RL. 916.300 & RL. 917.700 ON AXIS 3120/K & 3120/G
(SLAB REIN. NOT SHOWN FOR CLARITY)
(SCALE- 1:50)

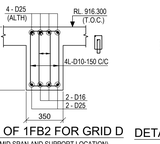


DETAIL OF 1FB2 FOR GRID D
(AT MID SPAN AND SUPPORT LOCATION)
(SLAB REIN. NOT SHOWN FOR CLARITY)
(SCALE- 1:20)

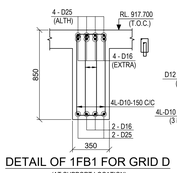


DETAIL OF 1FB1 FOR GRID D
(AT SUPPORT LOCATION)
(SLAB REIN. NOT SHOWN FOR CLARITY)
(SCALE- 1:20)

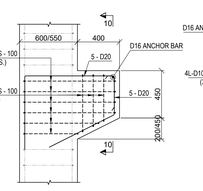


R.C. DETAIL OF ONE SIDED CORBEL
SCALE 1:20

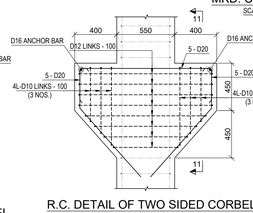


R.C. DETAIL OF TWO SIDED CORBEL
SCALE 1:20

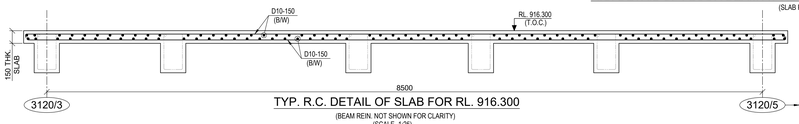


TYP. R.C. DETAIL OF SLAB FOR RL. 916.300
(BEAM REIN. NOT SHOWN FOR CLARITY)
(SCALE- 1:25)

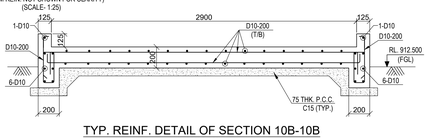


TYP. REINF. DETAIL OF SECTION 10B-10B
(SCALE-1:20)

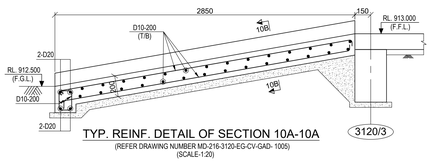


TYP. REINF. DETAIL OF SECTION 10A-10A
(REFER DRAWING NUMBER MD-216-3120-EG-CV-GAD- 1005)
(SCALE-1:20)

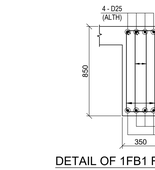

DETAIL OF 1FB1 FOR GRID D
(AT MID SPAN LOCATION)
(SLAB REIN. NOT SHOWN FOR CLARITY)
(SCALE- 1:20)

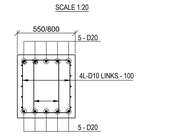

SECTION 10-10
SCALE 1:20

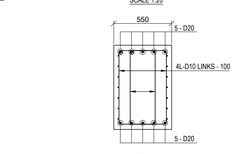

SECTION 11-11
SCALE 1:20

LEGENDS:-
R.L - REDUCED LEVEL
℄ - CENTRE LINE
CJ - CONSTRUCTION JOINT
FDN. - FOUNDATION
T.O.C. - TOP OF CONCRETE
F.G.L. - FINISHED GROUND LEVEL
F.F.L. - FINISHED FLOOR LEVEL
B.O.F. - BOTTOM OF FOUNDATION
TYP. - TYPICAL
R.C. - REINFORCED CONCRETE
P.C.C. - PLAIN CEMENT CONCRETE
MKD. - MARKED
THK. - THICK
D - DIAMETER OF BAR
B/W - BOTH WAYS
Ld - DEVELOPMENT LENGTH
BOTTOM REINFORCEMENT (B) - ———
TOP REINFORCEMENT (T) - – – – – –
ALTH - ALLTHROUGH
B/F - BOTH FACE
REIN. - REINFORCEMENT
(T/B)- TOP/BOTTOM

NOTES :-
1. ALL DIMENSIONS ARE IN MILLIMETRES AND LEVELS AND CO-ORDINATES ARE IN METRES. UNLESS OTHERWISE STATED.
2. GRADE OF CONCRETE SHALL BE C35 FOR FOUNDATION.
3. GRADE OF REINFORCEMENT SHALL BE DEFORMED BAR ASTM A615 - GRADE 60 (fy = 420 MPa).
4. NET SAFE BEARING CAPACITY OF SOIL AT BOTTOM OF FOUNDATION CONSIDERED 100KN/SQ. M.
5. CLEAR COVER TO MAIN REINFORCEMENT SHALL BE AS
   a) FOUNDATION = 75 mm (BOTTOM & SIDE) 50 mm. (TOP)
   b) COLUMN & PEDESTAL = 50mm
   c) BEAM = 50mm
   d) SLAB = 40mm
6. FOR MINIMUM LAP LENGTH OF REINFORCEMENT REFER STANDARD DRAWING NO. MD-216-1000-EG-CV-DED-1001
7. READ THIS DRAWING IN CONJUNCTION WITH DRG: MD-216-3120-EG-CV-DED-1006

REV	DATE	REVISION DESCRIPTION	DRN	CHK	ENG	APP	EMP
D01	10/03/2023	AS-BUILT	JKM	SBY	RPK/APL	AG	
C03	13/02/2021	ISSUED FOR CONSTRUCTION & REVISED AS MKD. (03)	JKM	SBY	RPK/APL	AG	
C02	12/08/2020	ISSUED FOR CONSTRUCTION & REVISED AS MKD. (02)	JKM	SBY	RPK/APL	AG	
C01	09/04/2020	ISSUED FOR CONSTRUCTION, REVISED AS PER EMPLOYER COMMENTS DATED 04/04/2020 & REVISED AS MKD. (01)	JKM	SBY	RPK/APL	AG	
A01	07/03/2020	ISSUED FOR REFERENCE	JKM	SBY	RPK/APL	AG	

DOCUMENT NUMBER	REFERENCE DOCUMENTS
MD-216-1000-EG-ST-CRT-1001	CIVIL,STRUCTURAL & ARCHITECTURAL DESIGN CRITERIA
MD-216-3120-EG-CV-GAD-1005-RA01	GAD,SCREEN BUILDING LAYOUT,FLOOR PLAN&DETAILS
MD-216-3120-EG-CV-GAD-1006-RA01	GAD,SCREEN BUILDING FLOOR PLANS & DETAILS
MD-216-3120-EG-CV-GAD-1008-RA01	GAD,SCREEN BUILDING SECTION & DETAILS

RESERVED FOR VENDOR LOGO AND DRAWING NUMBER

LARSEN & TOUBRO
This drawing is the property of LARSEN & TOUBRO and must not be passed on to any person or body not authorized by us to receive it nor be copied or otherwise made use either in full or in part by such person or body without our prior permission in writing.

Outotec
The content of these documents are the sole property of Outotec Oyj. Any rights not expressly granted herein are reserved. Reproduction, transfer or distribution of part or all of the contents in any form without prior written permission of Outotec is prohibited.

MA'ADEN معادن
Saudi Arabian Mining Company شركة المعادن للصناعات التعدينية السعودية
This document and the information contained herein is Ma'aden proprietary know-how. This document or any part thereof should not be reproduced, stored in a retrieval system or transmitted by any means, electronic or otherwise, or divulged without prior written permission of Ma'aden.

LARSEN & TOUBRO DRAWING NUMBER	L&T0904.5_100_C_D_24.069_001
REVISION	4
OUTOTEC DRAWING NUMBER	900707__GAU01__ZC01__CTB17__31204
DOCUMENT ID	OU100672908
REVISION	4
DRAWN	JKM 29/02/2020
CHECKED	SBY 05/03/2020
ENGINEER	RPK/APL 04/03/2020
APPROVED	AG 07/03/2020
EMPLOYER	
SCALE	1:100,50,25,20 A0

MANSOURAH - MASSARAH GOLD PROJECT
DETAIL DRAWING
SCREEN BUILDING
RC DETAILS OF FOOTINGS, COLUMNS & BEAMS

DRAWING NUMBER: MD - 216 - 3120 - EG - CV - DED - 1005
REV: D01