



R.C. DETAIL OF FLOOR BEAM AT RL. 922.750 ON AXIS 3120/D & 3120/L

(SLAB REIN. NOT SHOWN FOR CLARITY)
(SCALE- 1:50)

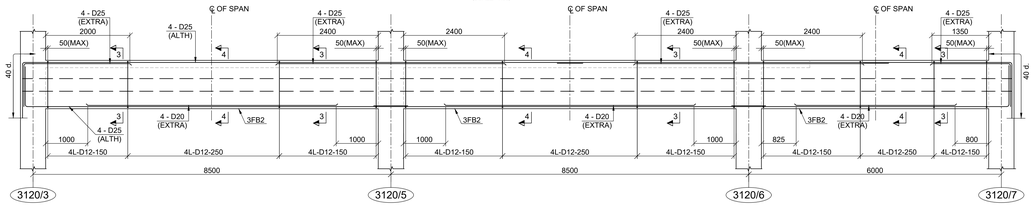


R.C. DETAIL OF FLOOR BEAM AT RL. 922.750 ON AXIS 3120/G & 3120/K

(SLAB REIN. NOT SHOWN FOR CLARITY)
(SCALE- 1:50)

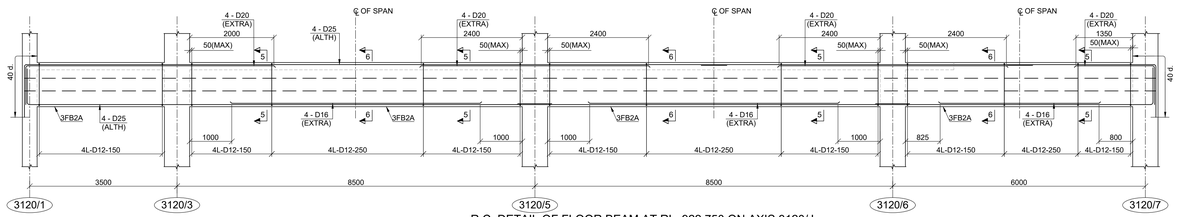


R.C. DETAIL OF FLOOR BEAM AT RL. 922.750 ON AXIS 3120/J


(SLAB REIN. NOT SHOWN FOR CLARITY)
(SCALE- 1:50)

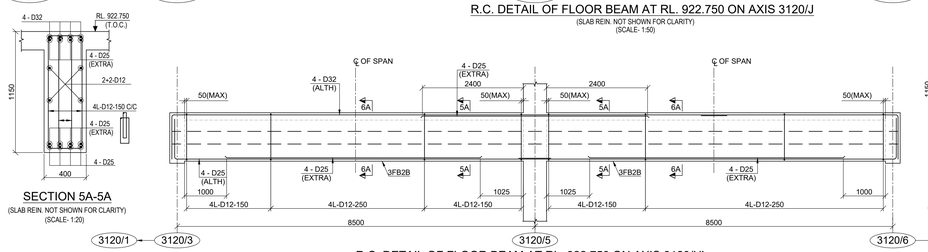

R.C. DETAIL OF FLOOR BEAM AT RL. 922.750 ON AXIS 3120/H'


(SLAB REIN. NOT SHOWN FOR CLARITY)
(SCALE- 1:50)

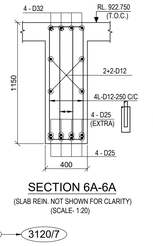

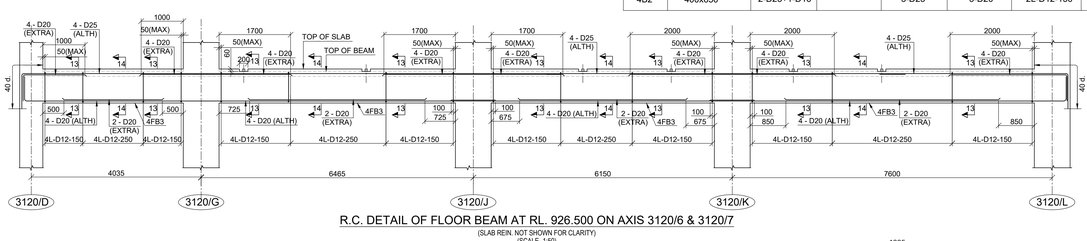


R.C. DETAIL OF FLOOR BEAM AT RL. 926.500 ON AXIS 3120/6 & 3120/7

(SLAB REIN. NOT SHOWN FOR CLARITY)
(SCALE- 1:50)

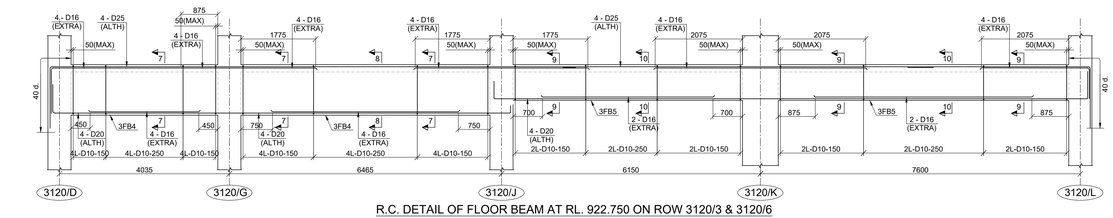


R.C. DETAIL OF FLOOR BEAM AT RL. 922.750 ON ROW 3120/3 & 3120/6


(SLAB REIN. NOT SHOWN FOR CLARITY)
(SCALE- 1:50)

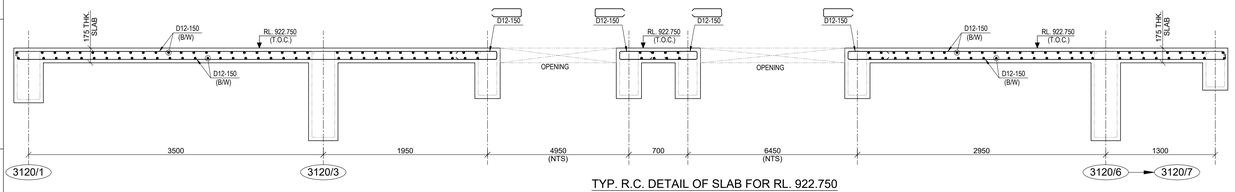

TYP. R.C. DETAIL OF SLAB FOR RL. 922.750


(BEAM REIN. NOT SHOWN FOR CLARITY)
(SCALE- 1:25)

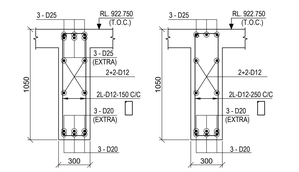


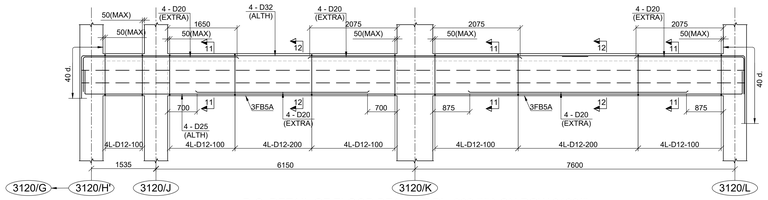


R.C. DETAIL OF FLOOR BEAM AT RL. 922.750 ON ROW 3120/5

(SLAB REIN. NOT SHOWN FOR CLARITY)
(SCALE- 1:50)

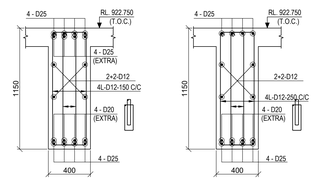

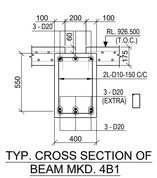

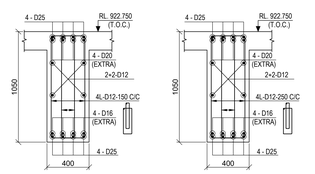



SCHEDULE OF BEAM REINFORCEMENT AT RL. 922.750


BEAM MKD.	SIZE	TOP REINFORCEMENT		BOTTOM REINFORCEMENT		STIRRUP	
		CONTINUOUS (a)	EXTRA (d)	CONTINUOUS (b)	EXTRA (c)	STIRRUP (s1)	STIRRUP (s2)
3FB3 & 3FB3A	350x650	3-D20	–	3-D20	–	2L-D10-150	2L-D10-250
3FB6	300x500	3-D20	3-D20	3-D16	3-D16	2L-D10-150	2L-D10-250
3B1	300x500	3-D16	3-D16	3-D20	–	2L-D10-150	2L-D10-250
3B2	300x800	4-D25	3-D16	3-D20	3-D16	2L-D10-150	2L-D10-250
3B3	440x750	4-D25	4-D25	4-D25	4-D25	4L-D10-150	4L-D10-250
3B4	300x550	3-D25	–	3-D25	3-D16	2L-D12-150	2L-D12-250
3B5	300x600	3-D20	–	3-D25	3-D16	2L-D10-150	2L-D10-250
3B6	300x600	3-D20	–	3-D25	3-D25	2L-D12-100	2L-D12-200
3B7	300x700	3-D16	–	3-D25	3-D25	2L-D10-150	2L-D10-250


SCHEDULE OF BEAM REINFORCEMENT AT RL. 926.500


BEAM MKD.	SIZE	TOP REINFORCEMENT		BOTTOM REINFORCEMENT		STIRRUP	
		CONTINUOUS (a)	EXTRA (d)	CONTINUOUS (b)	EXTRA (c)	STIRRUP (s1)	STIRRUP (s2)
4FB1	350x600	3-D25	2-D16	2-D25+1-D20	–	2L-D10-150	2L-D10-250
4FB2	350x600	3-D25	2-D16	2-D25+1-D20	–	2L-D10-150	2L-D10-250
4B1	400x550	3-D20	–	3-D20	3-D20	2L-D10-150	2L-D10-250
4B2	400x650	2-D25+1-D16	–	3-D25	3-D20	2L-D12-150	2L-D12-250

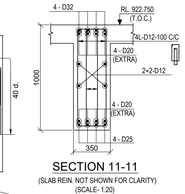


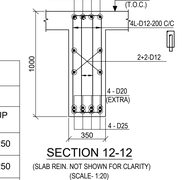


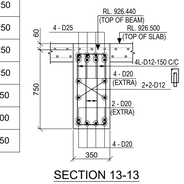


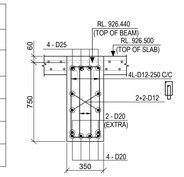


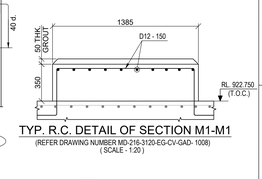


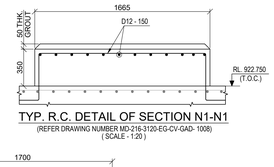


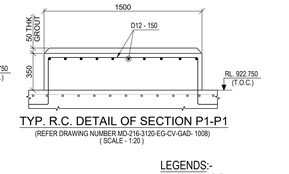


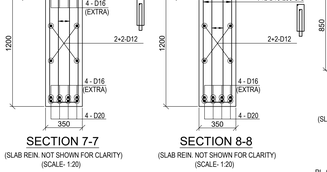


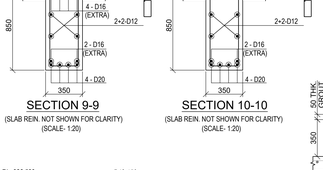


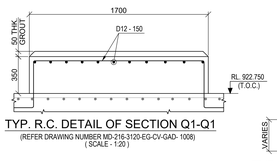


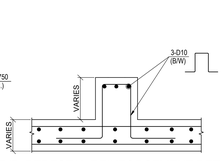

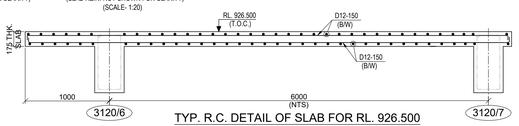

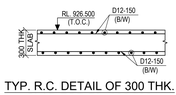

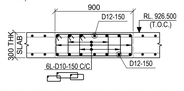

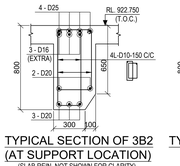

LEGENDS:-

R.L - REDUCED LEVEL
℄ - CENTRE LINE
C.J - CONSTRUCTION JOINT
FDN. - FOUNDATION
T.O.C. - TOP OF CONCRETE.
F.G.L - FINISHED GROUND LEVEL.
F.F.L - FINISHED FLOOR LEVEL.
B.O.F - BOTTOM OF FOUNDATION
TYP. - TYPICAL.
R.C. - REINFORCED CONCRETE
P.C.C - PLAIN CEMENT CONCRETE
MKD. - MARKED.
THK. - THICK
D - DIAMETER OF BAR
B/W - BOTH WAYS
Ld - DEVELOPMENT LENGTH
BOTTOM REINFORCEMENT (B) ——
TOP REINFORCEMENT (T) - - - -
ALTH - ALLTHROUGH
B/F - BOTHFACE
REINF. - REINFORCEMENT
NTS - NOT TO SCALE

NOTES :-

1. ALL DIMENSIONS ARE IN MILLIMETRES AND LEVELS AND CO-ORDINATES ARE IN METRES, UNLESS OTHERWISE STATED.
2. GRADE OF CONCRETE SHALL BE C35 FOR FOUNDATION.
3. GRADE OF REINFORCEMENT SHALL BE DEFORMED BAR ASTM-A615 - GRADE 60 (fy = 420 MPa).
4. NET SAFE BEARING CAPACITY OF SOIL AT BOTTOM OF FOUNDATION CONSIDERED 500KN/SQ. M.
5. CLEAR COVER TO MAIN REINFORCEMENT SHALL BE AS
   a) FOUNDATION = 75 mm (BOTTOM & SIDE) 50 mm. (TOP)
   b) COLUMN & PEDESTAL = 50mm
   c) BEAM = 50mm
   d) SLAB = 40mm
6. FOR MINIMUM LAP LENGTH OF REINFORCEMENT REFER STANDARD DRAWING NO. MD-216-1000-EG-CV-DED-1001
7. READ THIS DRAWING IN CONJUNCTION WITH DRG: MD-216-3120-EG-CV-DED-1005

REV	DATE	REVISION DESCRIPTION	DRN	CHK	ENG	APP	EMP
D01	10/03/2023	AS-BUILT	JKM	SBY	RPK/APL	AG	
C03	07/12/2020	ISSUED FOR CONSTRUCTION, REVISED AS MKD. (03)	JKM	SBY	RPK/APL	AG	
C02	12/08/2020	ISSUED FOR CONSTRUCTION, REVISED AS MKD. (02)	JKM	SBY	RPK/APL	AG	
C01	09/04/2020	ISSUED FOR CONSTRUCTION, REVISED AS PER EMPLOYER COMMENTS DATED 04/04/2020 & REVISED AS MKD. (01)	JKM	SBY	RPK/APL	AG	
A01	07/03/2020	ISSUED FOR REFERENCE	JKM	SBY	RPK/APL	AG	

DOCUMENT NUMBER	REFERENCE DOCUMENTS
MD-216-1000-EG-ST-CRT-1001	CIVIL,STRUCTURAL & ARCHITECTURAL DESIGN CRITERIA
MD-216-3120-EG-CV-GAD-1005-RA01	GAD,SCREEN BUILDING LAYOUT,FLLOR PLAN&DETAILS
MD-216-3120-EG-CV-GAD-1006-RA01	GAD,SCREEN BUILDING FLOOR PLANS & DETAILS
MD-216-3120-EG-CV-GAD-1008-RA01	GAD,SCREEN BUILDING SECTION & DETAILS

RESERVED FOR VENDOR LOGO AND DRAWING NUMBER

LARSEN & TOUBRO

This drawing is the property of LARSEN & TOUBRO and must not be passed on to any person or body not authorized by us to receive it nor be copied or otherwise made use either in full or in part by such person or body without our prior permission in writing.

Outotec

The content of these documents are the sole property of Outotec Oyj. Any rights not expressly granted herein are reserved. Reproduction, transfer or distribution of part or all of the contents in any form without prior written permission of Outotec is prohibited.

MA'ADEN معادن
Saudi Arabian Mining Company شركة المعادن العربية السعودية

This document and the information contained herein is Ma'aden proprietary know-how. This document or any part thereof should not be reproduced, stored in a retrieval system or transmitted by any means, electronic or otherwise, or divulged without prior written permission of Ma'aden.

LARSEN & TOUBRO DRAWING NUMBER	019045_100_C_D_24069_002
REVISION	4
OUTOTEC DRAWING NUMBER	900707__GAU01__ZC01__CTB17__31203
DOCUMENT ID	OU100671388
REVISION	4
DRAWN	JKM 29/02/2020
CHECKED	SBY 05/03/2020
ENGINEER	RPK/APL 04/03/2020
APPROVED	AG 07/03/2020
EMPLOYER	
SCALE	1:100,50,25,20
	A0

MANSOURAH - MASSARAH GOLD PROJECT
DETAIL DRAWING
SCREEN BUILDING
RC DETAILS OF BEAM & SLABS

DRAWING NUMBER	REV
MD-216-3120-EG-CV-DED-1006	D01