

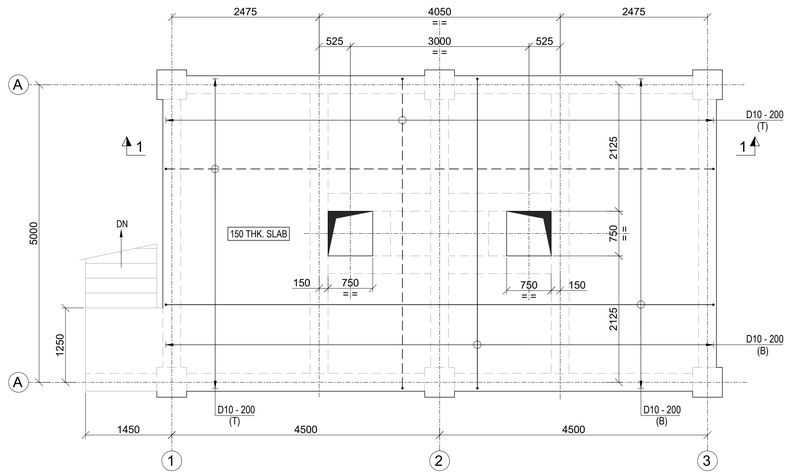



R.C DETAIL OF SLAB AT RL. 914.750 (T.O.C)
(SCALE-1:50)

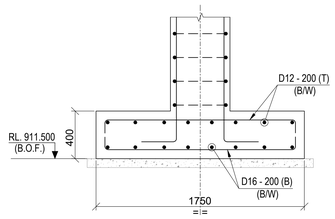


SECTION 2-2
(SCALE-1:25)

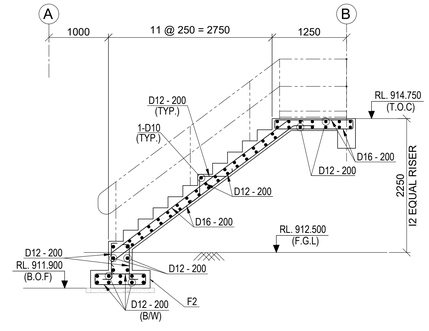


R.C DETAIL OF SECTION A-A
(SCALE 1:50)

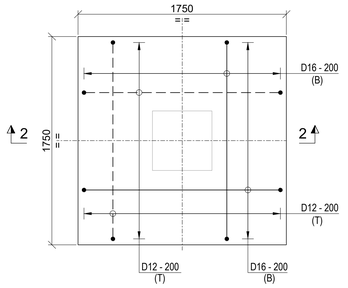


R.C DETAIL OF FOUNDATION - F1
(SCALE 1:25)

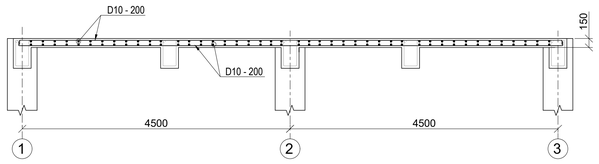


SECTION 1-1
(BEAM REINFORCEMENTS ARE NOT SHOWN FOR CLARITY)
(SCALE-1:50)

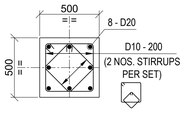


R.C DETAIL OF COLUMN - C1
(SCALE 1:25)

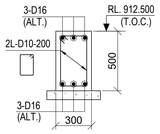


TYP. CROSS SECTION OF
BEAM MKD. TB1 & TB2
(SCALE- 1:25)

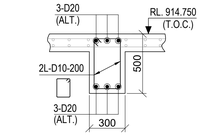


TYP. CROSS SECTION OF
BEAM MKD. FB1
(SCALE- 1:25)

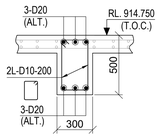

TYP. CROSS SECTION OF
BEAM MKD. FB2
(SCALE- 1:25)

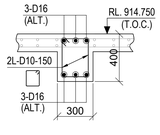

TYP. CROSS SECTION OF
BEAM MKD. B1
(SCALE- 1:25)

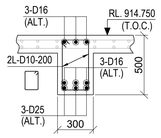

TYP. CROSS SECTION OF
BEAM MKD. B2
(SCALE- 1:25)

LEGEND :-

R.L. - REDUCED LEVEL
T.O.C. - TOP OF CONCRETE.
F.G.L. - FINISHED GROUND LEVEL.
F.F.L. - FINISHED FLOOR LEVEL.
B.O.F. - BOTTOM OF FOUNDATION
TYP. - TYPICAL.
R.C. - REINFORCED CONCRETE
P.C.C - PLAIN CEMENT CONCRETE
MKD. - MARKED.
THK. - THICK
ALT. - ALL THROUGH
EXT. - EXTRA
B/W - BOTH WAYS
BOTTOM REINFORCEMENT (B) - ————
TOP REINFORCEMENT (T) - – – – – – –

NOTES :-

1. ALL DIMENSIONS ARE IN MILLIMETRES AND LEVELS AND CO-ORDINATES ARE IN METRES. UNLESS OTHERWISE STATED.
2. GRADE OF CONCRETE SHALL BE C35 FOR FOUNDATION.
3. GRADE OF REINFORCEMENT SHALL BE DEFORMED BAR ASTM A615 - GRADE 60 (fy = 420 MPa).
4. NET SAFE BEARING CAPACITY OF SOIL AT BOTTOM OF FOUNDATION CONSIDERED 600KN/SQ. M.
5. CLEAR COVER TO MAIN REINFORCEMENT SHALL BE AS FOLLOWS
   a) FOUNDATION = 75 mm (BOTTOM & SIDE) 50 mm. (TOP)
   b) COLUMN = 50mm
   c) BEAM = 50mm
   d) SLAB = 40mm
6. FOR MINIMUM LAP LENGTH OF REINFORCEMENT REFER STANDARD DRAWING NO. MD-216-1000-EG-CV-DED-1005
7. READ THIS DRAWING IN CONJUNCTION WITH DRAWING NUMBER : MD-216-3120-EG-CV-DAD-1010

DOCUMENT NUMBER	REFERENCE DOCUMENTS	REV	DATE	REVISION DESCRIPTION	DRN	CHK	ENG	APP	EMP
		D01	10/03/2023	AS-BUILT	JKM	SBY	RPK	PRI	
		C01	09/04/2021	REVISED AS PER EMPLOYER COMMENTS DATED 05/04/2021 & ISSUED FOR CONSTRUCTION & REVISED AS MARKED C01	JKM	SBY	RPK	PRI	
		A01	10/03/2021	ISSUED FOR REVIEW	JKM	SBY	RPK	PRI	

RESERVED FOR VENDOR LOGO AND DRAWING NUMBER

LARSEN & TOUBRO

This drawing is the property of LARSEN & TOUBRO and must not be passed on to any person or body not authorized by us to receive it nor be copied or otherwise made use either in full or in part by such person or body without our prior permission in writing.

Outotec

The content of these documents are the sole property of Outotec Oyj. Any rights not expressly granted herein are reserved. Reproduction, transfer or distribution of part or all of the contents in any form without prior written permission of Outotec is prohibited.

MA'ADEN معادن
Saudi Arabian Mining Company شركة معادن العربية السعودية

This document and the information contained herein is Ma'aden proprietary know-how. This document or any part thereof should not be reproduced, stored in a retrieval system or transmitted by any means, electronic or otherwise, or divulged without prior written permission of Ma'aden.

LARSEN & TOUBRO DRAWING NUMBER: O19045_100_C_D_24601_001 — REVISION: 2
OUTOTEC DRAWING NUMBER: 900707__GAU01__ZC01__CTB05__31201 — DOCUMENT ID: OU100712930 — REVISION: 2

DRAWN	JKM	06/03/2021
CHECKED	SBY	09/03/2021
ENGINEER	RPK	05/03/2021
APPROVED	PRI	10/03/2021
EMPLOYER		
SCALE	1:50,25	A1

MANSOURAH - MASSARAH GOLD PROJECT
DETAIL DRAWING
CONE CRUSHER MAIN SHAFT MAINTENANCE PLATFORM
REINFORCEMENT DETAILS

DRAWING NUMBER: MD-216-3120-EG-CV-DED-1008 — REV: D01