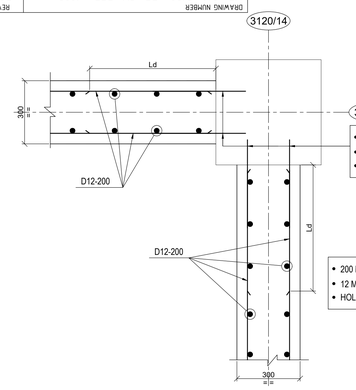
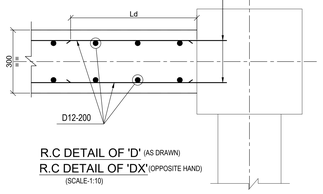
DRAWING NUMBER MD-216-3120-EG-CV-DED-1009 REV D01



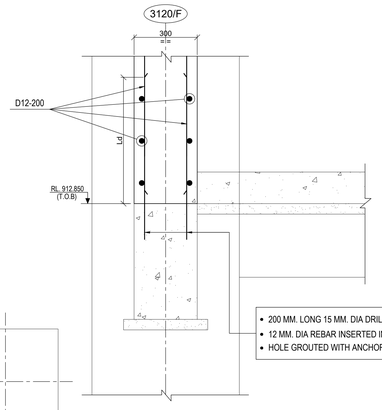

- 200 MM. LONG 15 MM. DIA DRILLED HOLE.
- 12 MM. DIA REBAR INSERTED IN HOLE. MINIMUM (Ld) PROJECTION FOR REBAR LAPPING.
- HOLE GROUTED WITH ANCHORING CHEMICAL (AS PER MANUFACTURER'S SPECIFICATION).

DETAIL-A
(SCALE-1:10)





- 200 MM. LONG 15 MM. DIA DRILLED HOLE.
- 12 MM. DIA REBAR INSERTED IN HOLE. MINIMUM (Ld) PROJECTION FOR REBAR LAPPING.
- HOLE GROUTED WITH ANCHORING CHEMICAL (AS PER MANUFACTURER'S SPECIFICATION).

R.C DETAIL OF 'D' (AS DRAWN)
R.C DETAIL OF 'DX' (OPPOSITE HAND)
(SCALE-1:10)




- 200 MM. LONG 15 MM. DIA DRILLED HOLE.
- 12 MM. DIA REBAR INSERTED IN HOLE. MINIMUM (Ld) PROJECTION FOR REBAR LAPPING.
- HOLE GROUTED WITH ANCHORING CHEMICAL (AS PER MANUFACTURER'S SPECIFICATION).

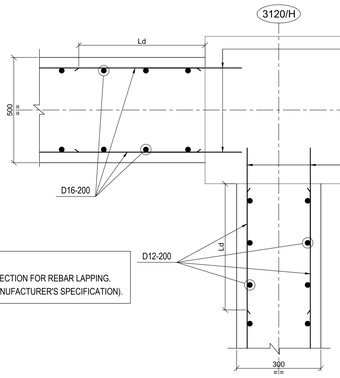DETAIL-B
(SCALE-1:10)





- 240 MM. LONG 20 MM. DIA DRILLED HOLE.
- 16 MM. DIA REBAR INSERTED IN HOLE. MINIMUM (Ld) PROJECTION FOR REBAR LAPPING.
- HOLE GROUTED WITH ANCHORING CHEMICAL (AS PER MANUFACTURER'S SPECIFICATION).


- 200 MM. LONG 15 MM. DIA DRILLED HOLE.
- 12 MM. DIA REBAR INSERTED IN HOLE. MINIMUM (Ld) PROJECTION FOR REBAR LAPPING.
- HOLE GROUTED WITH ANCHORING CHEMICAL (AS PER MANUFACTURER'S SPECIFICATION).

SECTION Z3-Z3
(SCALE-1:10)

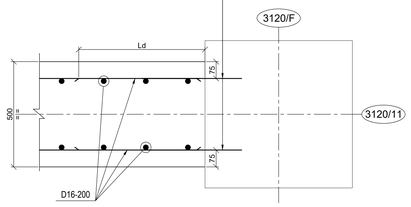- 240 MM. LONG 20 MM. DIA DRILLED HOLE.
- 16 MM. DIA REBAR INSERTED IN HOLE. MINIMUM (Ld) PROJECTION FOR REBAR LAPPING.
- HOLE GROUTED WITH ANCHORING CHEMICAL (AS PER MANUFACTURER'S SPECIFICATION).





SECTION Z4-Z4
(SCALE-1:10)

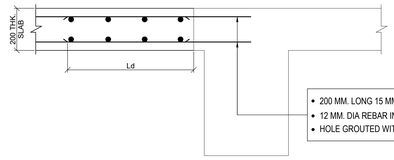



- 200 MM. LONG 15 MM. DIA DRILLED HOLE.
- 12 MM. DIA REBAR INSERTED IN HOLE. MINIMUM (Ld) PROJECTION FOR REBAR LAPPING.
- HOLE GROUTED WITH ANCHORING CHEMICAL (AS PER MANUFACTURER'S SPECIFICATION).

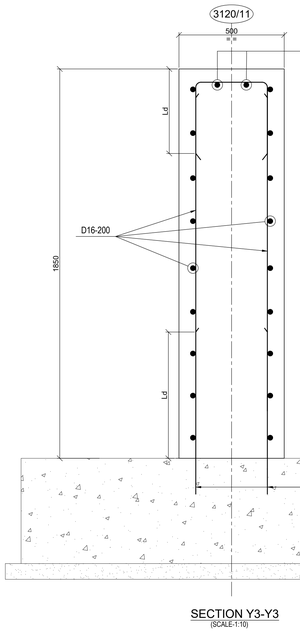SECTION Z-Z
(R.C.C DETAILS)
(SCALE-1:10)





SECTION Y3-Y3
(SCALE-1:10)

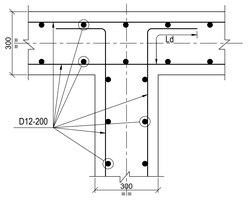



DETAIL-C
(SCALE-1:10)

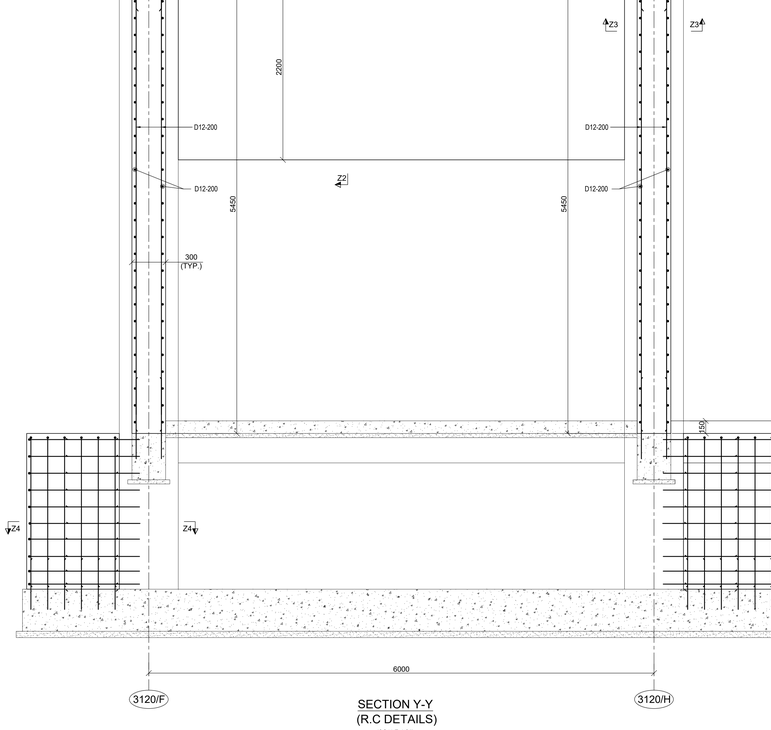
- 240 MM. LONG 20 MM. DIA DRILLED HOLE.
- 16 MM. DIA REBAR INSERTED IN HOLE. MINIMUM (Ld) PROJECTION FOR REBAR LAPPING.
- HOLE GROUTED WITH ANCHORING CHEMICAL (AS PER MANUFACTURER'S SPECIFICATION).





SECTION Y-Y
(R.C DETAILS)
(SCALE-1:25)

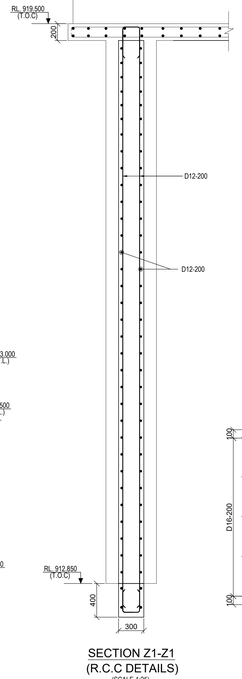

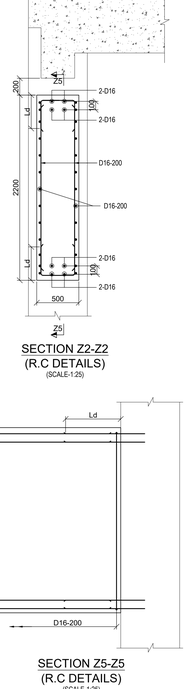

SECTION Z1-Z1
(R.C.C DETAILS)
(SCALE-1:25)



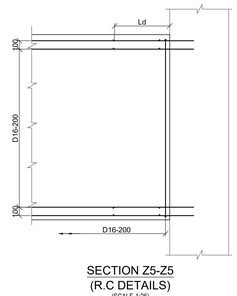

SECTION Z2-Z2
(R.C DETAILS)
(SCALE-1:25)



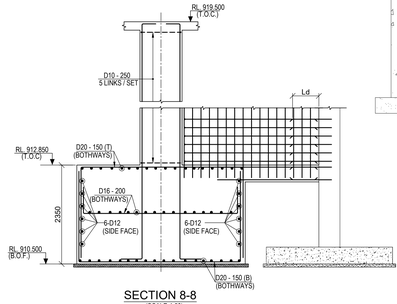

SECTION Z5-Z5
(R.C DETAILS)
(SCALE-1:25)





SECTION 8-8
(SCALE-1:50)

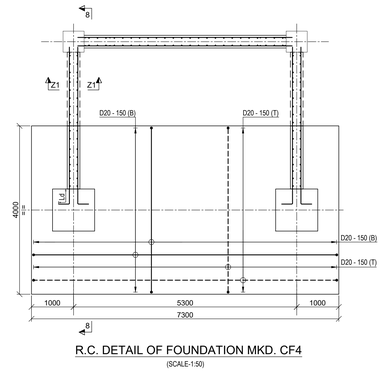

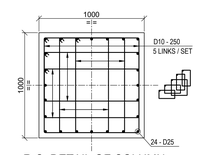

R.C. DETAIL OF FOUNDATION MKD. CF4
(SCALE-1:50)



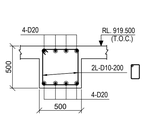

R.C. DETAIL OF COLUMN
MKD. C3
SCALE 1:20



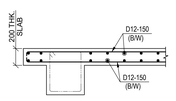
TYP. CROSS SECTION OF
BEAM MKD. NB1
(SLAB REIN. NOT SHOWN FOR CLARITY)
(SCALE- 1:25)



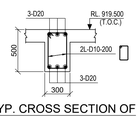
TYP. R.C. DETAIL OF ROOF SLAB
(BEAM REIN. NOT SHOWN FOR CLARITY)
(SCALE- 1:25)




TYP. CROSS SECTION OF
BEAM MKD. NB2
(SLAB REIN. NOT SHOWN FOR CLARITY)
(SCALE- 1:25)

LEGENDS :-
RL - REDUCED LEVEL
T.O.C. - TOP OF CONCRETE
F.G.L - FINISHED GROUND LEVEL
F.F.L - FINISHED FLOOR LEVEL
B.O.F - BOTTOM OF FOUNDATION
TYP. - TYPICAL
R.C.C - REINFORCED CEMENT CONCRETE
P.C.C - PLAIN CEMENT CONCRETE
THK. - THICK
D - DIAMETER OF BAR
B/W - BOTH WAYS
BOTTOM REINFORCEMENT (B) : ———
TOP REINFORCEMENT (T) : - - - - - -

NOTES :-
1. ALL DIMENSIONS ARE IN MILLIMETRES AND LEVELS ARE IN METRES.
2. GRADE OF CONCRETE SHALL BE C35.
4. GRADE OF REINFORCEMENT SHALL BE DEFORMED BAR ASTM A615 - GRADE 60 (fy = 420 MPa).
5. NET SAFE BEARING CAPACITY OF SOIL AT BOTTOM OF FOUNDATION CONSIDERED 500KN/SQ. M.
6. CLEAR COVER TO MAIN REINFORCEMENT SHALL BE AS
   a) FOUNDATION = 75 mm (BOTTOM & SIDE) 50 mm. (TOP)
   b) COLUMN & PEDESTAL = 50mm
   c) BEAM = 50mm
   d) SLAB = 40mm
   e) WALL = 40 mm ABOVE F.G.L & 75 mm BELOW F.G.L
7. MINIMUM LAP LENGTH OF REINFORCEMENT SHALL BE 40 X DIA. OF BAR.
8. QUICK SETTING ADMIXTURE SHALL BE USED FOR REDUCING THE SETTING TIME OF THE CONCRETE.
9. DO NOT SCALE. PLEASE ASK.

| REV | DATE | REVISION DESCRIPTION | DRN | CHK | ENG | APP | EMP |
|---|---|---|---|---|---|---|---|
| D01 | 14/02/2024 | AS-BUILT | HSK | SBY | APR | AG | |
| C01 | 10/10/2023 | ISSUED FOR CONSTRUCTION | JKM | SBY | APR | AG | |
| A02 | 14/10/2022 | REVISED AS PER EMPLOYER COMMENTS DATED 06/06/2022 | SYA | SBY | APR | AG | |
| A01 | 28/04/2022 | ISSUED OF APPROVAL | SYA | SBY | APR | AG | |

| DOCUMENT NUMBER | REFERENCE DOCUMENTS |
|---|---|
| MD-216-3120-EG-CV-GAD-1011 | MODIFICATION OF CRUSHER SUPPORT STRUCTURE |

RESERVED FOR VENDOR LOGO AND DRAWING NUMBER

LARSEN & TOUBRO

This drawing is the property of LARSEN & TOUBRO and must not be passed on to any person or body not authorized by us to receive it nor be copied or otherwise made use either in full or in part by such person or body without our prior permission in writing.

Outotec

The content of these documents are the sole property of Outotec Oyj. Any rights not expressly granted herein are reserved. Reproduction, transfer or distribution of part or all of the contents in any form without prior written permission of Outotec is prohibited.

MA'ADEN معادن
Saudi Arabian Mining Company شركة معادن العربية السعودية

This document and the information contained herein is Ma'aden proprietary know-how. This document or any part thereof should not be reproduced, stored in a retrieval system or transmitted by any means, electronic or otherwise, or divulged without prior written permission of Ma'aden.

| | | | |
|---|---|---|---|
| LARSEN & TOUBRO DRAWING NUMBER | 019045_100_C_G_24770_001 | | REVISION 3 |
| OUTOTEC DRAWING NUMBER | 900707 _ GAU01 _ ZC01 _ CTB17 _ 31234 | DOCUMENT ID OU100754100 | REVISION 3 |
| DRAWN | SYA | 18/04/2022 | MANSOURAH - MASSARAH GOLD PROJECT |
| CHECKED | SBY | 20/04/2022 | GENERAL ARRANGEMENT DRAWING |
| ENGINEER | APR | 25/04/2022 | SECONDARY CRUSHING |
| APPROVED | AG | 28/04/2022 | R.C DETAILS OF ADDITIONAL FOUNDATION & WALL |
| EMPLOYER | | | |
| SCALE 1:50,1:25,1:10 | | A0 | DRAWING NUMBER MD-216-3120-EG-CV-DED-1009 REV D01 |