


DRAWING NUMBER: MD-216-49WF-EG-CV-DED-2001 | REV: D01

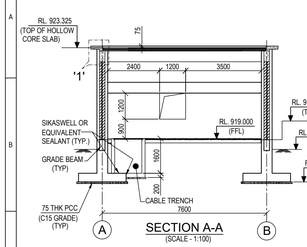


SECTION A-A
(SCALE - 1:100)

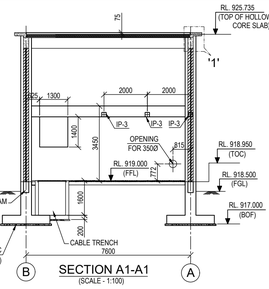


SECTION A1-A1
(SCALE - 1:100)

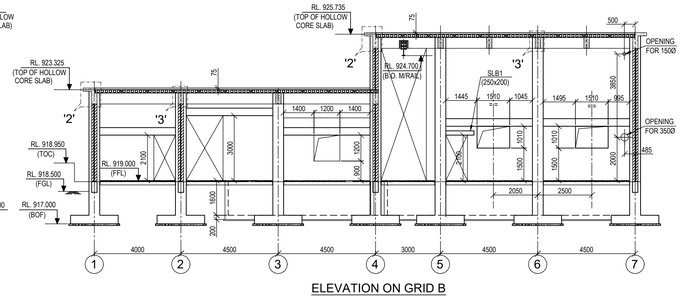


ELEVATION ON GRID B
SECTION B-B
(SCALE - 1:100)

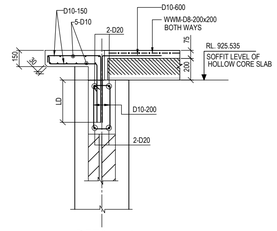


DETAIL - 1
RC DETAIL OF RB1
(SCALE - 1:20)

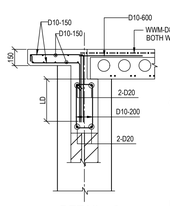


DETAIL - 2
RC DETAIL OF RB1
(SCALE - 1:20)

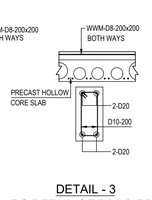


DETAIL - 3
RC DETAIL OF RB2 & RB3
(SCALE - 1:20)

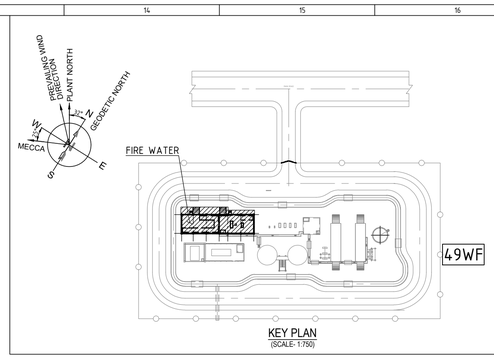


KEY PLAN
(SCALE- 1:750)

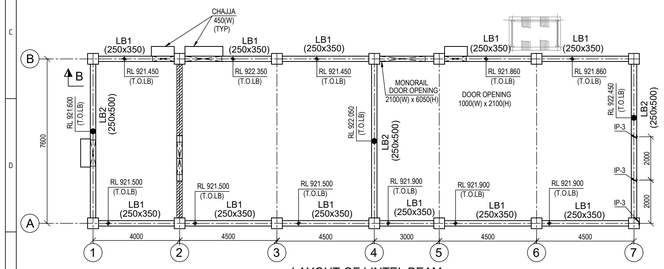

LAYOUT OF LINTEL BEAM
(SCALE - 1:100)

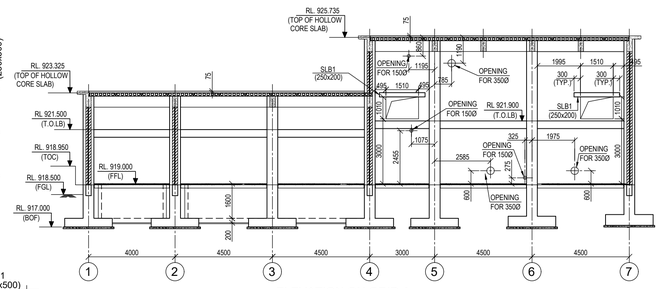

ELEVATION ON GRID A
(SCALE - 1:100)

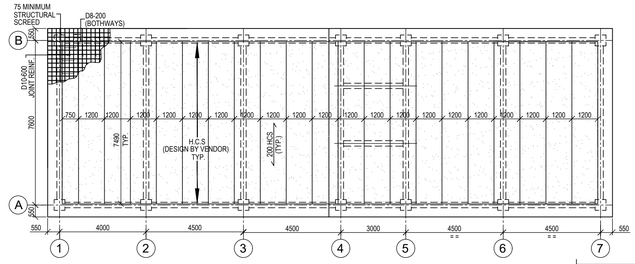


ROOF HOLLOW CORE SLAB LAYOUT
(SCALE - 1:100)


SCHEDULE OF MEMBERS

MEMBER MKD.	MEMBER	SECTION	FACTORED AXIAL FORCE(TON)	FACTORED SHEAR FORCE(TON)	REMARKS
a	L 65X65X6	L	-	-	
MR1	IPE300	I	-	-	
MR2	IPE300	I	-	-	


1. ALL GUSSET PLATES ARE 8mm THK.
2. FOR DEVELOPING CONNECTIONS MEMBER END FORCES MENTIONED IN SCHEDULE OF MEMBERS SHALL BE FOLLOWED.
3. MINIMUM 6mm FILLET WELD OF 150 mm LENGTH SHALL BE PROVIDED FOR WELDED CONNECTION.
4. FOR BOLTED CONNECTION, MINIMUM 2 Nos. M20 BOLTS SHALL BE PROVIDED.
5. ALL STRUCTURAL WORK SHALL CONFIRM TO CIVIL STRUCTURAL DESIGN CRITERIA NO. MD-216-1000-EG-ST-CRT-1001.
6. GRADE OF STEEL USED IS S275R AS PER EN10025.
7. ALL CONNECTIONS ARE WITH ASTM A325 GRADE BOLTS.

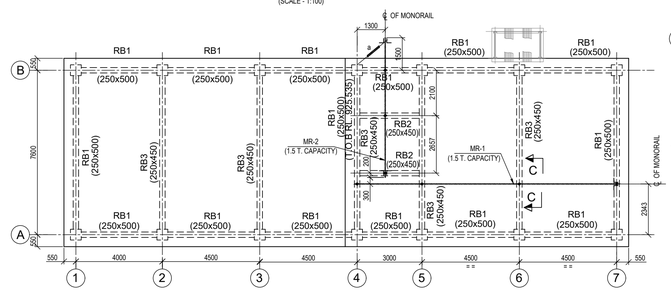


LAYOUT OF ROOF BEAM & HOLLOW CORE SLAB
(SCALE - 1:100)

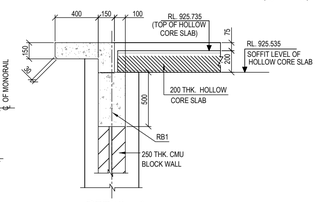


DETAIL - 1
(SCALE - 1:20)

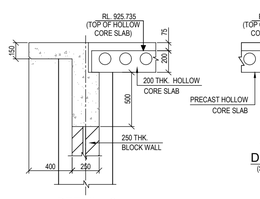


DETAIL - 2
(SCALE - 1:20)

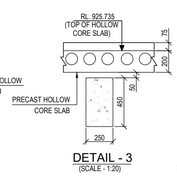


DETAIL - 3
(SCALE - 1:20)

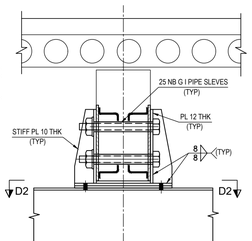


SECTION D1-D1
(SCALE - 1:10)

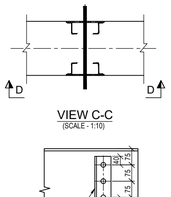


VIEW C-C
(SCALE - 1:10)

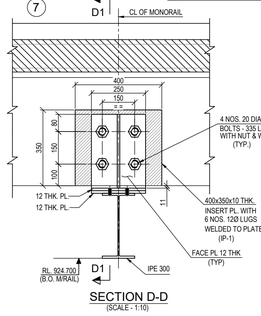


SECTION D-D
(SCALE - 1:10)

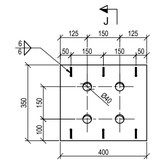


DETAIL OF IP-1
(SCALE - 1:10)

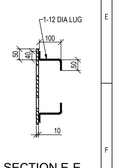


SECTION E-E
(SCALE - 1:10)

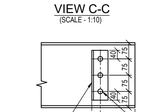


DETAIL OF STOPER CLT FIXING
(SCALE - 1:10)

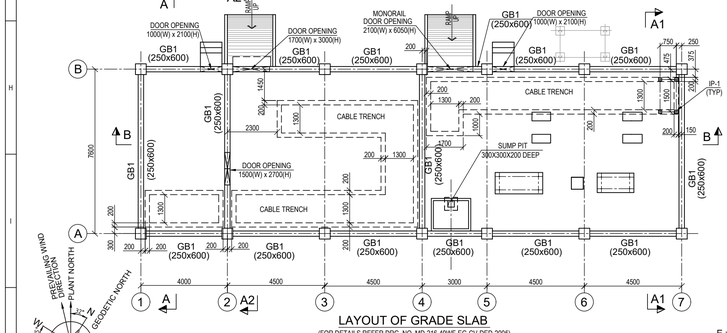

LAYOUT OF GRADE SLAB
(FOR DETAILS REFER DRG. NO. MD-216-49WF-EG-CV-DED-2005)

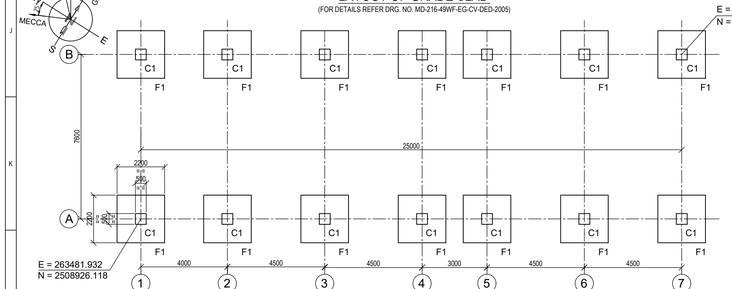


LAYOUT OF FOUNDATION
(SCALE - 1:100)

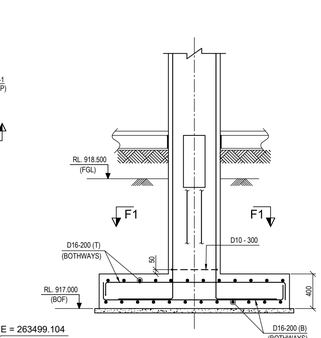


SECTION F1-F1
RC DETAIL OF COLUMN MKD C1
(SCALE = 1:25)


SECTION F-F
(SCALE - 1:25)

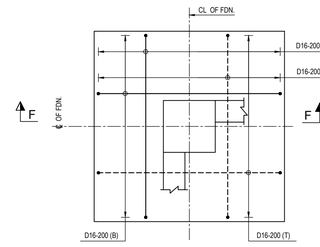


RCC DETAIL OF FOUNDATION MKD F1
(SCALE - 1:25)

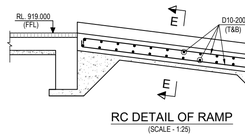

RC DETAIL OF RAMP
(SCALE - 1:25)

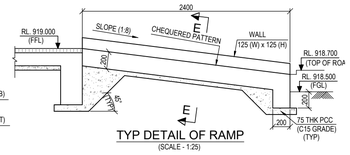


TYP DETAIL OF RAMP
(SCALE - 1:25)

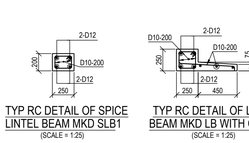


TYP RC DETAIL OF SPICE LINTEL BEAM MKD SLB1
(SCALE = 1:25)


TYP RC DETAIL OF LINTEL BEAM MKD LB WITH CHAJJA
(SCALE = 1:25)

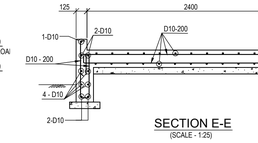

SECTION E-E
(SCALE - 1:25)

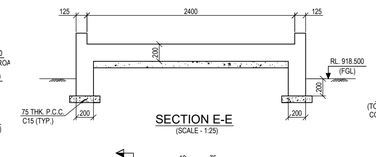


SECTION E-E
(SCALE - 1:25)

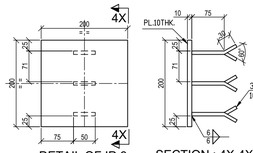


DETAIL OF IP-3
SCALE - 1:5


SECTION : 4X-4X
SCALE - 1:5

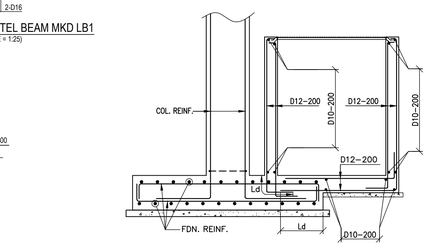


TYP. R.C DETAILS OF FDN. & TRENCH JUNCTION
(SCALE - 1:50)

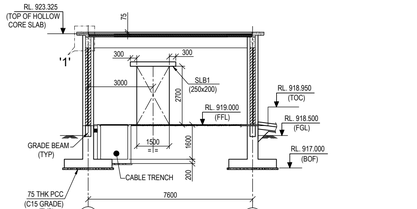


SECTION A2-A2
(SCALE - 1:100)

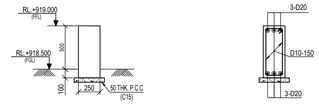


TYP DETAIL OF GRADE BEAM MKD GB1
(SCALE = 1:25)

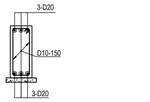

RC DETAIL OF GRADE BEAM MKD GB1
(SCALE = 1:25)

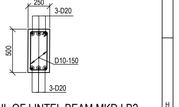

RC DETAIL OF LINTEL BEAM MKD LB2
(SCALE = 1:25)

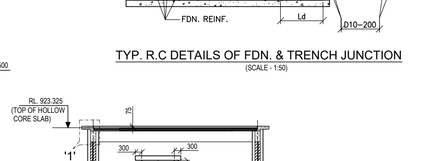

SECTION A2-A2
(SCALE - 1:100)

SECTION : 4X-4X
SCALE - 1:5

RC DETAIL OF LINTEL BEAM MKD LB1
(SCALE = 1:25)

LEGENDS :

TOC - TOP OF CONCRETE	
RL - REDUCED LEVEL	
TYP - TYPICAL	
PCC - PLAIN CEMENT CONCRETE	FFL - FINISHED FLOOR LEVEL
MKD - MARKED	CLT - CLEAT
C - COLUMN	MRAIL - MONORAIL
FDN. - FOUNDATION	FW - FIRE WATER
BOF - BOTTOM OF FOUNDATION	ELEC - ELECTRICAL
CL - CENTRE LINE	PL - PLATE
RC - REINFORCED CONCRETE	H - HEIGHT
DRG - DRAWING	W - WIDTH
FGL - FINISHED GROUND LEVEL	B. O. - BOTTOM OF
WWM - WELDED WIRE MESH	DIA - DIAMETER
BOF - BOTTOM OF FOUNDATION	LG. - LONG
	SLB. - SPICE LINTEL BEAM
	LB. - LINTEL BEAM
	COL. - COLUMN

NOTES :-

1. ALL DIMENSIONS ARE IN MILLIMETRES AND LEVELS AND CO-ORDINATES ARE IN METRES UNLESS OTHERWISE STATED.
2. GRADE OF CONCRETE SHALL BE 35MPa FOR RCC AND 15 MPa FOR BLINDING CONCRETE.
3. GRADE OF REINFORCEMENT SHALL BE DEFORMED BAR MPa (GRADE 60) - ASTM M615/fy=420Mpa.
4. NET SAFE BEARING CAPACITY OF SOIL AT BOTTOM OF FOUNDATION IS CONSIDERED AS 300 KN/m.²
5. CLEAR COVER TO REINFORCEMENT SHALL BE AS
   a). FOUNDATION = 50mm.
   b). COLUMN = 40mm.
   c). BEAM = 40mm.
   d). SLAB = 25mm.
6. FOR GENERAL NOTES & MINIMUM LAP LENGTH OF REINFORCEMENT REFER DRG. NO. MD-216-1000-EG-CV-DED-1001.
7. IF ANY PART OF FOUNDATION COMES ON BACKFILL ZONE OF ADJACENT FOUNDATION OR ANY LOOSE SOIL ARE ENCOUNTERED BELOW FOUNDATION LEVEL THE SAME SHALL BE REMOVED AND FILLED WITH PCC.
8. FOR STANDARD DETAILS OF ANCHOR BOLTS REFER DRG. NO. MD-216-1000-EG-CV-DED-1003.
9. THE CONTENT OF THIS DRAWING SHALL CONFORM TO THE PROVISIONS OF CIVIL, STRUCTURAL & ARCHITECTURAL DESIGN CRITERIA DOCUMENT NO. MD-216-1000-EG-ST-CRT-1001.
10. THIS DRAWING IS TO BE READ IN CONJUNCTION WITH DRAWING NO - MD-216-49WF-EG-CV-DED-2005
11. DETAIL OF IP-2 IS COVERED IN DRG. NO. MD-216-49WF-EG-CV-DED-2005.

DOCUMENT NUMBER	REFERENCE DOCUMENTS	REV	DATE	REVISION DESCRIPTION	DRN	CHK	ENG	APP	EMP
		D01	17/02/2023	AS-BUILT	SYA	SJM	BJB	AG	
		C07	04/09/2021	ISSUED FOR CONSTRUCTION AND REVISED AS MKD 49	SYA	SJM	BJB	AG	
	39LA-EG-AR-GAD-3226	C06	19/05/2021	ISSUED FOR CONSTRUCTION AND REVISED AS MKD 49	DSR	SJM	BJB	AG	
	39LA-EG-AR-GAD-3225	C05	10/05/2021	ISSUED FOR CONSTRUCTION AND REVISED AS MKD 49	DSR	SJM	BJB	AG	
MD-216-39LA-EG-FG-LAD-V513-2230		C04	27/04/2021	ISSUED FOR CONSTRUCTION AND REVISED AS MKD 49	DSR	SJM	BJB	AG	
MD-216-39LA-EG-FG-SED-V513-2013		C03	21/04/2021	ISSUED FOR CONSTRUCTION AND REVISED AS MKD 49	DSR	SJM	BJB	AG	
MD-216-39LA-EG-FG-GAD-V513-2004		C02	04/02/2021	ISSUED FOR CONSTRUCTION AND REVISED AS MKD 49	ANI	SJM	BJB	AG	
MD-216-49WF-EG-EL-LAD-1012		C01	04/01/2021	ISSUED FOR CONSTRUCTION AND REVISED AS PER EMPLOYER'S.	DSR	SJM	BJB	AG	
MD-216-49WF-EG-EL-LAD-1011				COMMENT ON 28.10.2020 & REVISED AS MKD 49					
MD-216-49WF-EG-CV-DED-2005	FW PUMP HOUSE & ELEC. BLDG. GROUND FLOOR DETAIL	A01	15/10/2020	ISSUED FOR REFERENCE	DSR	SJM	BJB	AG	

DOCUMENT NUMBER	REFERENCE DOCUMENTS	REV	DATE	REVISION DESCRIPTION	DRN	CHK	ENG	APP	EMP

RESERVED FOR VENDOR LOGO AND DRAWING NUMBER

LARSEN & TOUBRO

This drawing is the property of LARSEN & TOUBRO and must not be passed on to any person or body not authorized by us to receive it nor be copied or otherwise made use either in full or in part by such person or body without our prior permission in writing.

Outotec

The content of these documents are the sole property of Outotec Oyj. Any rights not expressly granted herein are reserved. Reproduction, transfer or distribution of part or all of the contents in any form without prior written permission of Outotec is prohibited.

MA'ADEN معادن Saudi Arabian Mining Company

This document and the information contained herein is Ma'aden proprietary know-how. This document or any part thereof should not be reproduced, stored in a retrieval system or transmitted by any means, electronic or otherwise, or divulged without prior written permission of Ma'aden.

LARSEN & TOUBRO DRAWING NUMBER			REVISION
019045_080_C_D_24372_001			8
OUTOTEC DRAWING NUMBER		DOCUMENT ID	REVISION
900707__GAU01__AG32__CTB01__53001		0U100691533	8
DRAWN	DSR	01/10/2020	MANSOURAH - MASSARAH GOLD PROJECT
CHECKED	SJM	04/10/2020	DETAIL DRAWING
ENGINEER	BJB	01/10/2020	POTABLE WATER TREATMENT PLANT
APPROVED	AG	15/10/2020	FW PUMP HOUSE & ELEC. BUILDING DETAIL
EMPLOYER			
SCALE 1:100, 25, 20, 10	A0	DRAWING NUMBER MD-216-49WF-EG-CV-DED-2001	REV D01