


DRAWING NUMBER: MD-216-49WF-EG-CV-DED-2002 REV D01

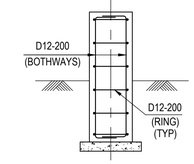


RC DETAIL OF PUMP FOUNDATION MKD PF1
(2 NOS. THUS)
(SCALE - 1:25)

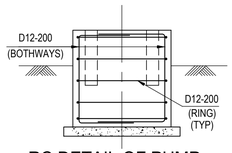


RC DETAIL OF PUMP FOUNDATION MKD PF2
(2 NOS. THUS)
(SCALE - 1:25)

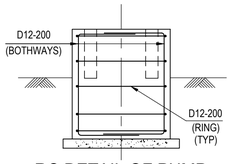


RC DETAIL OF PUMP FOUNDATION MKD PF3
(2 NOS. THUS)
(SCALE - 1:25)

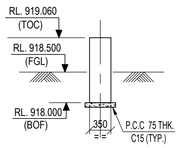


SECTION C-C
(SCALE - 1:50)

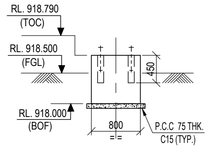


SECTION D-D
(SCALE - 1:50)

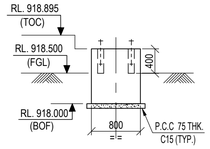


SECTION E-E
(SCALE - 1:50)

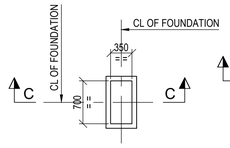


DETAIL OF PUMP FOUNDATION MKD PF1
(2 NOS. THUS)
(SCALE - 1:50)

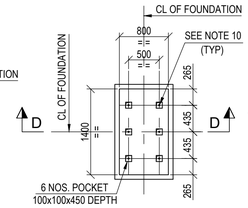


DETAIL OF PUMP FOUNDATION MKD PF2
(2 NOS. THUS)
(SCALE - 1:50)

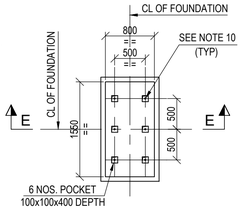


DETAIL OF PUMP FOUNDATION MKD PF3
(2 NOS. THUS)
(SCALE - 1:50)

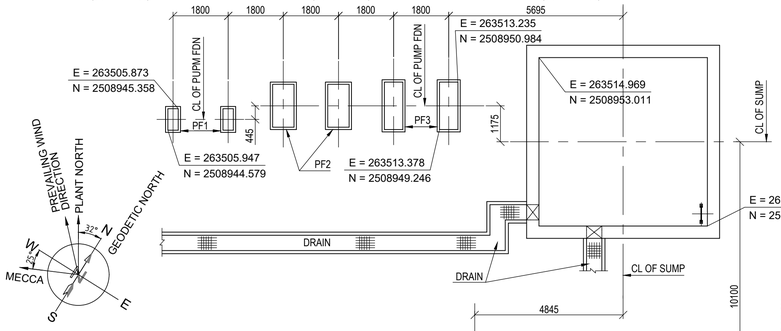


LAYOUT OF SUMP & PUMP FOUNDATION
(SCALE - 1:100)

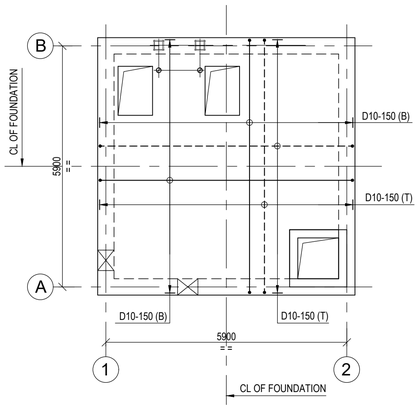


RCC DETAIL OF PWTP SUMP TOP SLAB LEVEL
(SCALE - 1:75)

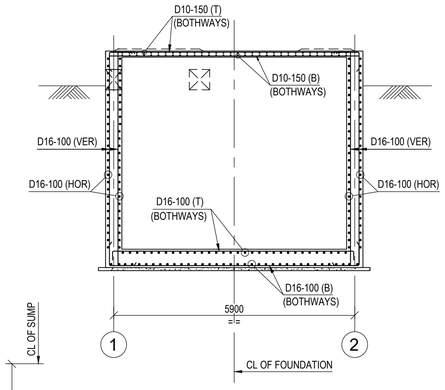


SECTION A - A
(SCALE - 1:75)

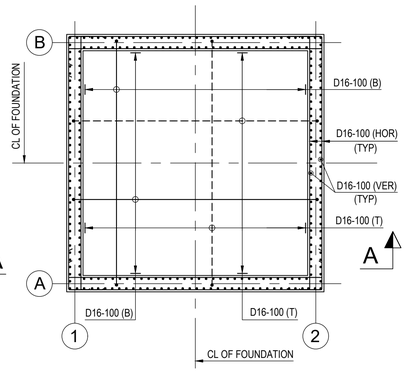


RC DETAIL OF PWTP SUMP FOUNDATION LEVEL
(SCALE - 1:75)

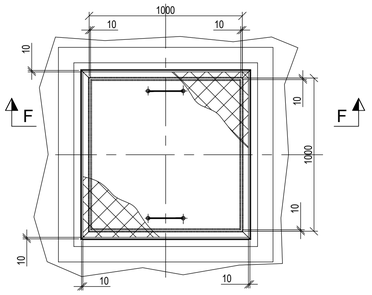


TYP DETAIL OF MANHOLE COVER
(SCALE - 1:20)

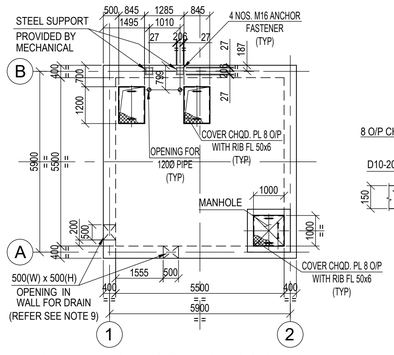


PLAN AT PWTP SUMP TOP SLAB LEVEL
(SCALE - 1:100)

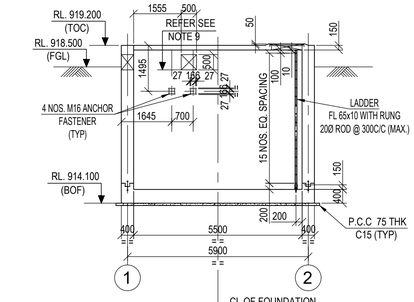


SECTION B - B
(SCALE - 1:100)

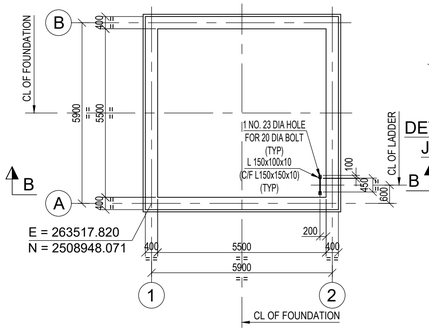


PLAN AT PWTP SUMP FOUNDATION LEVEL
(SCALE - 1:100)

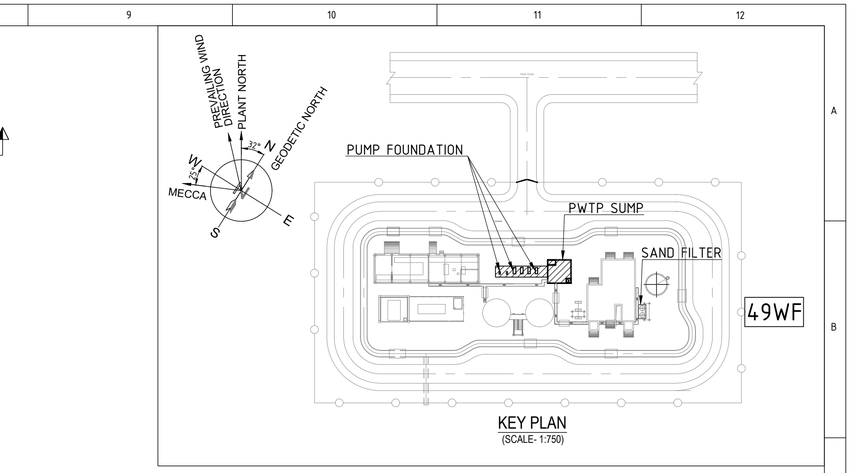


KEY PLAN
(SCALE- 1:750)

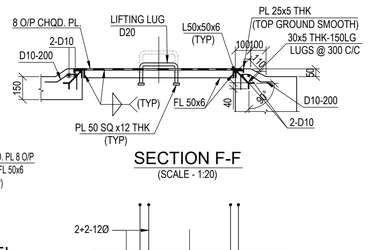


SECTION F-F
(SCALE - 1:20)

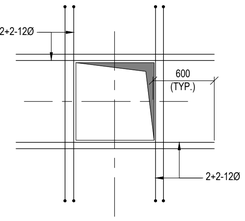

TYPICAL DETAIL OF EXTRA REINFORCEMENT FOR OPENING IN TOP SLAB
(BAR ON SLAB {RC} SHALL BE BENT IN SLAB TO GET DEVELOPMENT LENGTH)
(SCALE - 1:30)

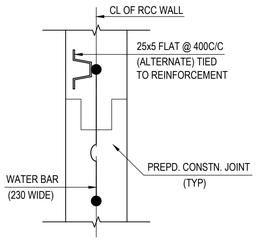

DETAIL OF CONSTRUCTION JOINT & WATER BAR
(SCALE - 1:20)

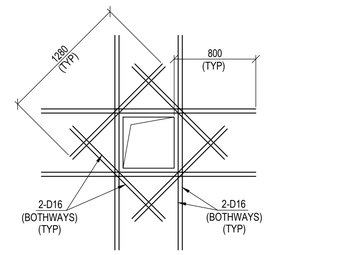

ADDITIONAL REINFORCEMENT AROUND CUTOUT FOR WALL OPENING
(SCALE - 1:30)

LEGENDS :

TOC - TOP OF CONCRETE	FDN - FOUNDATION
RL- REDUCED LEVEL	C/C- CENTRE TO CENTRE
TYP - TYPICAL	CONSTN. - CONSTRUCTION
PCC - PLAIN CEMENT CONCRETE	PREPD. - PREPARED
MKD - MARKED	SQ - SQUARE
C - COLUMN	FL - FLAT
VER - VERTICAL	LG - LONG
BOF - BOTTOM OF FOUNDATION	PL - PLATE
CL - CENTRE LINE	CHQD. - CHEQUERED
RCC - REINFORCED CEMENT CONCRETE	RC - REINFORCED CONCRETE
DRG. - DRAWING	MISC. - MISCELLANEOUS
THK - THICK	DIA - DIAMETER
FGL - FINISHED GROUND LEVEL	BOTTOM REINFORCEMENT (B) - ———
PWTP - POTABLE WATER TREATMENT PLANT	TOP REINFORCEMENT (T) - - - - - -
HOR - HORIZONTAL	
T - TOP	
B - BOTTOM	
MAX. - MAXIMUM	

NOTES :-

1. ALL DIMENSIONS ARE IN MILLIMETRES AND LEVELS AND CO-ORDINATES ARE IN METRES UNLESS OTHERWISE STATED.
2. GRADE OF CONCRETE SHALL BE 35MPa FOR RCC AND 15 MPa FOR BLINDING CONCRETE.
3. GRADE OF REINFORCEMENT SHALL BE DEFORMED BAR MPa (GRADE 60) - ASTM M615/fy=420Mpa.
4. NET SAFE BEARING CAPACITY OF SOIL AT BOTTOM OF FOUNDATION IS CONSIDERED AS 550 KN/m^2.
5. CLEAR COVER TO REINFORCEMENT SHALL BE AS FOLLOWS :
   a). FOUNDATION = 50mm.
   b). WALL = 50mm.
   c). SLAB = 25mm.
6. FOR MINIMUM LAP LENGTH OF REINFORCEMENT REFER DRG. NO. MD-216-1000-EG-CV-DED-1001.
7. IF ANY PART OF FOUNDATION COMES ON BACKFILL ZONE OF ADJACENT FOUNDATION OR ANY LOOSE SOIL ARE ENCOUNTERED BELOW FOUNDATION LEVEL THE SAME SHALL BE REMOVED AND FILLED WITH PCC.
8. THE CONTENT OF THIS DRAWING SHALL CONFORM TO THE PROVISIONS OF CIVIL, STRUCTURAL & ARCHITECTURAL DESIGN CRITERIA DOCUMENT NO. MD-216-1000-EG-ST-CRT-1001.
9. INVERT LEVEL OF CUTOUT (500x500) TO BE FINALIZED AS PER DRAINAGE LAYOUT.
10. ANCHOR BOLT ARE SUPPLIED BY VENDOR.

DOCUMENT NUMBER	REFERENCE DOCUMENTS	REV	DATE	REVISION DESCRIPTION	DRN	CHK	ENG	APP	EMP
		D01	17/02/2023	AS-BUILT	SYA	SJM	BJB	AG	
		C02	08/01/2021	ISSUED FOR CONSTRUCTION & REVISED AS MKD	DSR	SJM	BJB	AG	
		C01	17/11/2020	ISSUED FOR CONSTRUCTION	DSR	SJM	BJB	AG	
		A01	14/10/2020	ISSUED FOR REFERENCE	DSR	SJM	BJB	AG	

RESERVED FOR VENDOR LOGO AND DRAWING NUMBER

LARSEN & TOUBRO

This drawing is the property of LARSEN & TOUBRO and must not be passed on to any person or body not authorized by us to receive it nor be copied or otherwise made use either in full or in part by such person or body without our prior permission in writing.

Outotec

The content of these documents are the sole property of Outotec Oyj. Any rights not expressly granted herein are reserved. Reproduction, transfer or distribution of part or all of the contents in any form without prior written permission of Outotec is prohibited.

MA'ADEN معادن
Saudi Arabian Mining Company شركة التعدين العربية السعودية

This document and the information contained herein is Ma'aden proprietary know-how. This document or any part thereof should not be reproduced, stored in a retrieval system or transmitted by any means, electronic or otherwise, or divulged without prior written permission of Ma'aden.

LARSEN & TOUBRO DRAWING NUMBER			REVISION
019045_080_C_D_24372_002			3
OUTOTEC DRAWING NUMBER		DOCUMENT ID	REVISION
900707__GAU01__AG32__CTB01__53002		0U100691534	3
DRAWN	DSR	06/10/2020	MANSOURAH - MASSARAH GOLD PROJECT
CHECKED	SJM	10/10/2020	DETAIL DRAWING
ENGINEER	BJB	05/10/2020	POTABLE WATER TREATMENT PLANT
APPROVED	AG	14/10/2020	PWTP SUMP & MISC. PUMP FOUNDATION RC DETAIL
EMPLOYER			
SCALE 1:100,75,50,20	A1		DRAWING NUMBER: MD-216-49WF-EG-CV-DED-2002 REV: D01