


DRAWING NUMBER
MD-216-49WF-EG-CV-DED-2003
REV
D01

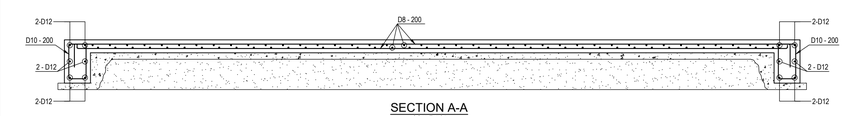


SECTION A-A
SCALE 1:25

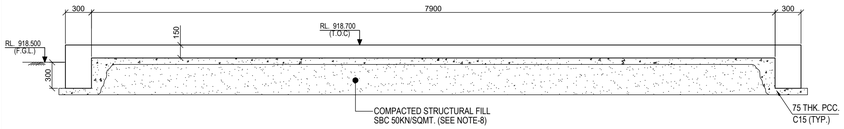


SECTION A-A
SCALE 1:25

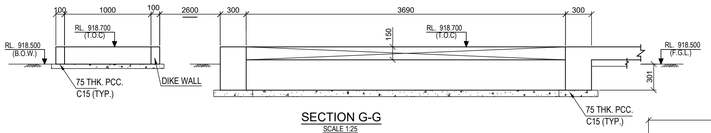


SECTION G-G
SCALE 1:25

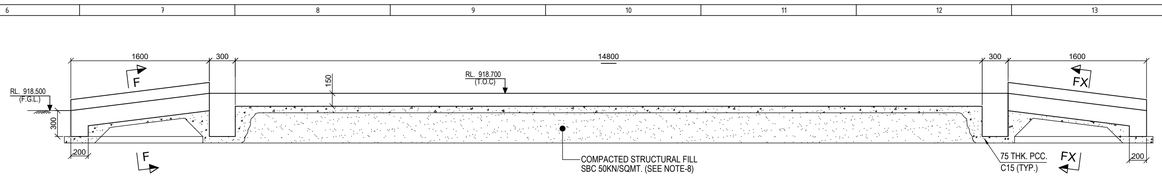


SECTION B-B
SCALE 1:25

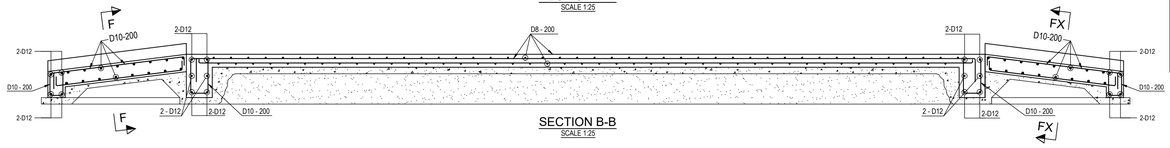


SECTION B-B
SCALE 1:25

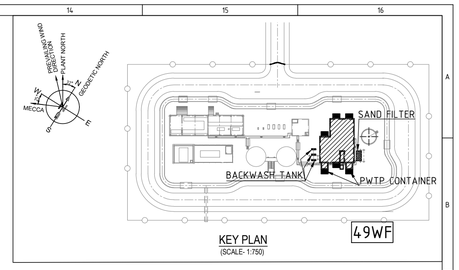


KEY PLAN
(SCALE- 1:750)

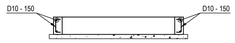


TYPICAL DETAIL OF DYKE WALL REINFORCEMENT
SCALE 1:25

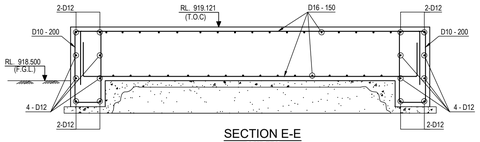


SECTION E-E
SCALE 1:25

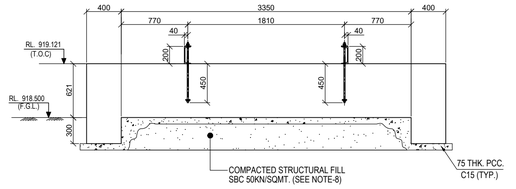


SECTION E-E
SCALE 1:25

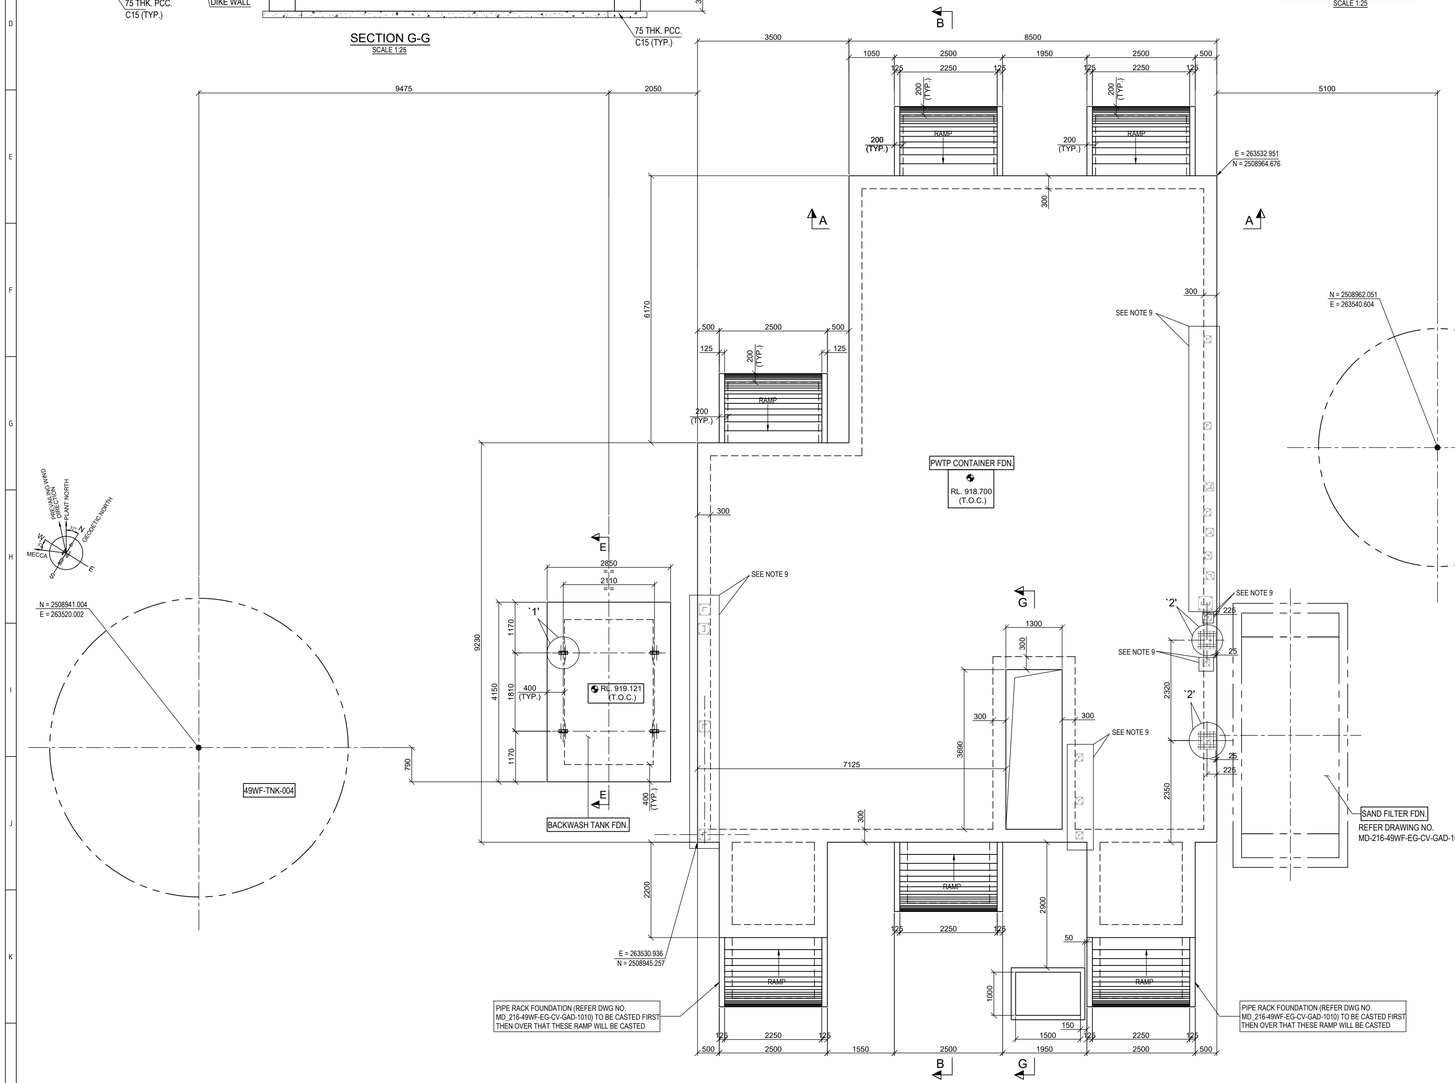


LAYOUT OF FOUNDATION
FOR PWTP CONTAINER, BACKWASH TANK AND SAND FILTER FDN.
SCALE 1:50

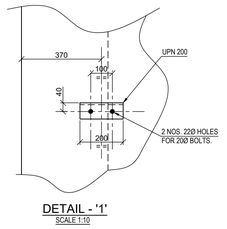

DETAIL - '1'
SCALE 1:10

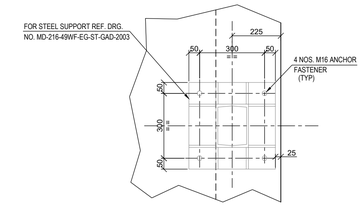

DETAIL - '2'
SCALE 1:10

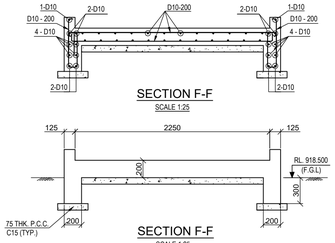

SECTION F-F
SCALE 1:25

SECTION F-F
SCALE 1:25

LEGEND :-
R.L. - REDUCED LEVEL
℄ - CENTRE LINE
T.O.C. - TOP OF CONCRETE
TYP. - TYPICAL
F.G.L. - FINISHED GROUND LEVEL
B.O.F. - BOTTOM OF FOUNDATION
P.C.C - PLAIN CEMENT CONCRETE
MKD. - MARKED
THK. - THICK
R.C.C - REINFORCED CEMENT CONCRETE
FDN. - FOUNDATION
DET. - DETAIL
DRG. - DRAWING
TNK. - TANK
CONT. - CONTAINER
FIL. - FILTER
SBC - SAFE BEARING CAPACITY
DIA - DIAMETER
B.O.W. - BOTTOM OF WALL
GA - GENERAL ARRANGEMENT

NOTES :-
1. ALL DIMENSIONS ARE IN MILLIMETRES AND LEVELS AND CO-ORDINATES ARE IN METRES. UNLESS OTHERWISE STATED.
2. GRADE OF CONCRETE SHALL BE C35 FOR FOUNDATION.
3. GRADE OF REINFORCEMENT SHALL BE DEFORMED BAR ASTM A615 - GRADE 60 (fy = 420 MPa).
4. IF ANY PART OF FOUNDATION COMES ON BACKFILL ZONE OF ADJACENT FOUNDATION OR ANY LOOSE SOIL ARE ENCOUNTERED BELOW FOUNDATION LEVEL THE SAME SHALL BE REMOVED AND FILLED WITH PCC (15MPa).
5. CLEAR COVER TO REINFORCEMENT SHALL BE AS
   a) FOUNDATION = 50 mm (BOTTOM & SIDE) 50 mm. (TOP)
   b) COLUMN = 50mm
   c) SLAB = 20mm
6. MINIMUM LAP LENGTH OF REINFORCEMENT SHALL BE 40 x DIA. OF BAR AS PER DRAWING NO. MD-216-1000-EG-CV-DED-1001 (GENERAL NOTES FOR CIVIL WORKS)
7. THE CONTENT OF THIS DRAWING SHALL CONFORM TO THE PROVISIONS OF CIVIL, STRUCTURAL & ARCHITECTURAL DESIGN CRITERIA DOCUMENT NO. MD-216-1000-EG-ST-CRT-1001.
8. THE STRUCTURAL FILL SHALL CONFORM TO PROVISIONS OF DOCUMENT NO. MD-216-1000-EG-CV-MST-1698.
9. ANCHOR FASTENER & BASE PLATE OF MECHANICAL SUPPORTS PLEASE REFER MECHANICAL SCOPE.

DOCUMENT NUMBER	REFERENCE DOCUMENTS	REV	DATE	REVISION DESCRIPTION	DRN	CHK	ENG	APP	EMP
		D01	17/02/2023	AS-BUILT	SYA	SJM	BJB	AG	
		C04	09/08/2021	ISSUED FOR CONSTRUCTION & REVISED AS MKD (4)	SYA	SJM	BJB	AG	
		C03	12/04/2021	ISSUED FOR CONSTRUCTION & REVISED AS MKD (3)	DSR	SJM	BJB	AG	
		C02	13/01/2021	ISSUED FOR CONSTRUCTION & REVISED AS MKD (2)	DSR	SJM	BJB	AG	
		C01	02/01/2021	ISSUED FOR CONSTRUCTION & REVISED AS MKD (1)	DSR	SJM	BJB	AG	
		A01	11/09/2020	ISSUED FOR REFERENCE	SYA	SJM	BJB	AG	

DOCUMENT NUMBER	REFERENCE DOCUMENTS	REV	DATE	REVISION DESCRIPTION	DRN	CHK	ENG	APP	EMP
MD-216-39WF-EG-PI-GAD-2001	PIPING LAYOUT FOR PWT AREA PIPING								

RESERVED FOR VENDOR LOGO AND DRAWING NUMBER

LARSEN & TOUBRO

This drawing is the property of LARSEN & TOUBRO and must not be passed on to any person or body not authorized by us to receive it nor be copied or otherwise made use either in full or in part by such person or body without our prior permission in writing.

Outotec

The content of these documents are the sole property of Outotec Oyj. Any rights not expressly granted herein are reserved. Reproduction, transfer or distribution of part or all of the contents in any form without prior written permission of Outotec is prohibited.

MA'ADEN معادن
Saudi Arabian Mining Company شركة المعادن السعودية

This document and the information contained herein is Ma'aden proprietary know-how. This document or any part thereof should not be reproduced, stored in a retrieval system or transmitted by any means, electronic or otherwise, or divulged without prior written permission of Ma'aden.

LARSEN & TOUBRO DRAWING NUMBER			REVISION
019045_080_C_D_24372_003			5
OUTOTEC DRAWING NUMBER		DOCUMENT ID	REVISION
900707__GAU01__AG32__CTB01__53003		OU100691535	5
DRAWN	SYA	29/08/2020	MANSOURAH - MASSARAH GOLD PROJECT
CHECKED	SJM	31/08/2020	DETAIL DRAWING
ENGINEER	BJB	29/08/2020	POTABLE WATER TREATMENT PLANT
APPROVED	AG	11/09/2020	BACKWASH TNK.,CONT. & SAND FIL. FDN. G.A & RCC DET.
EMPLOYER			
SCALE 1:50, 25, 20	A0	DRAWING NUMBER	REV
		MD-216-49WF-EG-CV-DED-2003	D01