


DRAWING NUMBER: MD-216-49WF-EG-CV-DED-2004 REV D01

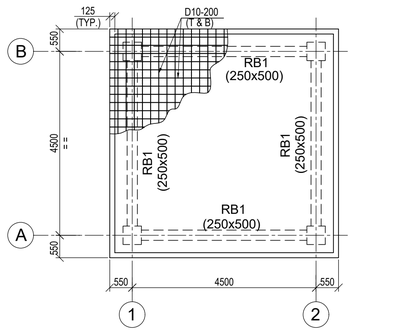


LAYOUT OF ROOF BEAM & HOLLOW CORE SLAB
(SCALE - 1:50)

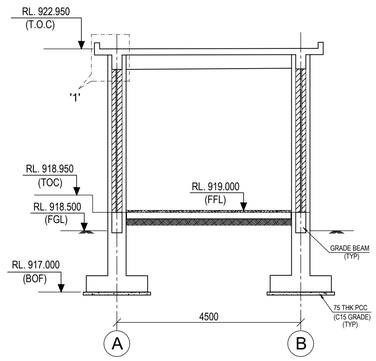


SECTION A-A
(SCALE - 1:75)

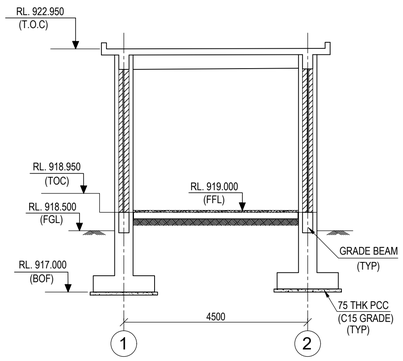


SECTION B-B
(SCALE - 1:75)

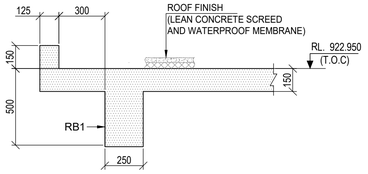


DETAIL-1
(SCALE 1:20)

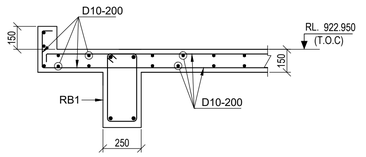


DETAIL-1
(SHOWING RC DETAIL)
(SCALE 1:20)

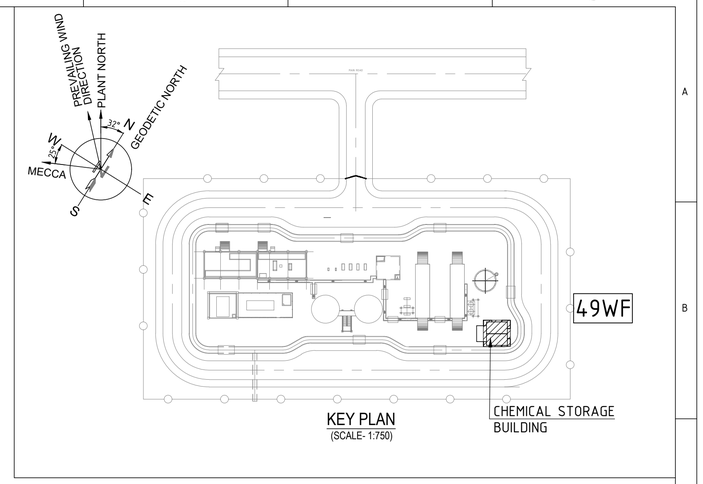


KEY PLAN
(SCALE- 1:750)

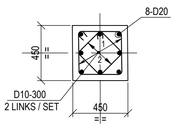


SECTION D1-D1
RC DETAIL OF COLUMN MKD C1
(SCALE = 1:25)

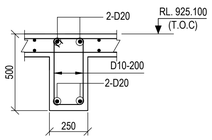


RC DETAIL OF RB1
(SCALE 1:20)

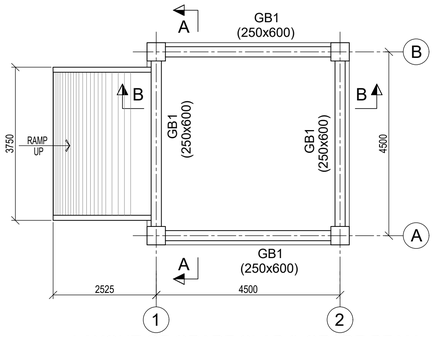


LAYOUT OF GRADE SLAB & GRADE BEAM
(SCALE - 1:75)

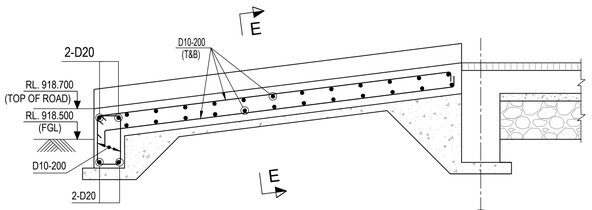


TYP RC DETAIL OF RUMP
(SCALE - 1:20)

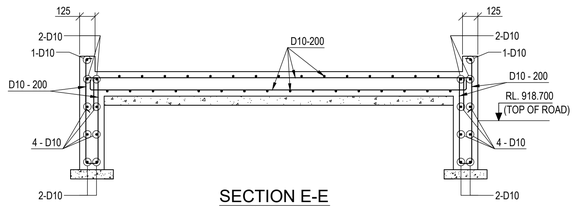


SECTION E-E
(SCALE - 1:25)

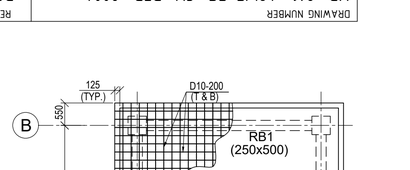

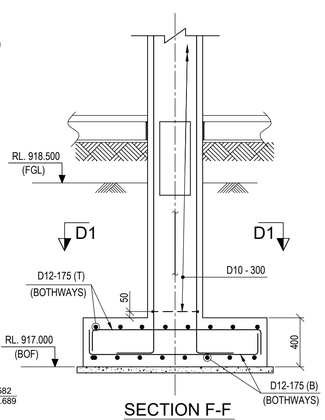


SECTION F-F
(SCALE - 1:25)


TYP DETAIL OF RUMP
(SCALE - 1:20)

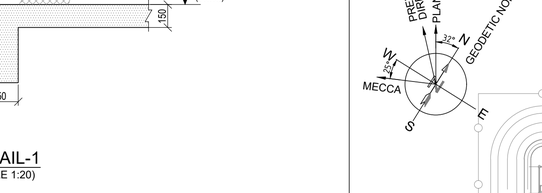


SECTION E-E
(SCALE - 1:25)

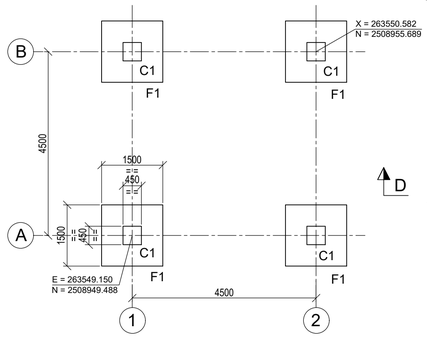


LAYOUT OF FOUNDATION
(SCALE - 1:75)

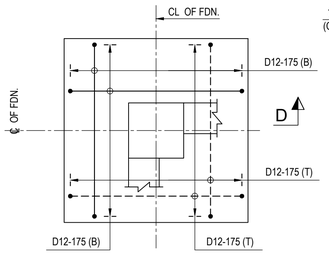


RC DETAIL OF FOUNDATION MKD F1
(SCALE - 1:25)

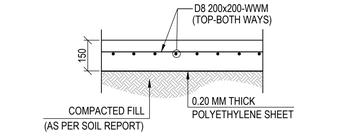

GRADE SLAB REINFORCEMENT DETAIL
(SCALE - 1:10)

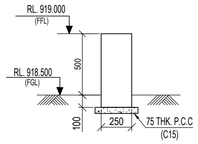

TYP DETAIL OF GRADE BEAM MKD GB1
(SCALE = 1:25)

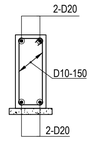

RC DETAIL OF GRADE BEAM MKD GB1
(SCALE = 1:25)

LEGENDS :

- TOC - TOP OF CONCRETE
- RL- REDUCED LEVEL
- TYP - TYPICAL
- PCC - PLAIN CEMENT CONCRETE
- MKD - MARKED
- C - COLUMN
- FDN. - FOUNDATION
- BOF - BOTTOM OF FOUNDATION
- CL - CENTRE LINE
- RC - REINFORCED CONCRETE
- DRG. - DRAWING
- THK - THICK
- FGL - FINISHED GROUND LEVEL
- WWM - WELDED WIRE MESH
- BOF - BOTTOM OF FOUNDATION
- FFL - FINISHED FLOOR LEVEL
- W - WIDTH
- H - HEIGHT
- BOTTOM REINFORCEMENT (B) - ———
- TOP REINFORCEMENT (T) - - - - - - - - - -

NOTES :-

1. ALL DIMENSIONS ARE IN MILLIMETRES AND LEVELS AND CO-ORDINATES ARE IN METRES UNLESS OTHERWISE STATED.
2. GRADE OF CONCRETE SHALL BE 35MPa FOR RCC AND 15 MPa FOR BLINDING CONCRETE.
3. GRADE OF REINFORCEMENT SHALL BE DEFORMED BAR MPa (GRADE 60) - ASTM M615/fy=420Mpa.
4. NET SAFE BEARING CAPACITY OF SOIL AT BOTTOM OF FOUNDATION IS CONSIDERED AS 750 KN/m^2
5. CLEAR COVER TO REINFORCEMENT CEMENT SHALL BE AS
   a). FOUNDATION = 50mm.
   b). COLUMN = 40mm.
   c). BEAM = 40mm.
   d). SLAB = 25mm.
6. FOR MINIMUM LAP LENGTH OF REINFORCEMENT REFER DRG. NO. MD-216-1000-EG-CV-DED-1001.
7. IF ANY PART OF FOUNDATION COMES ON BACKFILL ZONE OF ADJACENT FOUNDATION OR ANY LOOSE SOIL ARE ENCOUNTERED BELOW FOUNDATION LEVEL THE SAME SHALL BE REMOVED AND FILLED WITH PCC.
8. FOR STANDARD DETAILS OF ANCHOR BOLTS REFER DRG. NO. MD-216-1000-EG-CV-DED-1003.
9. THE CONTENT OF THIS DRAWING SHALL CONFORM TO THE PROVISIONS OF CIVIL, STRUCTURAL & ARCHITECTURAL DESIGN CRITERIA DOCUMENT NO. MD-216-1000-EG-ST-CRT-1001.

DOCUMENT NUMBER	REFERENCE DOCUMENTS	REV	DATE	REVISION DESCRIPTION	DRN	CHK	ENG	APP	EMP
		D01	17/02/2023	AS-BUILT	SYA	SJM	BJB	AG	
		C02	13/07/2021	ISSUED FOR CONSTRUCTION & REVISED AS MARKED /C02	SYA	SJM	AVG	AG	
		C01	17/11/2020	ISSUED FOR CONSTRUCTION	DSR	SJM	BJB	AG	
		A01	19/10/2020	ISSUED FOR REFERENCE	DSR	SJM	BJB	AG	

RESERVED FOR VENDOR LOGO AND DRAWING NUMBER

LARSEN & TOUBRO

This drawing is the property of LARSEN & TOUBRO and must not be passed on to any person or body not authorized by us to receive it nor be copied or otherwise made use either in full or in part by such person or body without our prior permission in writing.

Outotec

The content of these documents are the sole property of Outotec Oyj. Any rights not expressly granted herein are reserved. Reproduction, transfer or distribution of part or all of the contents in any form without prior written permission of Outotec is prohibited.

MA'ADEN معادن
Saudi Arabian Mining Company شركة التعدين العربية السعودية

This document and the information contained herein is Ma'aden proprietary know-how. This document or any part thereof should not be reproduced, stored in a retrieval system or transmitted by any means, electronic or otherwise, or divulged without prior written permission of Ma'aden.

LARSEN & TOUBRO DRAWING NUMBER	019045_080_C_D_24372_004		REVISION 3
OUTOTEC DRAWING NUMBER	900707__GAU01__AG32__CTB01__53004	DOCUMENT ID OU100691536	REVISION 3

DRAWN	DSR	14/10/2020
CHECKED	SJM	15/10/2020
ENGINEER	BJB	12/10/2020
APPROVED	AG	19/10/2020
EMPLOYER		
SCALE	1:75,50,20	A1

MANSOURAH - MASSARAH GOLD PROJECT
DETAIL DRAWING
POTABLE WATER TREATMENT PLANT
CHEMICAL STORAGE HOUSE GA & RC DETAIL

DRAWING NUMBER: MD-216-49WF-EG-CV-DED-2004 REV: D01