

DRAWING NUMBER MD-216-49WF-EG-CV-DED-2005 REV D01

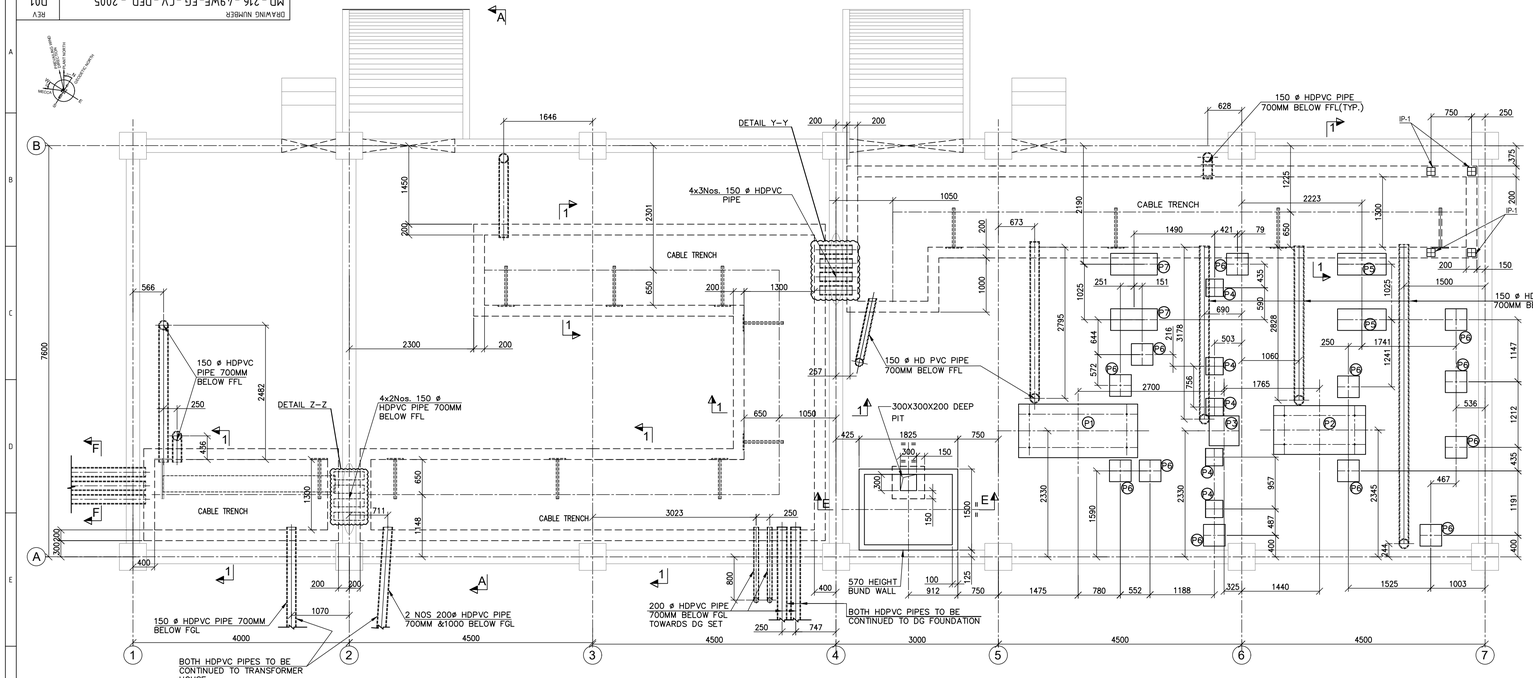


LAYOUT OF GROUND FLOOR
(SCALE - 1:100)

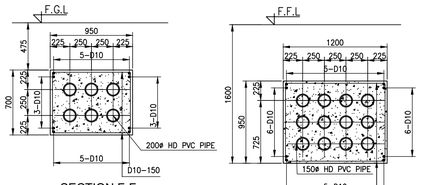


SECTION F-F
REINFORCEMENT DETAILS
(SCALE - 1:25)


DETAIL Y-Y
REINFORCEMENT DETAILS
(SCALE - 1:25)

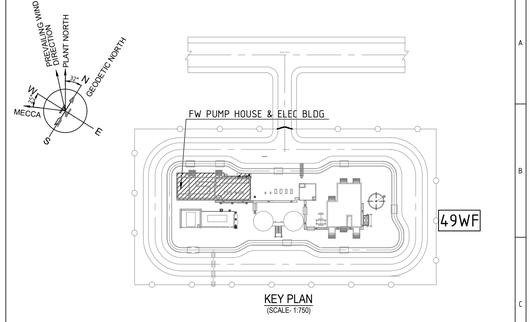


KEY PLAN
(SCALE- 1:750)

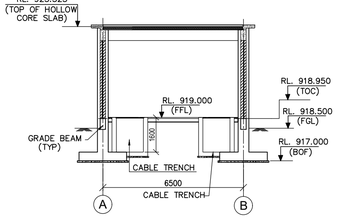


SECTION A-A
(SCALE - 1:100)

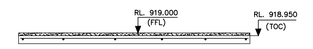


TYPICAL RC DETAILS OF GRADE SLAB
(REFER MD-216-1000-EG-CV-DED=1002)
(SCALE - 1:40)

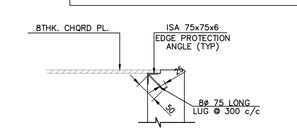

DETAIL-X
SCALE 1:25

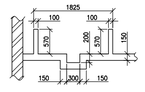


SECTION E-E
SCALE 1:50

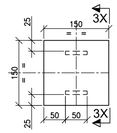


DETAIL OF IP-1
SCALE - 1:5


SECTION : 3X-3X
SCALE - 1:5

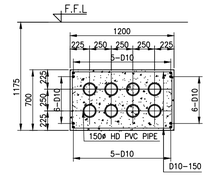


DETAIL Z-Z
REINFORCEMENT DETAILS
(SCALE - 1:25)

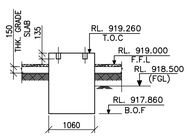


SECTION B-B
SCALE 1:50

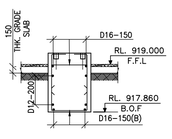


R.C. DETAIL SECTION OF B-B
SCALE 1:50

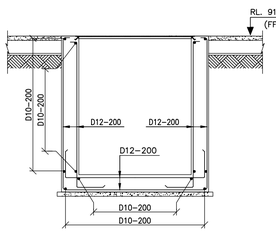


SECTION 1-1
REINFORCEMENT DETAILS
(SCALE - 1:25)

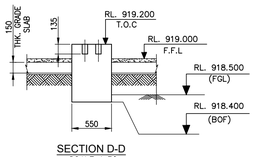


SECTION D-D
SCALE 1:30

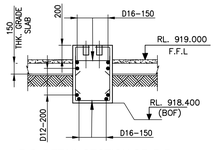


R.C. DETAIL SECTION OF D-D
SCALE 1:30

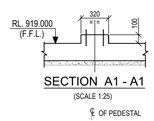


SECTION A1 - A1
(SCALE 1:25)

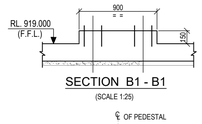


SECTION B1 - B1
(SCALE 1:25)

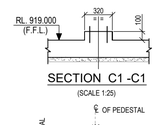


SECTION C1 -C1
(SCALE 1:25)

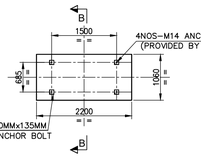


PLAN OF PUMP
FOUNDATION MARKED P1
SCALE 1:50

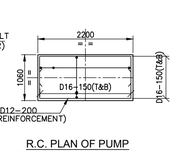


R.C. PLAN OF PUMP
FOUNDATION MARKED P1
SCALE 1:50

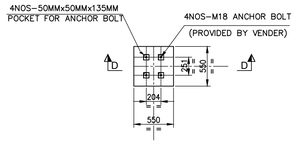


PLAN OF PUMP
FOUNDATION MARKED P3
SCALE 1:30

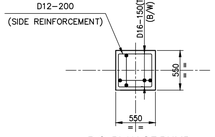


R.C. PLAN OF PUMP
FOUNDATION MARKED P3
SCALE 1:30

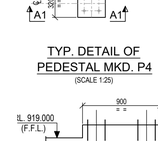


SECTION D1 - D1
(SCALE 1:25)

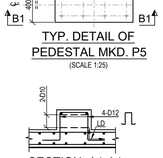


SECTION A1-A1
(RC DETAIL)
(SCALE 1:25)

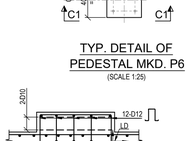

SECTION B1-B1
(RC DETAIL)
(SCALE 1:25)

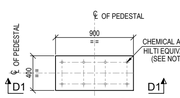


TYP. DETAIL OF
PEDESTAL MKD. P7
(SCALE 1:25)

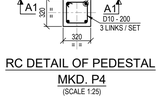


RC DETAIL OF PEDESTAL
MKD. P4
(SCALE 1:25)



RC DETAIL OF PEDESTAL
MKD. P5
(SCALE 1:25)

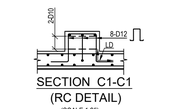

RC DETAIL OF PEDESTAL
MKD. P6
(SCALE 1:25)

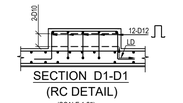


RC DETAIL OF PEDESTAL
MKD. P7
(SCALE 1:25)

TYP. DETAIL OF
PEDESTAL MKD. P7
(SCALE 1:25)


TYP. DETAIL OF
PEDESTAL MKD. P4
(SCALE 1:25)

TYP. DETAIL OF
PEDESTAL MKD. P5
(SCALE 1:25)


TYP. DETAIL OF
PEDESTAL MKD. P6
(SCALE 1:25)

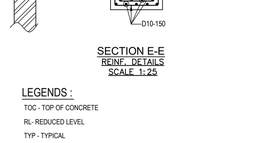


SECTION E-E
REINF. DETAILS
SCALE 1:25

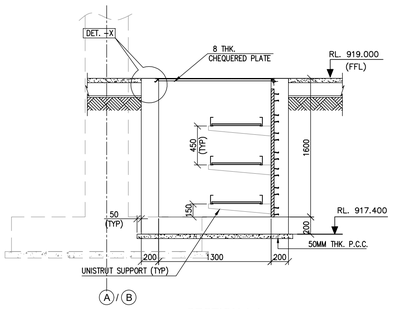


SECTION 1-1
GENERAL ARRANGEMENT
(SCALE - 1:25)

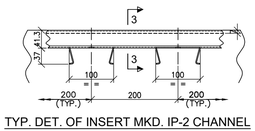


TYP. DET. OF INSERT MKD. IP-2 CHANNEL
TYPE E1000CI OR EQUIVALENT
SCALE - 1:5

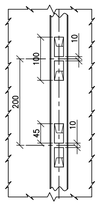


SECTION : 4-4
SCALE - 1:5

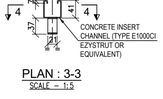


PLAN : 3-3
SCALE - 1:5

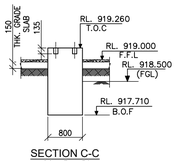


SECTION C-C
SCALE 1:50

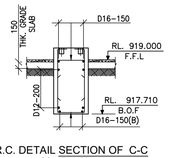

R.C. DETAIL SECTION OF C-C
SCALE 1:50

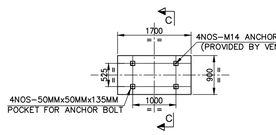

PLAN OF PUMP
FOUNDATION MARKED P2
SCALE 1:50

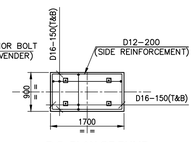

R.C. PLAN OF PUMP
FOUNDATION MARKED P2
SCALE 1:50

DOCUMENT NUMBER	REFERENCE DOCUMENTS	REV	DATE	REVISION DESCRIPTION	DRN	CHK	ENG	APP	EMP
		D01	17/02/2023	AS-BUILT	SYA	SJM	BJB	AG	
		C06	23/04/2021	ISSUED FOR CONSTRUCTION & REVISED AS MKD. (A)	SYA	BJB	APEX	SJM	
		C05	22/04/2021	ISSUED FOR CONSTRUCTION & REVISED AS MKD. (A)	SYA	BJB	APEX	SJM	
MD-216-39LA-EG-FG-LAD-V513-2230	VILLAGE AREA - FIRE PUMP HOUSE	C04	10/03/2021	ISSUED FOR CONSTRUCTION & REVISED AS MKD. (A)	PML	BJB	APEX	SJM	
MD-216-39LA-EG-FG-SED-V513-2013	VILLAGE AREA - FIRE PUMP HOUSE - A-A	C03	22/02/2021	ISSUED FOR CONSTRUCTION & REVISED AS MKD. (A)	ANI	BJB	APEX	SJM	
MD-216-39LA-EG-FG-GAD-V513-2004	VILLAGE-FIRE PUMP HOUSE MISCELLANEOUS DETAIL	C02	01/02/2021	ISSUED FOR CONSTRUCTION & REVISED AS MKD. (A)	ANI	BJB	APEX	SJM	
MD-216-49WF-EG-EL-LAD-1012	POTABLE TREATMENT PLANT CABLE ROUTE LAYOUT	C01	09/12/2020	ISSUED FOR CONSTRUCTION & REVISED AS MKD. (A)	APEX	BJB	APEX	SJM	
MD-216-49WF-EG-EL-LAD-1011	POTABLE TREATMENT PLANT CABLE ROUTE LAYOUT	A01	20/10/2020	ISSUED FOR REFERENCE	APEX	BJB	APEX	SJM	
MD-216-49WF-EG-CV-DED-2001	FW PUMP HOUSE & ELEC. BUILDING DETAIL								

RESERVED FOR VENDOR LOGO AND DRAWING NUMBER

LARSEN & TOUBRO

This drawing is the property of LARSEN & TOUBRO and must not be passed on to any person or body not authorized by us to receive it or to be copied or otherwise made use either in full or in part by such person or body without our prior permission in writing.

Outotec

The content of these documents are the sole property of Outotec Oyj. Any rights not expressly granted herein are reserved. Reproduction, transfer or distribution of part or all of the contents in any form without prior written permission of Outotec is prohibited.

MA'ADEN معادن Saudi Arabian Mining Company شركة معادن السعودية للتعدين

This document and the information contained herein is Ma'aden proprietary know-how. This document or any part thereof should not be reproduced, stored in a retrieval system or transmitted by any means, electronic or otherwise, or divulged without prior written permission of Ma'aden.

LARSEN & TOUBRO DRAWING NUMBER	019045_080_C_D_24372_005	REVISION 7
OUTOTEC DRAWING NUMBER	900707__GAU01__AG32_CTB01__53005	DOCUMENT ID OU100691537 REVISION 7
DRAWN	APEX 17/10/2020	MANSOURAH - MASSARAH GOLD PROJECT
CHECKED	BJB 19/10/2020	DETAIL DRAWING
ENGINEER	APEX 16/10/2020	POTABLE WATER TREATMENT PLANT
APPROVED	SJM 20/10/2020	FW PUMP HOUSE & ELEC. BLDG. GROUND FLOOR DETAIL
EMPLOYER		
SCALE	1:100, 50, 30, 25, 20 A0	DRAWING NUMBER MD-216-49WF-EG-CV-DED-2005 REV D01

LEGENDS :

TOC - TOP OF CONCRETE
RL- REDUCED LEVEL
TYP - TYPICAL
PCC - PLAIN CEMENT CONCRETE
MKD - MARKED
FDN. - FOUNDATION
BOF - BOTTOM OF FOUNDATION
CL - CENTRE LINE
BOC - BOTTOM OF CONCRETE
RC - REINFORCED CONCRETE
REINF. - REINFORCEMENT
DRG. - DRAWING
THK - THICK
FGL - FINISHED GROUND LEVEL
BOF - BOTTOM OF FOUNDATION
FFL - FINISHED FLOOR LEVEL
FW - FIRE WATER
ELEC - ELECTRICAL
BLDG - BUILDING
DET. - DETAIL
DIA - DIAMETER
HD PVC - HIGH DENSITY POLYVINYL CHLORIDE

NOTES :-

1. ALL DIMENSIONS ARE IN MILLIMETRES AND LEVELS AND CO-ORDINATES ARE IN METRES UNLESS OTHERWISE STATED.
2. GRADE OF CONCRETE SHALL BE 30MPa FOR RCC AND 15 MPa FOR BLINDING CONCRETE.
3. GRADE OF REINFORCEMENT SHALL BE DEFORMED BAR MPa (GRADE 60) - ASTM M615/fy=420Mpa
4. NET SAFE BEARING CAPACITY OF SOIL AT BOTTOM OF FOUNDATION IS CONSIDERED AS 500 KN/m
5. CLEAR COVER TO REINFORCEMENT SHALL BE AS
   a). FOUNDATION = 50mm.
   b). COLUMN = 40mm.
   c). BEAM = 40mm.
   d). SLAB = 25mm.
6. FOR MINIMUM LAP LENGTH OF REINFORCEMENT REFER DRG. NO. MD-216-1000-EG-CV-DED-1001.
7. IF ANY PART OF FOUNDATION COMES ON BACKFILL ZONE OF ADJACENT FOUNDATION OR ANY LOOSE SOIL ARE ENCOUNTERED BELOW FOUNDATION LEVEL THE SAME SHALL BE REMOVED AND FILLED WITH PCC.
8. FOR STANDARD DETAILS OF ANCHOR BOLTS REFER DRG. NO. MD-216-1000-EG-CV-DED-1003.
9. THE CONTENT OF THIS DRAWING SHALL CONFORM TO THE PROVISIONS OF CIVIL, STRUCTURAL & ARCHITECTURAL DESIGN CRITERIA DOCUMENT NO. MD-216-1000-EG-ST-CRT-1001.
10. ALL HILTI ANCHORS IN THIS DRAWING ARE IN VENDOR SCOPE.