


DRAWING NUMBER: MD-216-49WF-EG-CV-DED-2006 | REV: D01

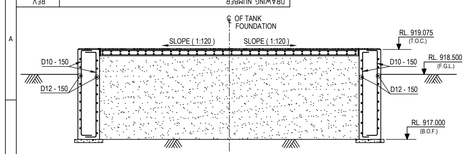


SECTION E-E
SCALE 1:50

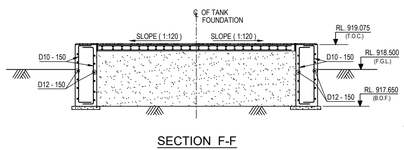


SECTION F-F
SCALE 1:50

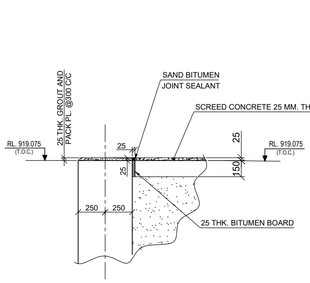


DETAIL - 'X1'
SCALE 1:20

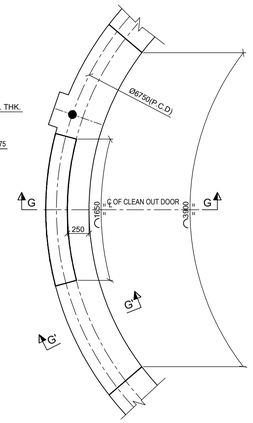


DETAIL 'Y3'
SCALE 1:25

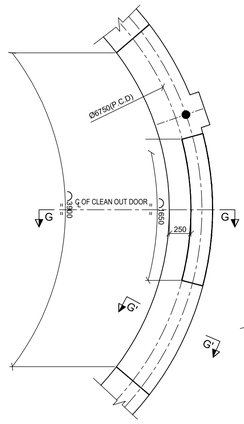


DETAIL 'Y4'
SCALE 1:25

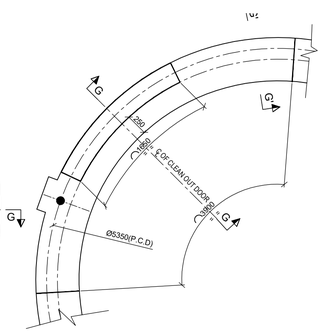


DETAIL 'Y5'
SCALE 1:25

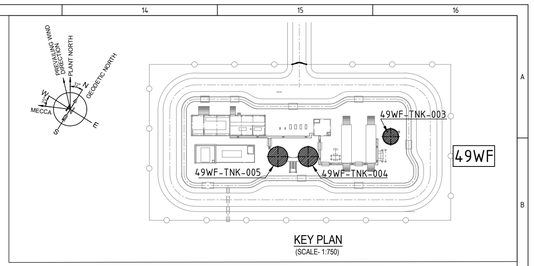


KEY PLAN
(SCALE- 1:750)

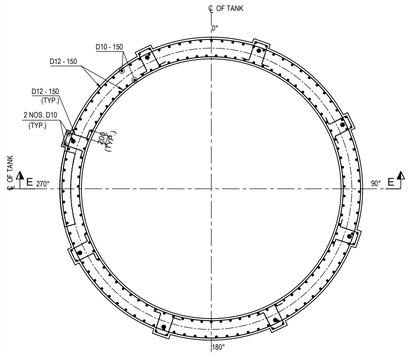


RCC. DET. OF TANK FOUNDATION
(TANK MKD. 49WF-TNK-004 & 49WF-TNK-005)
SCALE 1:50

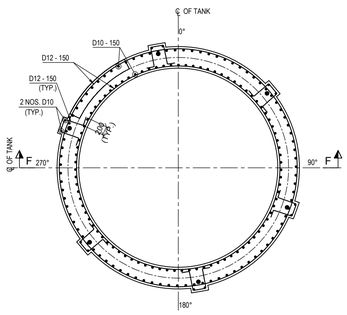


RCC. DET. OF TANK FOUNDATION
(TANK MKD. 49WF-TNK-003)
SCALE 1:50

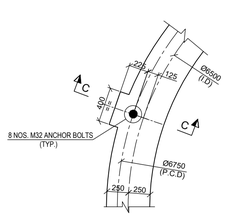


DETAIL 'Y1'
SCALE 1:25

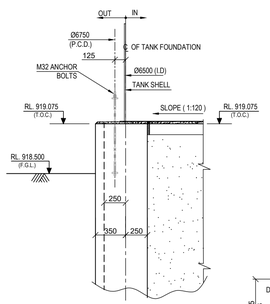


SECTION C-C
SCALE 1:25

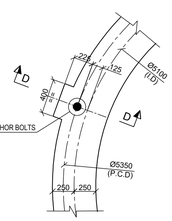


DETAIL 'Y2'
SCALE 1:25

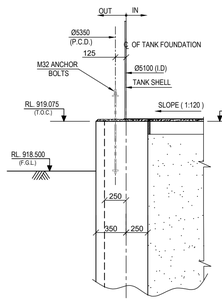


SECTION D-D
SCALE 1:25

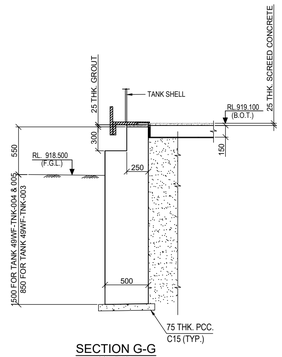


SECTION G-G
SCALE 1:25

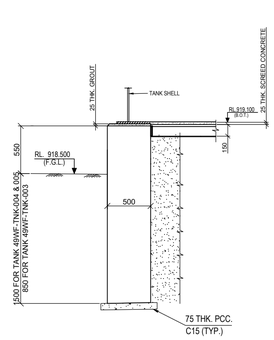

SECTION G'-G'
SCALE 1:25

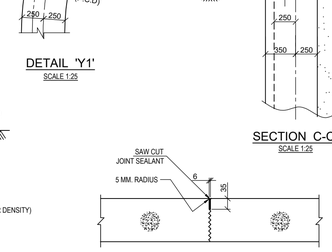


SECTION A-A
SCALE 1:50

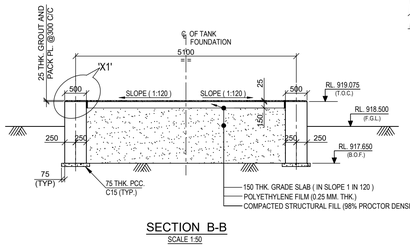


SECTION B-B
SCALE 1:50


TYP. DETAIL OF CONSTRUCTION JOINT
SCALE 1:10

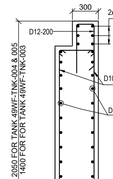


SECTION G-G
(RCC DETAIL)
SCALE 1:25

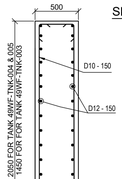


SECTION G'-G'
(RCC DETAIL)
SCALE 1:25

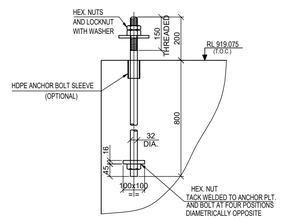


BOLT DETAIL
SCALE 1:10

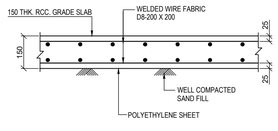

TYP. DET. OF 150 THK. GRADE SLAB
SCALE 1:10

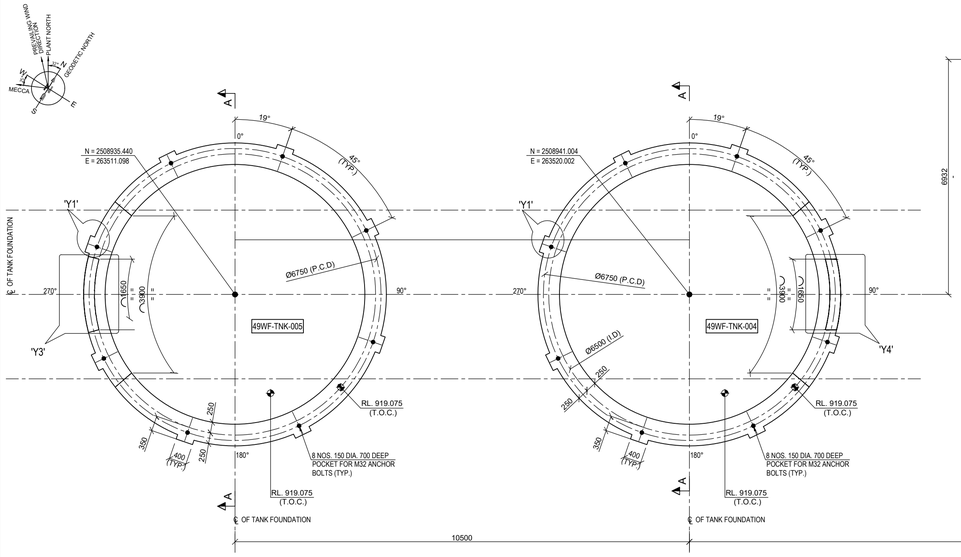

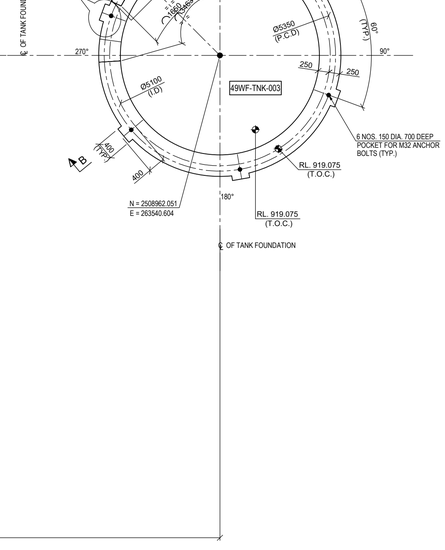

LAYOUT OF FOUNDATION
FOR POTABLE WATER TREATMENT TANK
(TANK MKD. 49WF-TNK-003, 49WF-TNK-004 & 49WF-TNK-005)
SCALE 1:50

LEGEND :-

R.L - REDUCED LEVEL
℄ - CENTRE LINE
T.O.C - TOP OF CONCRETE
T.O.G. - TOP OF GROUT
TYP. - TYPICAL
F.G.L - FINISHED GROUND LEVEL
B.O.F. - BOTTOM OF FOUNDATION
P.C.D. - PITCH CIRCLE DIAMETER
Ø - DIAMETER
DIA - DIAMETER
I.D. - INTERNAL DIAMETER
P.C.C - PLAIN CEMENT CONCRETE
MKD - MARKED
THK. - THICK
R.C.C - REINFORCED CEMENT CONCRETE
HEX - HEXAGONAL
HDPE - HIGH DENSITY POLYETHYLENE
PL. - PLATE
C/C - CENTRE TO CENTRE
FDN. - FOUNDATION
DET. - DETAIL
DRG. - DRAWING
GA - GENERAL ARRANGEMENT
RC - REINFORCED CONCRETE

NOTES :-

1. ALL DIMENSIONS ARE IN MILLIMETRES AND LEVELS AND CO-ORDINATES ARE IN METRES, UNLESS OTHERWISE STATED.
2. GRADE OF CONCRETE SHALL BE C35 FOR FOUNDATION.
3. GRADE OF REINFORCEMENT SHALL BE DEFORMED BAR ASTM A615 - GRADE 60 (fy = 420 MPa).
4. NET SAFE BEARING CAPACITY OF SOIL AT BOTTOM OF FOUNDATION CONSIDERED 225 KN/SQ. M. AT 850 MM. BELOW FGL. & 500 KN/SQ. M. AT 1500 MM. BELOW FGL.
5. IF ANY PART OF FOUNDATION COMES ON BACKFILL ZONE OF ADJACENT FOUNDATION OR ANY LOOSE SOIL ARE ENCOUNTERED BELOW FOUNDATION LEVEL THE SAME SHALL BE REMOVED AND FILLED WITH PCC (15MPa).
6. CLEAR COVER TO REINFORCEMENT SHALL BE AS
   a) RING WALL = 50mm
7. MINIMUM LAP LENGTH OF REINFORCEMENT SHALL BE 40 x DIA. OF BAR AS PER DRAWING NO. MD-216-1000-EG-CV-DED-1001 (GENERAL NOTES FOR CIVIL WORKS)
8. THE CONTENT OF THIS DRAWING SHALL CONFORM TO THE PROVISIONS OF CIVIL, STRUCTURAL & ARCHITECTURAL DESIGN CRITERIA DOCUMENT NO. MD-216-1000-EG-ST-CRT-1001.

DOCUMENT NUMBER	REFERENCE DOCUMENTS	REV	DATE	REVISION DESCRIPTION	DRN	CHK	ENG	APP	EMP
MD-216-1000-EG-CV-DED-1003	ANCHOR BOLTS STANDARD DETAILS								
MD-216-49WF-EG-ME-GAD-2005	PLAN, ELVN, DETAIL OF TANK 49WF-TNK-003	D01	17/02/2023	AS-BUILT	SYA	SJM	BJB	AG	
MD-216-49WF-EG-ME-GAD-2001	PLAN, ELVN, DETAIL OF TANK 49WF-TNK-004,005	C01	17/11/2020	ISSUED FOR CONSTRUCTION	SYA	SJM	BJB	AG	
MD-216-49WF-EG-ME-GAD-1009	POTABLE WATER STORAGE TANK 49WF-TNK-005	A02	23/09/2020	REVISED AS PER EMPLOYER'S COMMENT ON 24/08/2020 &	SYA	SJM	BJB	AG	
MD-216-49WF-EG-ME-GAD-1008	POTABLE WATER STORAGE TANK 49WF-TNK-004			REVISED AS MARKED A02					
MD-216-49WF-EG-ME-GAD-1007	POTABLE WATER STORAGE TANK 49WF-TNK-003	A01	30/07/2020	ISSUED FOR REFERENCE	SYA	SJM	BJB	AG	

RESERVED FOR VENDOR LOGO AND DRAWING NUMBER

LARSEN & TOUBRO

This drawing is the property of LARSEN & TOUBRO and must not be passed on to any person or body not authorized by us to receive it nor be copied or otherwise made use either in full or in part by such person or body without our prior permission in writing.

Outotec

The content of these documents are the sole property of Outotec Oyj. Any rights not expressly granted herein are reserved. Reproduction, transfer or distribution of part or all of the contents in any form without prior written permission of Outotec is prohibited.

MA'ADEN معادن
Saudi Arabian Mining Company

This document and the information contained herein is Ma'aden proprietary know-how. This document or any part thereof should not be reproduced, stored in a retrieval system or transmitted by any means, electronic or otherwise, or divulged without prior written permission of Ma'aden.

LARSEN & TOUBRO DRAWING NUMBER	019045_080_C_D_24372_006		REVISION 3
OUTOTEC DRAWING NUMBER	900707__GAU01__AG32__CTB01__53006	DOCUMENT ID 0U100691538	REVISION 3
DRAWN	SYA	20/07/2020	MANSOURAH - MASSARAH GOLD PROJECT
CHECKED	SJM	21/07/2020	DETAIL DRAWING
ENGINEER	BJB	20/07/2020	POTABLE WATER TREATMENT PLANT
APPROVED	AG	30/07/2020	TANK FDN. 49WF-003,004&005 GA & RC DET. DRG.
EMPLOYER			
SCALE 1:50, 25, 20, 10	A0		DRAWING NUMBER MD-216-49WF-EG-CV-DED-2006 REV D01