


DRAWING NUMBER: MD-216-49WF-EG-CV-DED-2007 | REV: D01

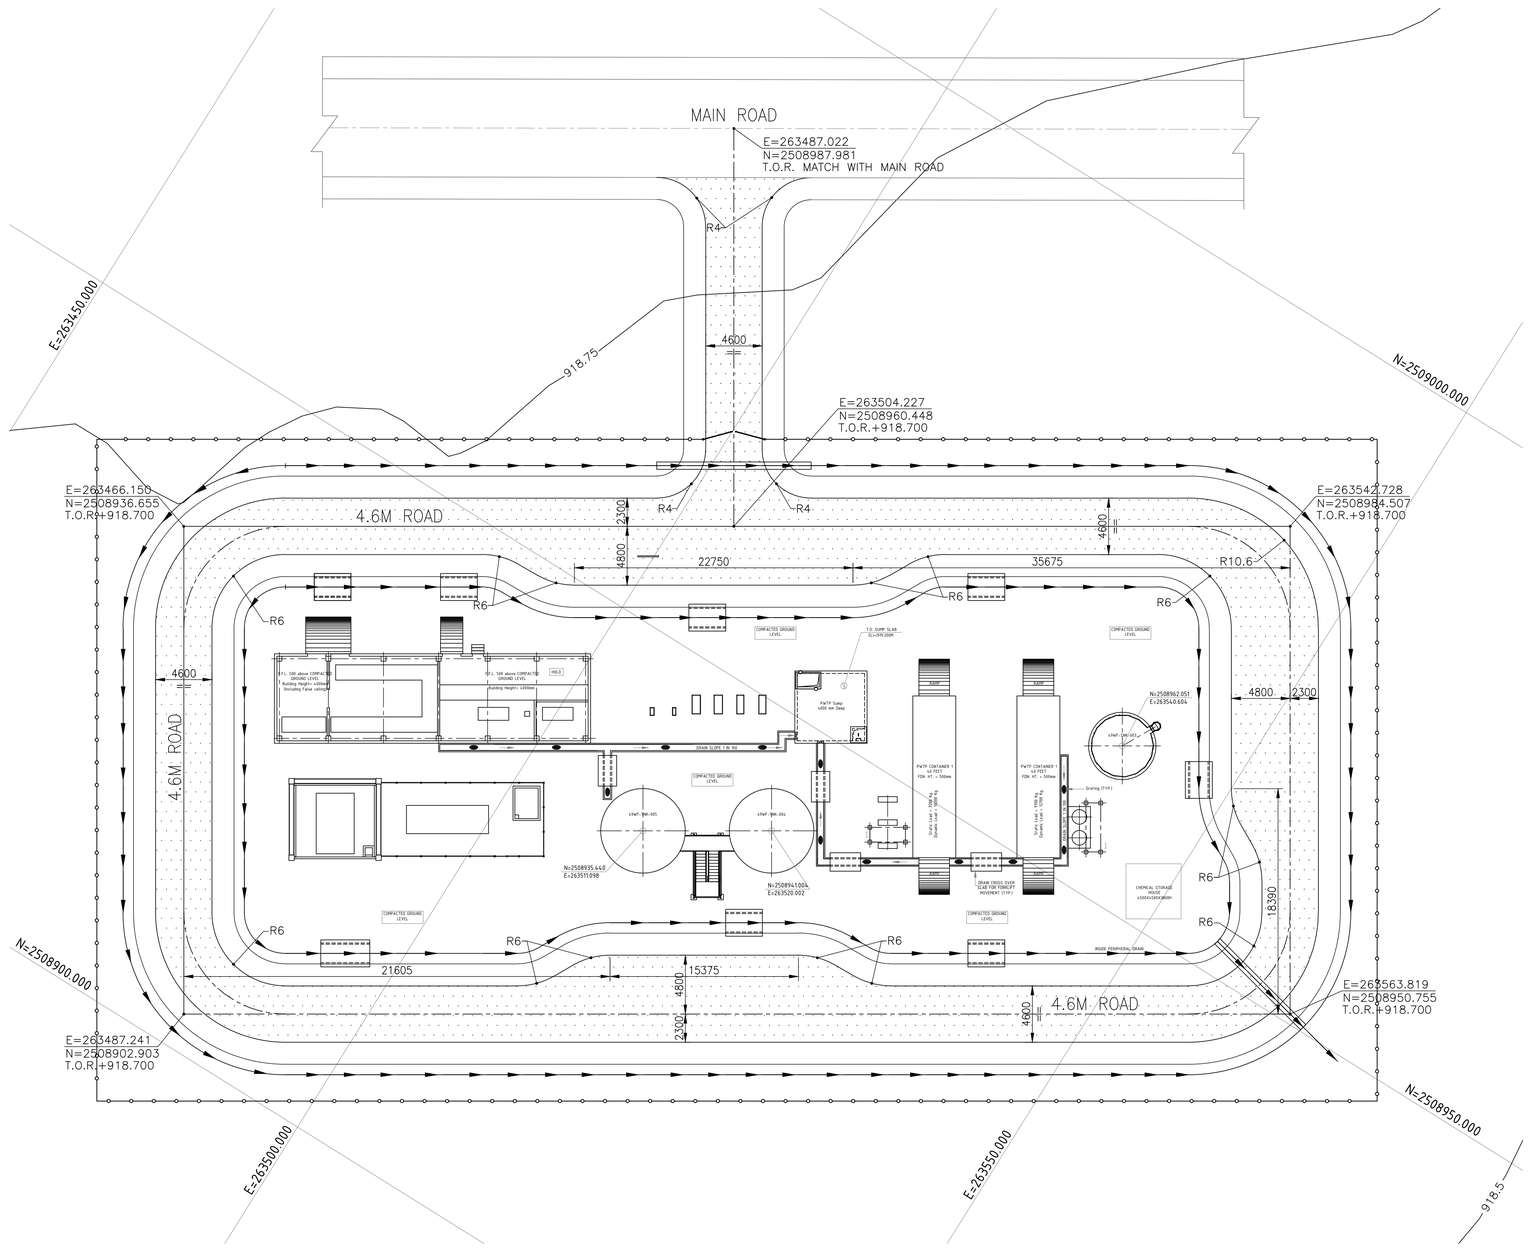

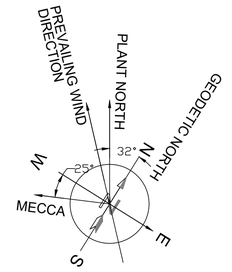

CUT AND FILL SLOPES

TERRAIN TYPE	DEPTH	CUT SLOPE (H : V)	FILL SLOPE (H : V)
ROLLING	0.00 - 1.00	3 : 1	4 : 1
	1.00 - 3.00	2 : 1	4 : 1
	3.00 - 5.00	2 : 1	3 : 1
	> 5.00	2 : 1	2 : 1

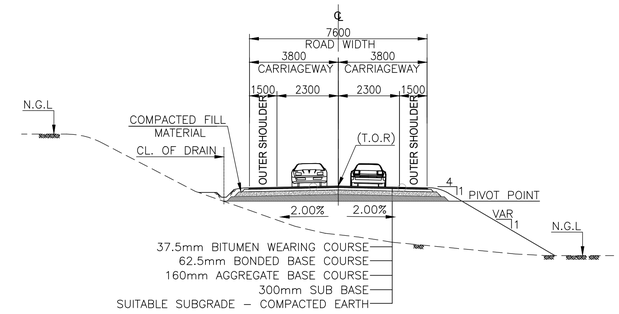

TYPICAL ROAD CROSS SECTION

NOTES:

1. ALL DIMENSIONS ARE IN MILLIMETRES
2. CO-ORDINATES AND LEVELS ARE IN METRES
3. TOP OF ROAD (T.O.R) = EL(+)918.700M.
4. INSIDE RADIUS OF CURVATURE OF ROAD SHOWN THUS.....6R, INDICATES RADIUS = 6M.
5. SYMBOL USED AS:- `S' = SLOPE AND `L' = LEVEL.
6. FINISHED GROUND LEVEL (F.G.L) = EL(+)918.500M.
7. DRAIN SLAB TO BE DESIGNED CONSIDERING FORKLIFT MOVEMENT UNLESS OTHERWISE SPECIFIED

DOCUMENT NUMBER	REFERENCE DOCUMENTS	REV	DATE	REVISION DESCRIPTION	DRN	CHK	ENG	APP	EMP
		D01	17/02/2023	AS-BUILT	SYA	SJM	BJB	AG	
		C02	18/03/2021	ISSUED FOR CONSTRUCTION & REVISED AS MARKED △2	APEX	BJB	APEX	SJM	
MD-216-49R0-EG-CV-GAD-1566	ACCESS ROAD TO WATER TREATMENT PLANT AREA	C01	19/11/2020	ISSUED FOR CONSTRUCTION	APEX	BJB	APEX	SJM	
MD-216-1000-EG-ME-PPD-1001	SITE MAP GENERAL OVERALL PROJECT LAYOUT	A01	14/08/2020	ISSUED FOR REFERENCE	APEX	BJB	APEX	SJM	

RESERVER FOR VENDOR LOGO AND DRAWING NUMBER

LARSEN & TOUBRO

This drawing is the property of *LARSEN & TOUBRO* and must not be passed on to any person or body not authorized by us to receive it nor be copied or otherwise made use either in full or in part by such person or body without our prior permission in writing.

Outotec

The content of these documents are the sole property of Outotec Oyj. Any rights not expressly granted herein are reserved. Reproduction, transfer or distribution of part or all of the contents in any form without prior written permission of Outotec is prohibited.

MA'ADEN معادن
Saudi Arabian Mining Company شركة التعدين العربية السعودية

This document and the information contained herein is Ma'aden proprietary know-how. This document or any part thereof should not be reproduced, stored in a retrieval system or transmitted by any means, electronic or otherwise, or divulged without prior written permission of Ma'aden.

LARSEN & TOUBRO DRAWING NUMBER		REVISION
019045_080_C_D_24372_007		3
OUTOTEC DRAWING NUMBER	DOCUMENT ID	REVISION
900707__GAU01__AG32__CTB03__53001	OU100691540	3

DRAWN	APEX	12/08/2020
CHECKED	BJB	13/08/2020
ENGINEER	APEX	11/08/2020
APPROVED	SJM	14/08/2020
EMPLOYER		
SCALE	1:250	A1

MANSOURAH - MASSARAH GOLD PROJECT
DETAIL DRAWING
POTABLE WATER TREATMENT PLANT
ROAD LAYOUT & CROSS SECTIONAL DETAIL

DRAWING NUMBER: MD-216-49WF-EG-CV-DED-2007 | REV: D01