


DRAWING NUMBER: MD-216-49WF-EG-CV-DED-2008 REV: D01

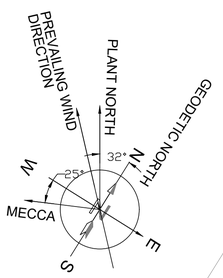

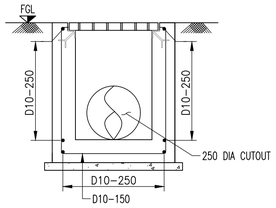


R.C. DETAIL OF DRAIN AT NODE NO. 7 & 8
SCALE 1:20

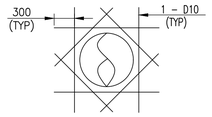


TYP.RCC DETAIL OF EXTRA REINFORCEMENT FOR DRAIN CUTOUT

SCHEDULE OF STORM WATER DRAINAGE SYSTEM


SL. NO.	NODE START	NODE END	DRAIN MKD.	LENGTH (M)	℄ OF CO-ORDINATE (M) START NODE	℄ OF CO-ORDINATE (M) END NODE	INVERT LEVELS (M) START NODE	INVERT LEVELS (M) END NODE	SLOPE	DRAIN TYPE	SHAPE	REMARKS
1	1	2	D1	30.3	E=263470.565 N=2508945.251	E=263496.261 N=2508961.308	918.200	918.100	1:300	EARTHEN TRAPEZOIDAL	300 1 1 GL 1 1	
2	2	3	D2	12.6	E=263496.261 N=2508961.308	E=263506.946 N=2508967.985	918.100	918.050	1:250	P.V.C. PIPE DRAIN	ø300	
3	3	4	D3	85.22	E=263506.946 N=2508967.985	E=263565.292 N=2508950.415	918.050	917.879	1:500	EARTHEN TRAPEZOIDAL	300 1 1 GL 1 1	
4	1	4	D4	148.95	E=263470.565 N=2508945.251	E=263565.292 N=2508950.415	918.200	917.870	1:450	EARTHEN TRAPEZOIDAL	300 1 1 GL 1 1	
5	5	6	D5	103.86	E=263475.812 N=2508936.855	E=263555.646 N=2508952.642	918.200	917.903	1:350	EARTHEN TRAPEZOIDAL	300 1 1 GL 1 1	
6	5	6	D6	110.58	E=263475.812 N=2508936.855	E=263555.646 N=2508952.642	918.200	917.905	1:375	EARTHEN TRAPEZOIDAL	300 1 1 GL 1 1	
7	6	4	D7	9.9	E=263555.646 N=2508952.642	E=263565.292 N=2508950.415	917.903	917.870	1:300	P.V.C. PIPE DRAIN	ø400	
8	7	8	D8	11.545	E=263541.424 N=2508951.399	E=263531.631 N=2508945.279	918.128	918.011	1:100	P.V.C. PIPE DRAIN	ø200	

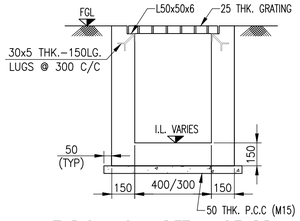


TYPICAL G.A. DETAIL OF DRAIN
SCALE 1:20

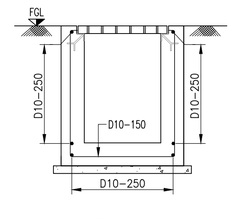


R.C. DETAIL OF DRAIN
SCALE 1:20

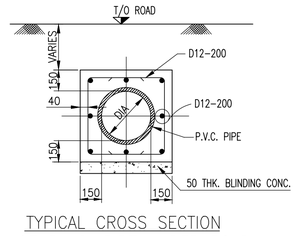


TYPICAL CROSS SECTION OF P.V.C. PIPE UNDER ROAD
SCALE 1:20

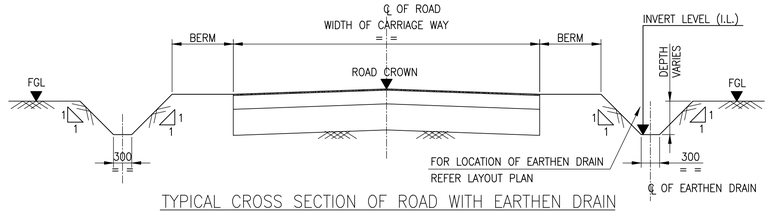

TYPICAL CROSS SECTION OF ROAD WITH EARTHEN DRAIN
SCALE= 1:50

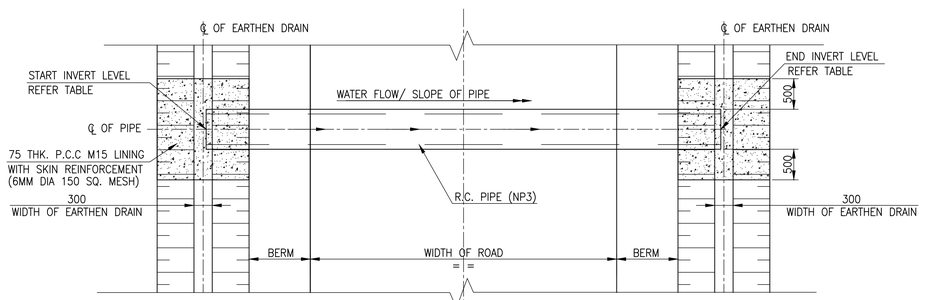

TYPICAL G.A. DETAIL OF PIPE UNDER ROAD FOR STORM WATER DRAIN
SCALE= 1:50

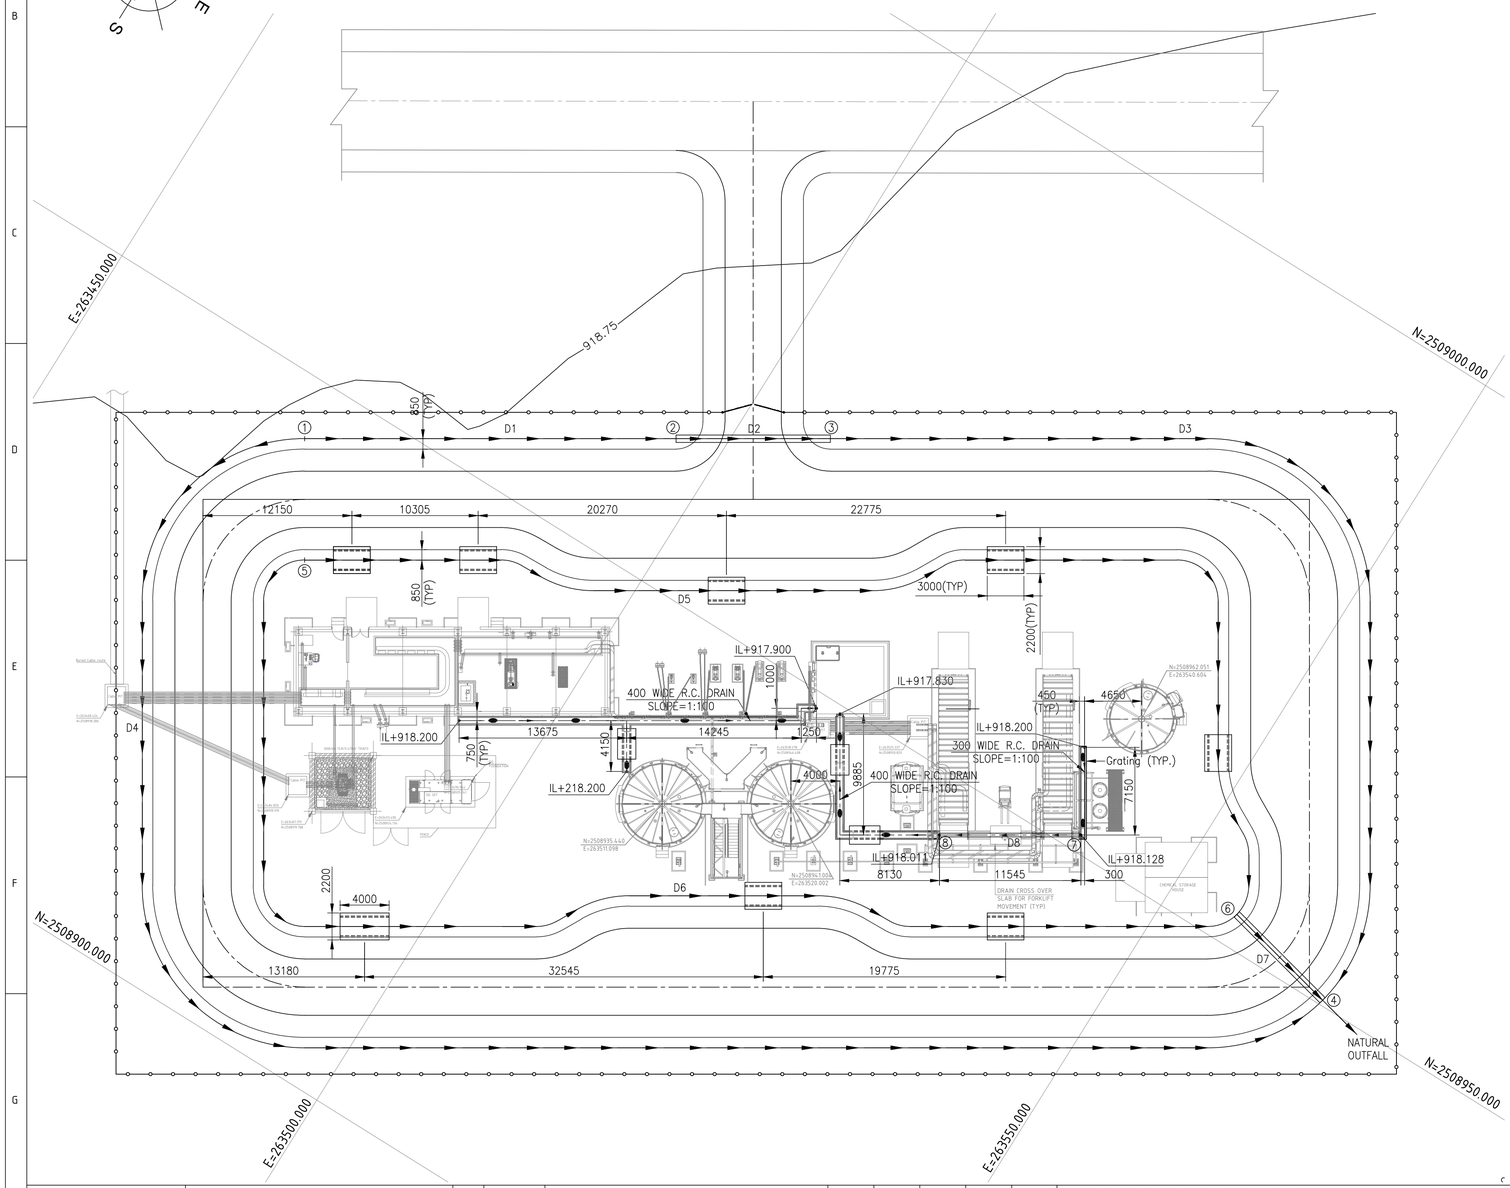

LEGEND:

	FENCE	SQ.	SQUARE
	NEW ROAD (L&T SCOPE)	℄	CENTRE LINE
FGL	FINISHED GROUND LEVEL	T/O	TOP OF
R.C.	REINFORCED CONCRETE	C/C	CENTRE TO CENTRE
G.A.	GENERAL ARRANGEMENT	I.L.	INVERT LEVEL
TYP	TYPICAL	E.L.	ELEVATION
LG.	LONG		
P.C.C	PLANE CEMENT CONCRETE		
THK	THICK		
DIA	DIAMETER		

NOTES:

1. ALL DIMENSIONS ARE IN MILLIMETRES UNLESS OTHERWISE SPECIFIED.
2. CO-ORDINATES AND LEVELS ARE IN METRES.
3. FINISHED GROUND LEVEL (F.G.L) = EL(+)918.500M.
4. GRADE OF REINFORCED CEMENT CONCRETE (R.C.C) SHALL BE M35.
5. REINFORCEMENT BARS SHALL CONFORM TO ASTM A615 GRADE 60 (fy=420 N/sq.mm.)
6. CLEAR COVER TO MAIN REINFORCEMENT SHALL BE AS FOLLOWES:
   a) WALL = 50 mm.
   b) SLAB = 25 mm.

DOCUMENT NUMBER	REFERENCE DOCUMENTS	REV	DATE	REVISION DESCRIPTION	DRN	CHK	ENG	APP	EMP
		D01	17/02/2023	AS-BUILT	SYA	BJB	APEX	SJM	
		C03	08/09/2021	ISSUED FOR CONSTRUCTION & REVISED AS MKD (C03)	SYA	BJB	APEX	SJM	
		C02	25/08/2021	ISSUED FOR CONSTRUCTION & REVISED AS MKD (C02)	PML	BJB	APEX	SJM	
		C01	20/02/2021	ISSUED FOR CONSTRUCTION	APEX	BJB	APEX	SJM	
MD-216-49WF-EG-CV-DED-2007	ROAD LAYOUT & CROSS SECTIONAL DETAIL	A02	15/01/2021	REVISED AS PER EMPLOYER'S COMMENT ON 06/01/2021	APEX	BJB	APEX	SJM	
MD-216-1000-EG-ME-PPD-1001	SITE MAP GENERAL OVERALL PROJECT LAYOUT	A01	07/12/2020	ISSUED FOR REVIEW	APEX	BJB	APEX	SJM	

RESERVER FOR VENDOR LOGO AND DRAWING NUMBER

LARSEN & TOUBRO DRAWING NUMBER: 019045_080_C_D_24372_008 — REVISION: 5
OUTOTEC DRAWING NUMBER: 900707__GAU01__AG32__CTB01__53007 — DOCUMENT ID: OU100691539 — REVISION: 5

DRAWN	APEX	26/11/2020
CHECKED	BJB	04/12/2020
ENGINEER	APEX	25/11/2020
APPROVED	SJM	07/12/2020
EMPLOYER		
SCALE	1:250	A1

MANSOURAH - MASSARAH GOLD PROJECT
DETAIL DRAWING
POTABLE WATER TREATMENT PLANT
LAYOUT & DETAIL OF STORM WATER DRAIN

DRAWING NUMBER: MD-216-49WF-EG-CV-DED-2008 — REV: D01

LARSEN & TOUBRO
This drawing is the property of LARSEN & TOUBRO and must not be passed on to any person or body not authorized by us to receive it nor be copied or otherwise made use either in full or in part by such person or body without our prior permission in writing.

Outotec
The content of these documents are the sole property of Outotec Oyj. Any rights not expressly granted herein are reserved. Reproduction, transfer or distribution of part or all of the contents in any form without prior written permission of Outotec is prohibited.

MA'ADEN معادن
Saudi Arabian Mining Company شركة التعدين العربية السعودية
This document and the information contained herein is Ma'aden proprietary know-how. This document or any part thereof should not be reproduced, stored in a retrieval system or transmitted by any means, electronic or otherwise, or divulged without prior written permission of Ma'aden.