


DRAWING NUMBER MD-216-49WF-EG-CV-DED-2009 REV D01

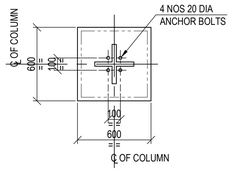


SECTION A1-A1
(SCALE 1:25)

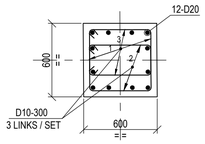


SECTION A1-A1
RCC DETAIL OF COLUMN MKD C1
(SCALE = 1:25)

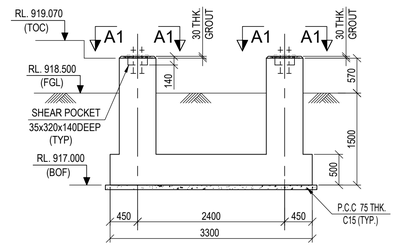


SECTION A-A
(SCALE - 1:50)

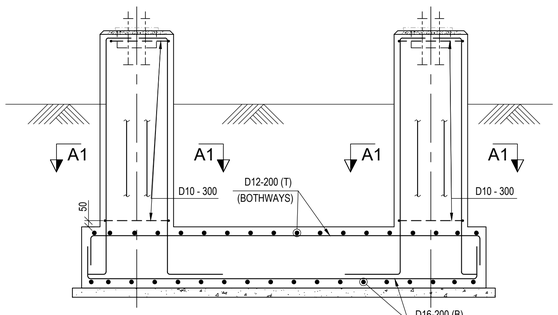


SECTION A-A
(SCALE - 1:25)

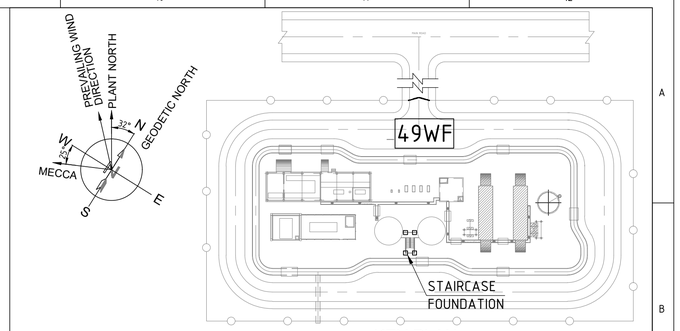


KEY PLAN
(SCALE - 1:750)

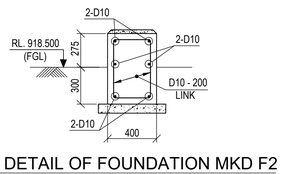


RCC DETAIL OF FOUNDATION MKD F2
(SCALE - 1:25)

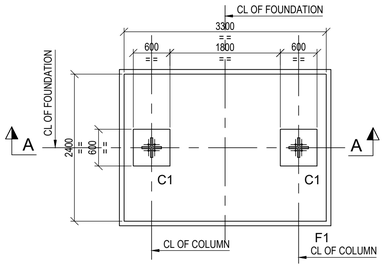


DETAIL OF FOUNDATION MKD F1
(SCALE - 1:50)

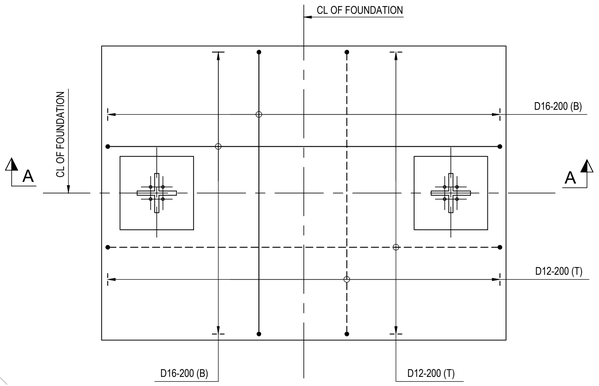


RCC DETAIL OF FOUNDATION MKD F1
(SCALE - 1:25)

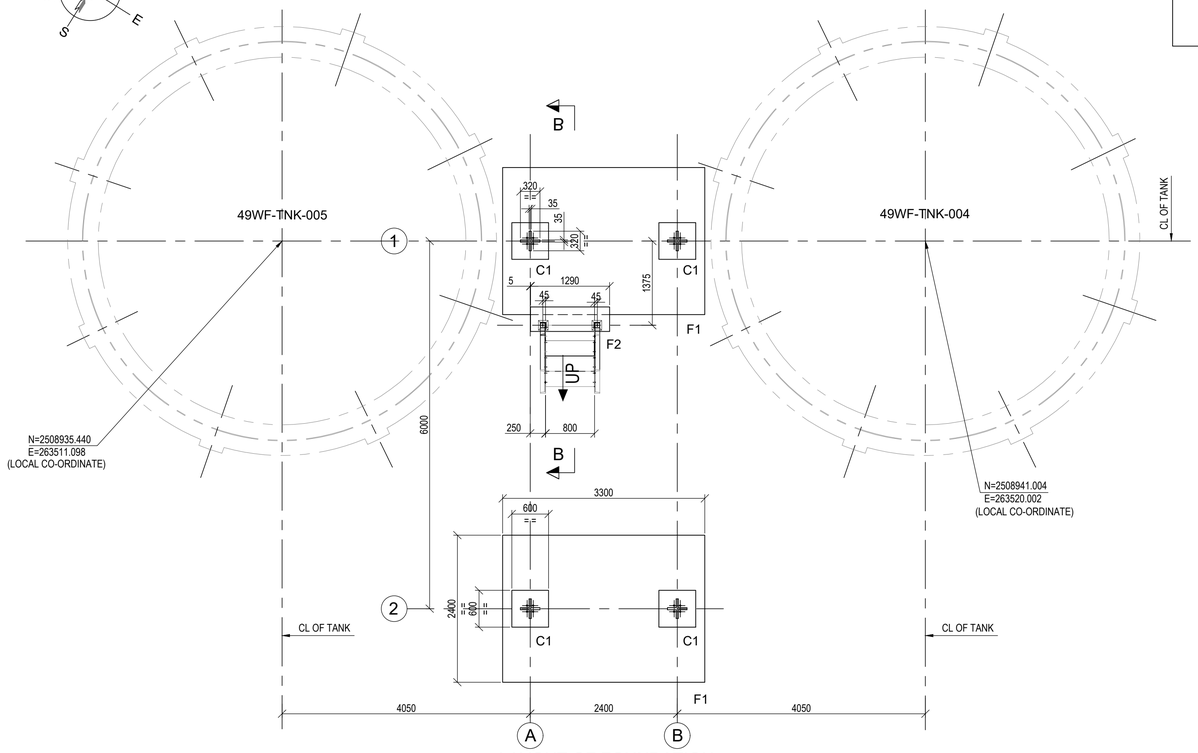

LAYOUT OF FOUNDATION
(SCALE - 1:50)

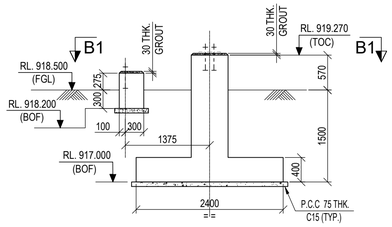

SECTION B-B
(SCALE - 1:50)

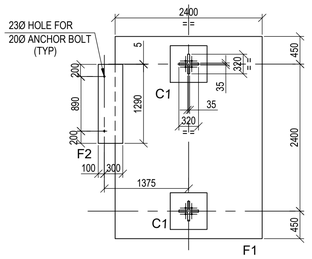

PLAN B1-B1
(SCALE - 1:50)

LEGENDS :

TOC - TOP OF CONCRETE
RL- REDUCED LEVEL
TYP - TYPICAL
PCC - PLAIN CEMENT CONCRETE
MKD - MARKED
C - COLUMN
FDN - FOUNDATION
BOF - BOTTOM OF FOUNDATION
CL - CENTRE LINE
RCC - REINFORCED CEMENT CONCRETE
DRG. - DRAWING
THK - THICK
FGL - FINISHED GROUND LEVEL
RC - REINFORCED CONCRETE
BOF - BOTTOM OF FOUNDATION
SC - STAIRCASE
GA - GENERAL ARRANGEMENT
DIA - DIAMETRE
BOTTOM (B) - ———————
TOP (T) - – – – – – – – – – – –

NOTES :-

1. ALL DIMENSIONS ARE IN MILLIMETRES AND LEVELS AND CO-ORDINATES ARE IN METRES UNLESS OTHERWISE STATED.
2. GRADE OF CONCRETE SHALL BE 35MPa FOR RCC AND 15 MPa FOR BLINDING CONCRETE.
3. GRADE OF REINFORCEMENT SHALL BE DEFORMED BAR (GRADE 60) - ASTM M615/fy=420Mpa.
4. NET SAFE BEARING CAPACITY OF SOIL AT BOTTOM OF FOUNDATION IS CONSIDERED AS 650.
5. CLEAR COVER TO REINFORCEMENT SHALL BE AS
   a). FOUNDATION = 50mm.
   b). COLUMN = 50mm.
6. FOR MINIMUM LAP LENGTH OF REINFORCEMENT REFER DRG. NO. MD-216-1000-EG-CV-DED-1001.
7. IF ANY PART OF FOUNDATION COMES ON BACKFILL ZONE OF ADJACENT FOUNDATION OR ANY LOOSE SOIL ARE ENCOUNTERED BELOW FOUNDATION LEVEL THE SAME SHALL BE REMOVED AND FILLED WITH PCC.
8. FOR STANDARD DETAILS OF ANCHOR BOLTS REFER DRG. NO. MD-216-1000-EG-CV-DED-1003.
9. THE CONTENT OF THIS DRAWING SHALL CONFORM TO THE PROVISIONS OF CIVIL, STRUCTURAL & ARCHITECTURAL DESIGN CRITERIA DOCUMENT NO. MD-216-1000-EG-ST-CRT-1001 & GENERAL NOTES DRG.NO. MD-216-1000-EG-CV-DED-1001.

DOCUMENT NUMBER	REFERENCE DOCUMENTS	REV	DATE	REVISION DESCRIPTION	DRN	CHK	ENG	APP	EMP
		D01	17/02/2023	AS-BUILT	DSR	SJM	BJB	AG	
		C01	17/11/2020	ISSUED FOR CONSTRUCTION	DSR	SJM	BJB	AG	
MD-216-49WF-EG-ME-GAD-2004	STAIRCASE OF TANK 49WF TANK-004 & 005	A01	17/09/2020	ISSUED FOR REFERENCE	DSR	SJM	BJB	AG	

RESERVED FOR VENDOR LOGO AND DRAWING NUMBER

LARSEN & TOUBRO
This drawing is the property of LARSEN & TOUBRO and must not be passed on to any person or body not authorized by us to receive it nor be copied or otherwise made use either in full or in part by such person or body without our prior permission in writing.

Outotec
The content of these documents are the sole property of Outotec Oy). Any rights not expressly granted herein are reserved. Reproduction, transfer or distribution of part or all of the contents in any form without prior written permission of Outotec is prohibited.

MA'ADEN معادن
Saudi Arabian Mining Company شركة التعدين العربية السعودية
This document and the information contained herein is Ma'aden proprietary know-how. This document or any part thereof should not be reproduced, stored in a retrieval system or transmitted by any means, electronic or otherwise, or divulged without prior written permission of Ma'aden.

LARSEN & TOUBRO DRAWING NUMBER			REVISION
019045_080_C_D_24397_001			2
OUTOTEC DRAWING NUMBER		DOCUMENT ID	REVISION
900707__GAU01__AG32__CTB17__53016		OU100696990	2

DRAWN	DSR	09/09/2020
CHECKED	SJM	11/09/2020
ENGINEER	BJB	09/09/2020
APPROVED	AG	14/09/2020
EMPLOYER		
SCALE	1:100,50,25	A1

MANSOURAH - MASSARAH GOLD PROJECT
DETAIL DRAWING
POTABLE WATER TREATMENT PLANT
FDN GA & RC DET OF SC OF TANK 49WF-004 & 005

DRAWING NUMBER MD-216-49WF-EG-CV-DED-2009 REV D01