


DRAWING NUMBER MD-216-49WF-EG-CV-GAD-1003 REV D01

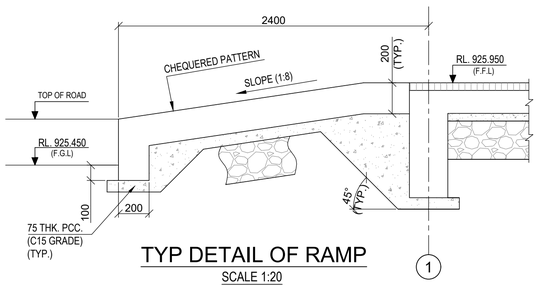


TYP DETAIL OF RAMP
SCALE 1:20

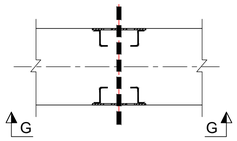


DETAIL - D1
SCALE 1:10

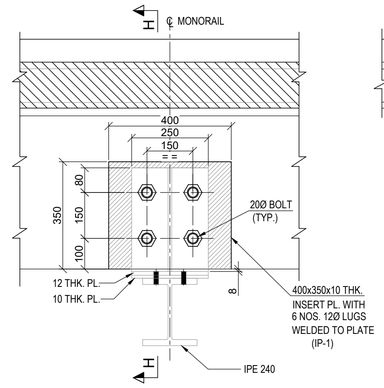


SECTION G-G
SCALE 1:50

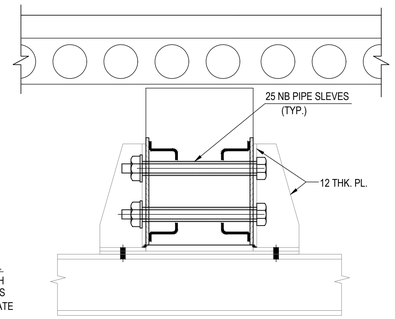


SECTION : H-H
SCALE 1:50

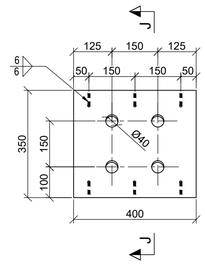


DETAIL OF IP-1
SCALE 1:50

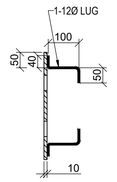


SECTION J-J
SCALE 1:50

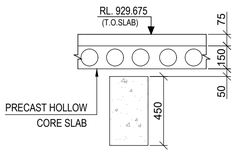


DETAIL-'Z'
SCALE 1:20

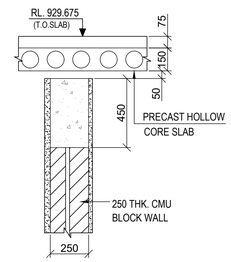


DETAIL-'Z1'
SCALE 1:20

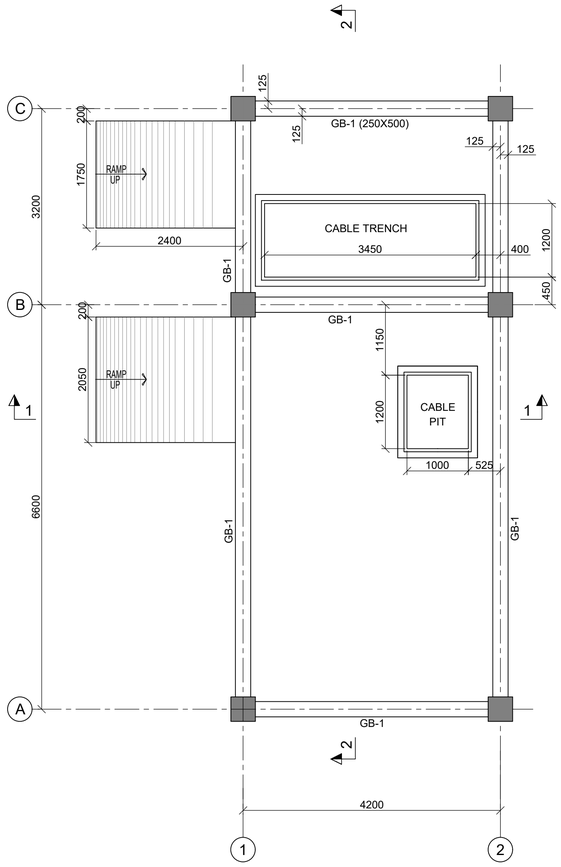


LAYOUT OF GRADE BEAM
SCALE 1:50

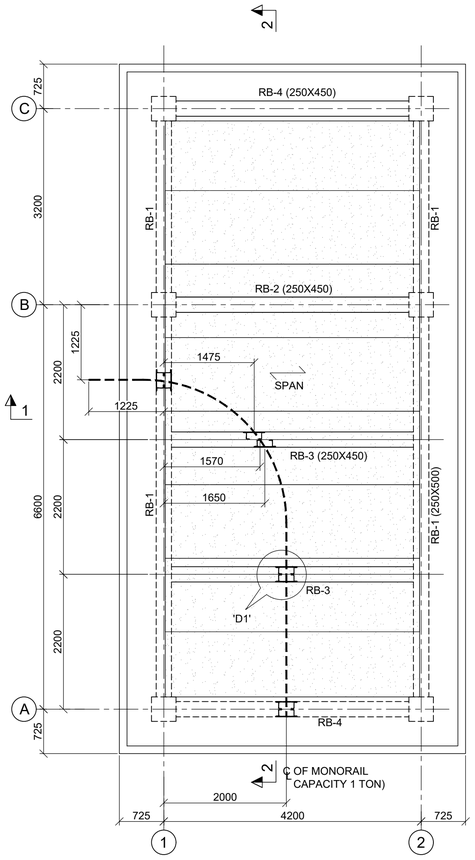


LAYOUT OF ROOF BEAM & HOLLOW CORE SLAB
SCALE 1:50

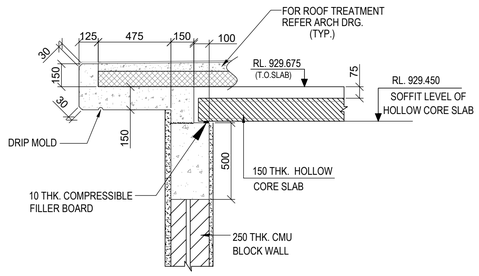


DETAIL-'X'
SCALE 1:20

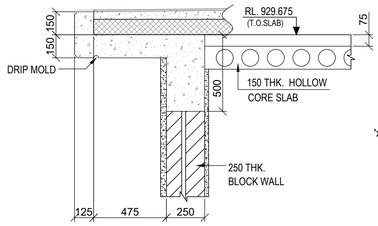

DETAIL-'Y'
SCALE 1:20

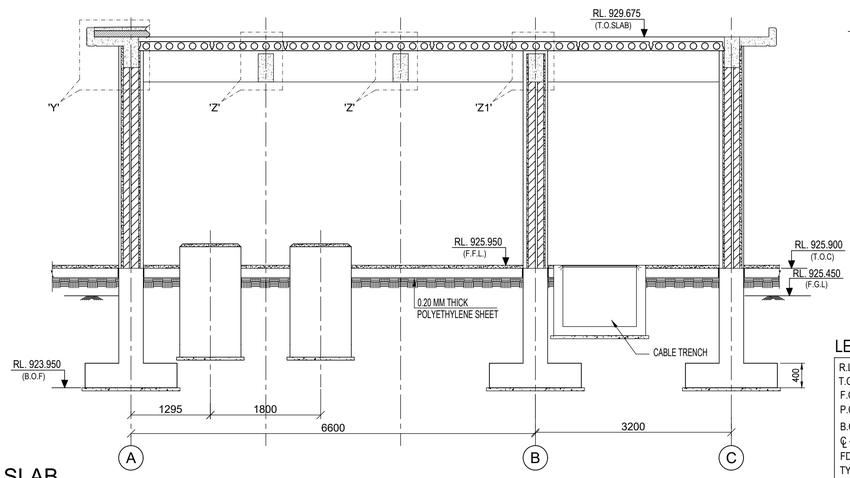

SECTION 2-2
SCALE 1:50

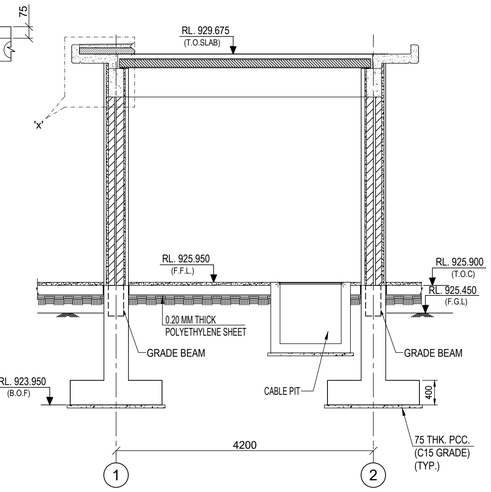

SECTION 1-1
SCALE 1:50

LEGEND :-

R.L.	REDUCED LEVEL
T.O.C	TOP OF CONCRETE
F.G.L	FINISHED GROUND LEVEL
P.C.C	PLAIN CEMENT CONCRETE
B.O.F	BOTTOM OF FOUNDATION
℄	CENTRELINE
FDN.	FOUNDATION
TYP.	TYPICAL.
F.F.L.	FINISHED FLOOR LEVEL
ARCH.	ARCHITECTURAL
BLDG.	BUILDING
SEC.	SECTION

NOTES :-

1. ALL DIMENSIONS ARE IN MILLIMETRES AND LEVELS AND CO-ORDINATES ARE IN METRES. UNLESS OTHERWISE STATED.
2. GRADE OF CONCRETE SHALL BE C35 FOR FOUNDATION.
3. GRADE OF REINFORCEMENT SHALL BE DEFORMED BAR ASTM A615 - GRADE 60 (fy = 420 MPa).
4. NET SAFE BEARING CAPACITY OF SOIL AT BOTTOM OF FOUNDATION CONSIDERED 350KN/SQ. M.
5. IF ANY PART OF FOUNDATION COMES ON BACKFILL ZONE OF ADJACENT FOUNDATION OR ANY LOOSE SOIL ARE ENCOUNTERED BELOW FOUNDATION LEVEL THE SAME SHALL BE REMOVED AND FILLED WITH PCC.
6. THIS DRG. SHALL BE READ IN CONJUNCTION WITH DRG. NO. MD-216-49WF-EG-CV-GAD-1001,1002 & 1004.
7. THE CONTENT OF THIS DRAWING SHALL CONFORM TO THE PROVISIONS OF CIVIL, STRUCTURAL AND ARCHITECTURAL DESIGN CRITERIA DOC. NO. MD-216-1000-EG-ST-CRT-1001.
8. FOR ARCHITECTURAL DRAWING REFER DRAWING NO. MD-216-49WF-EG-AR-GAD-3195.

DOCUMENT NUMBER	REFERENCE DOCUMENTS	REV	DATE	REVISION DESCRIPTION	DRN	CHK	ENG	APP	EMP
		D01	17/02/2023	AS-BUILT	SYA	SJM	SOR	AG	
		C01	07/03/2020	ISSUED FOR CONSTRUCTION	SYA	SJM	SOR	AG	
MD-216-49WF-EG-ME-LAD-1001	EQUIPMENT ARRGT. FOR BOREWELL PS (BH3)	A01	31/01/2020	ISSUED FOR REFERENCE	SYA	SJM	SOR	AG	

RESERVED FOR VENDOR LOGO AND DRAWING NUMBER

LARSEN & TOUBRO

This drawing is the property of LARSEN & TOUBRO and must not be passed on to any person or body not authorized by us to receive it nor be copied or otherwise made use either in full or in part by such person or body without our prior permission in writing.

Outotec

The content of these documents are the sole property of Outotec Oyj. Any rights not expressly granted herein are reserved. Reproduction, transfer or distribution of part or all of the contents in any form without prior written permission of Outotec is prohibited.

MA'ADEN معادن
Saudi Arabian Mining Company شركة التعدين العربية السعودية

This document and the information contained herein is Ma'aden proprietary know-how. This document or any part thereof should not be reproduced, stored in a retrieval system or transmitted by any means, electronic or otherwise, or divulged without prior written permission of Ma'aden.

DRAWN	SYA	28/01/2020	
CHECKED	SJM	30/01/2020	
ENGINEER	SOR	27/01/2020	
APPROVED	AG	31/01/2020	
EMPLOYER			
SCALE	1:50,20,10	A1	

LARSEN & TOUBRO DRAWING NUMBER: 019045_080_C_G_24956_003 — REVISION: 2

OUTOTEC DRAWING NUMBER: 900707__GAU01__AG32__MTL01__52003 — DOCUMENT ID: OU100671515 — REVISION: 2

MANSOURAH - MASSARAH GOLD PROJECT
GENERAL ARRANGEMENT DRAWING
BORE WELL PUMP HOUSE 3
LAYOUT OF BEAMS, BLDG. CROSS SEC. & DETAILS

DRAWING NUMBER: MD-216-49WF-EG-CV-GAD-1003 — REV: D01