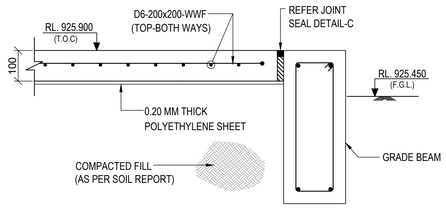
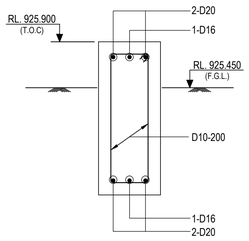
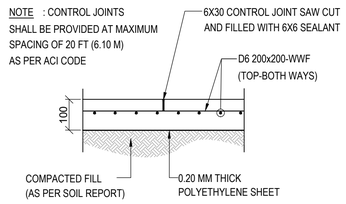
DRAWING NUMBER: MD-216-49WF-EG-CV-GAD-1004 | REV: D01



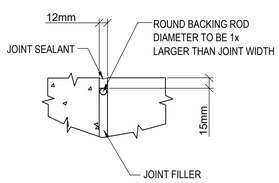

## TYP. SECTION FOR GRADE SLAB
SCALE 1:10



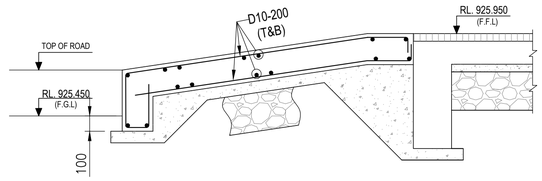

## R.C DETAILS OF GRADE BEAM MKD. GB-1
SCALE 1:10



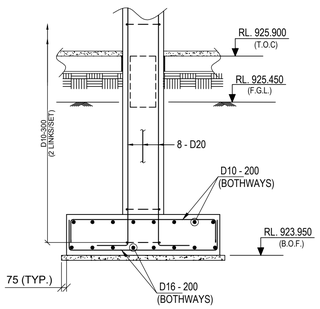

## TYP. CONTROL JOINT DETAIL
SCALE 1:10



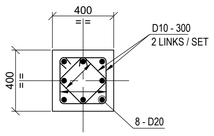

## TYP. JOINT SEAL DETAIL-C
SCALE 1:10



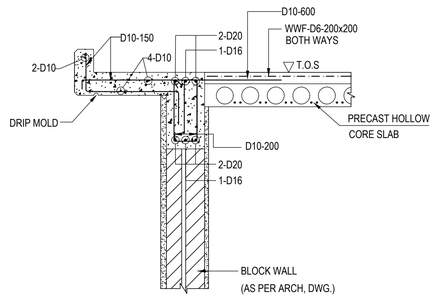

## TYP R.C DETAIL OF RAMP
SCALE 1:20



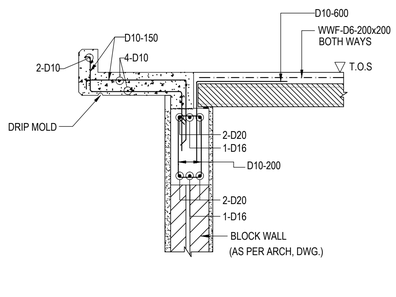

## SECTION A-A
SCALE 1:30



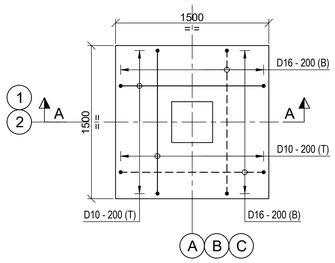

## RC. DET. OF C1
SCALE 1:20



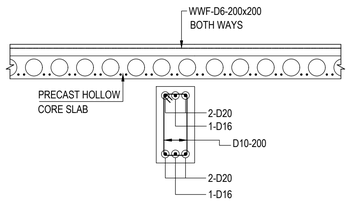

## DETAIL-'Y'
## (R.C DETAILS OF RB-4)
SCALE 1:20



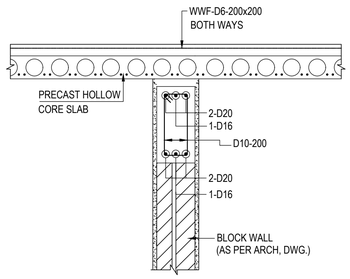

## DETAIL-'X'
## (R.C DETAILS OF RB-1)
SCALE 1:20




## R.C DETAILS OF FOUNDATION MKD. F1
(6 NOS. REQD.)
SCALE 1:30




## DETAIL-'Z'
## (R.C DETAILS OF RB-3)
SCALE 1:20




## DETAIL-'Z1'
## (R.C DETAILS OF RB-2)
SCALE 1:20

### LEGEND :-
R.L. - REDUCED LEVEL
T.O.C. - TOP OF CONCRETE.
F.G.L. - FINISHED GROUND LEVEL.
B.O.F. - BOTTOM OF FOUNDATION
TYP. - TYPICAL.
WWF. - WELDED WIRE FABRIC
P.C.C - PLAIN CEMENT CONCRETE
BOTTOM REINF.(B) - ————
TOP REINF.(T) - – – – – –

1. ALL DIMENSIONS ARE IN MILLIMETRES AND LEVELS AND CO-ORDINATES ARE IN METRES, UNLESS OTHERWISE STATED.
2. GRADE OF CONCRETE SHALL BE C35 FOR FOUNDATION.
3. GRADE OF REINFORCEMENT SHALL BE DEFORMED BAR ASTM A615 - GRADE 60 (fy = 420 MPa).
4. NET SAFE BEARING CAPACITY OF SOIL AT BOTTOM OF FOUNDATION CONSIDERED 350KN/SQ. M.
5. THE MINIMUM CONCRETE COVER AS PER SBC-304-2018( TABLE 20.6.1.3.1) MEASURED FROM REBAR SHALL BE
   a) CONCRETE CAST AGAINST & PERMANENTLY EXPOSED TO EARTH (INCLUDING FOUNDATIONS OVER SUB-SLAB) FORMED CONCRETE EXPOSED TO EARTH OR WEATHER.....50MM
   b.) CONCRETE NOT EXPOSED TO WEATHER NOR IN CONTACT WITH GROUND
   BEAMS, COLUMNS.....40MM
   SLABS, WALLS, JOISTS.....20MM
   c.) CONCRETE SLAB OVER 50MM SUB-SLAB.....20MM
6. MINIMUM LAP LENGTH OF REINFORCEMENT SHALL BE 40 x DIA. OF BAR.
7. THIS DRG. SHALL BE READ IN CONJUNCTION WITH DRG. NO. MD-216-49WF-EG-CV-GAD-1001,1002 & 1003.
8. FOR ARCHITECTURAL DRAWING REFER DRAWING NO. MD-216-49WF-EG-AR-GAD-3195.

| DOCUMENT NUMBER | REFERENCE DOCUMENTS | REV | DATE | REVISION DESCRIPTION | DRN | CHK | ENG | APP | EMP |
|---|---|---|---|---|---|---|---|---|---|
| | | D01 | 17/02/2023 | AS-BUILT | SYA | SJM | SOR | AG | |
| | | C01 | 07/03/2020 | ISSUED FOR CONSTRUCTION | SYA | SJM | SOR | AG | |
| MD-216-49WF-EG-ME-LAD-1001 | EQUIPMENT ARRGT. FOR BOREWELL PS (BH3) | A01 | 31/01/2020 | ISSUED FOR REFERENCE | SYA | SJM | SOR | AG | |

RESERVED FOR VENDOR LOGO AND DRAWING NUMBER

LARSEN & TOUBRO

This drawing is the property of LARSEN & TOUBRO and must not be passed on to any person or body not authorized by us to receive it nor be copied or otherwise made use either in full or in part by such person or body without our prior permission in writing.

Outotec

The content of these documents are the sole property of Outotec Oyj. Any rights not expressly granted herein are reserved. Reproduction, transfer or distribution of part or all of the contents in any form without prior written permission of Outotec is prohibited.

MA'ADEN معادن
Saudi Arabian Mining Company شركة التعدين العربية السعودية

This document and the information contained herein is Ma'aden proprietary know-how. This document or any part thereof should not be reproduced, stored in a retrieval system or transmitted by any means, electronic or otherwise, or divulged without prior written permission of Ma'aden.

LARSEN & TOUBRO DRAWING NUMBER: 019045_080_C_G_24956_004 | REVISION: 2
OUTOTEC DRAWING NUMBER: 900707__GAU01__AG32__MTL01__52004 | DOCUMENT ID: OU100671516 | REVISION: 2

| | | |
|---|---|---|
| DRAWN | SYA | 28/01/2020 |
| CHECKED | SJM | 30/01/2020 |
| ENGINEER | SOR | 27/01/2020 |
| APPROVED | AG | 31/01/2020 |
| EMPLOYER | | |
| SCALE | 1:30,20,10 | A1 |

MANSOURAH - MASSARAH GOLD PROJECT
GENERAL ARRANGEMENT DRAWING
BORE WELL PUMP HOUSE 3
R.C DETAILS

DRAWING NUMBER: MD-216-49WF-EG-CV-GAD-1004 | REV: D01