


DRAWING NUMBER: MD-216-49WF-EG-CV-GAD-1005 | REV: D01

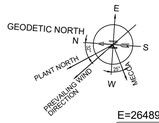

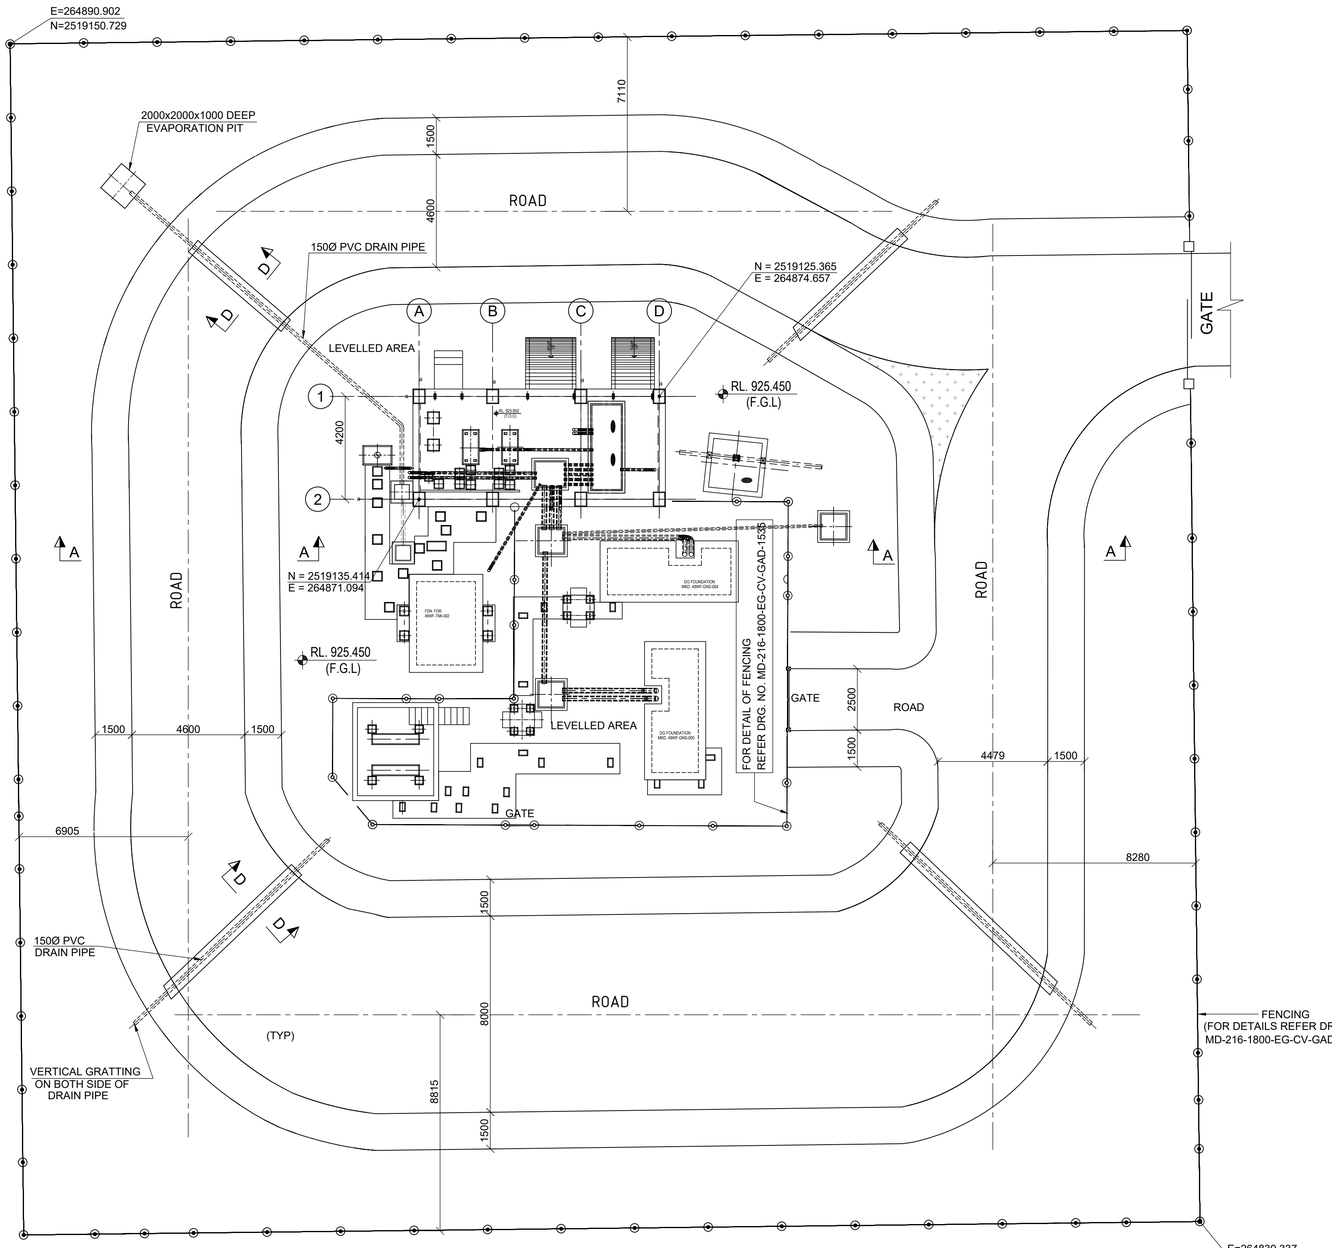

LAYOUT OF BORE WELL PUMP HOUSE-4 AREA
(SHOWING ROAD, DRAINAGE & FENCE PLAN)

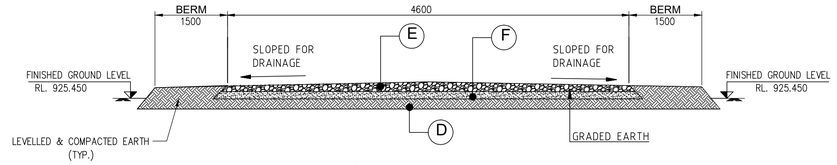


ROAD COMPOSITION

E - 100mm STABILIZED GRAVEL BASE
F - 150mm AGGREGATE SUB-BASE
D - SUITABLE SUBGRADE - COMPACTED EARTH, AVERAGE 100 MM. SUBGRADE

SECTION A-A
SCALE 1:50

TYPICAL CROSS SECTION - GRADED ROAD SINGLE LANE EARTH - TYPE F

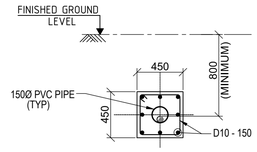

SECTION D - D
SCALE 1:30

NOTES :-

1. ALL DIMENSIONS ARE IN MILLIMETRES AND LEVELS AND CO-ORDINATES ARE IN METRES. UNLESS OTHERWISE STATED.
2. GRADE OF CONCRETE SHALL BE C35 FOR FOUNDATION.
3. GRADE OF REINFORCEMENT SHALL BE DEFORMED BAR ASTM A615 - GRADE 60 (fy = 420 MPa).
4. THIS DRG. SHALL BE READ IN CONJUNCTION WITH DRG. NO. MD-216-49WF-EG-CV-GAD-1006,1007 & 1008.
5. THE CONTENT OF THIS DRAWING SHALL CONFORM TO THE PROVISIONS OF CIVIL, STRUCTURAL AND ARCHITECTURAL DESIGN CRITERIA DOC. NO. MD-216-1000-EG-ST-CRT-1001.
6. FOR GENERAL NOTES REFER DRG. NO. MD-216-1000-EG-CV-DED-1001, 1002 & MD-216-1000-EG-ST-DED-1001.
7. FOR OTHER NOTES REFER ALL DRAWINGS OF STORM WATER DRAIN VIZ. MD-216-49EA-EG-CV-GAD-1001,1002 & MD-216-49EA-EG-CV-DED-1001,1002

DOCUMENT NUMBER	REFERENCE DOCUMENTS	REV	DATE	REVISION DESCRIPTION	DRN	CHK	ENG	APP	EMP
		D01	17/02/2023	AS-BUILT	AMJ	SJM	AVG	AG	
		C03	13/05/2022	ISSUED FOR CONSTRUCTION & GENERALLY REVISED	AMJ	SJM	AVG	AG	
		C02	21/04/2021	ISSUED FOR CONSTRUCTION & REVISED AS MARKED C02	SYA	SJM	SOR	AG	
		C01	07/03/2020	ISSUED FOR CONSTRUCTION	SYA	SJM	SOR	AG	
MD-216-49WF-EG-ME-LAD-1002	EQUIPMENT ARRGT. FOR BOREWELL PS (BH4)	A01	31/01/2020	ISSUED FOR REFERENCE	SYA	SJM	SOR	AG	

RESERVED FOR VENDOR LOGO AND DRAWING NUMBER

LARSEN & TOUBRO DRAWING NUMBER: 019045_080_C_G_24957_001 | REVISION: 4
OUTOTEC DRAWING NUMBER: 900707__GAU01__AG32__MLT01__52005 | DOCUMENT ID: OU100671517 | REVISION: 4

LARSEN & TOUBRO
This drawing is the property of LARSEN & TOUBRO and must not be passed on to any person or body not authorized by us to receive it nor be copied or otherwise made use either in full or in part by such person or body without our prior permission in writing.

Outotec
The content of these documents are the sole property of Outotec Oyj. Any rights not expressly granted herein are reserved. Reproduction, transfer or distribution of part or all of the contents in any form without prior written permission of Outotec is prohibited.

MA'ADEN معادن
Saudi Arabian Mining Company شركة التعدين العربية السعودية
This document and the information contained herein is Ma'aden proprietary know-how. This document or any part thereof should not be reproduced, stored in a retrieval system or transmitted by any means, electronic or otherwise, or divulged without prior written permission of Ma'aden.

DRAWN	SYA	28/01/2020	MANSOURAH - MASSARAH GOLD PROJECT
CHECKED	SJM	30/01/2020	GENERAL ARRANGEMENT DRAWING
ENGINEER	SOR	27/01/2020	BORE WELL PUMP HOUSE 4
APPROVED	AG	31/01/2020	LAYOUT DETAILS OF BORE WELL PH 4 AREA
EMPLOYER			
SCALE 1:50		A1	DRAWING NUMBER: MD-216-49WF-EG-CV-GAD-1005 | REV: D01