

DRAWING NUMBER MD-216-49WF-EG-CV-GAD-1007 REV D01

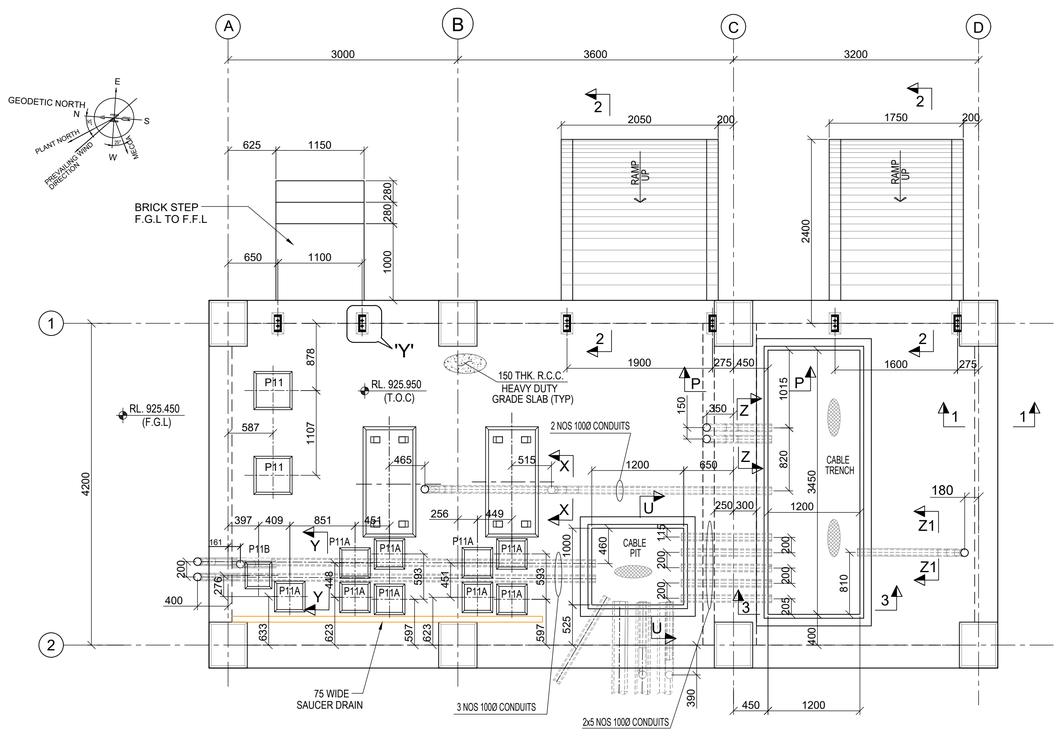


GRADE SLAB PLAN OF BORE WELL PUMP HOUSE 4

SCALE 1:50

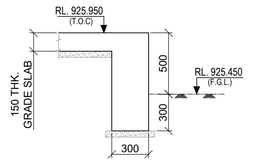


SECTION 1-1

(SCALE 1:25)

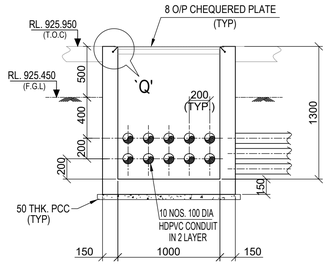


SECTION U - U

SCALE 1:30

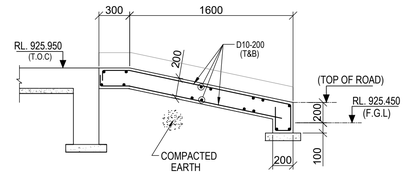


SECTION 2-2

SCALE 1:30

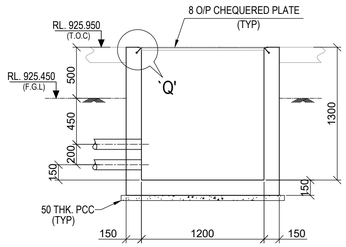


SECTION 3 - 3

SCALE 1:30

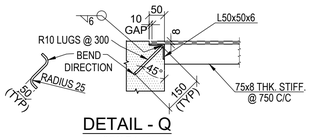


DETAIL - Q

(SCALE 1:10)

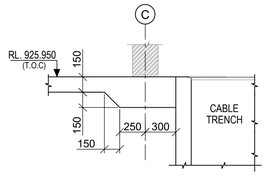


SECTION P - P

SCALE 1:30

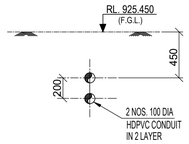

SECTION X-X

SCALE 1:30

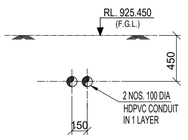


SECTION Z-Z

SCALE 1:30


LEGEND :-

R.L. - REDUCED LEVEL
T.O.C - TOP OF CONCRETE
F.G.L - FINISHED GROUND LEVEL
P.C.C - PLAIN CEMENT CONCRETE
B.O.F - BOTTOM OF FOUNDATION
℄ - CENTRELINE
FDN. - FOUNDATION
TYP. - TYPICAL.
F.F.L. - FINISHED FLOOR LEVEL
ARCH. - ARCHITECTURAL
BLDG. - BUILDING
SEC. - SECTION
THK. - THICK
PL. - PLATE
MR - MONORAIL
T.O.B - TOP OF BEAM

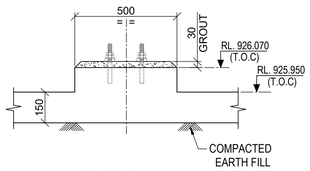


SECTION L - L

SCALE 1:15

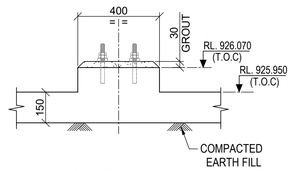


SECTION L1 - L1

SCALE 1:15

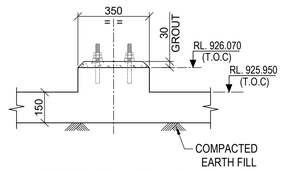


SECTION L2 - L2

SCALE 1:15

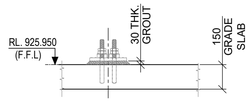


SECTION H - H

(SCALE 1:=25)

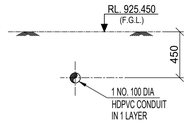


SECTION Z1-Z1

SCALE 1:30

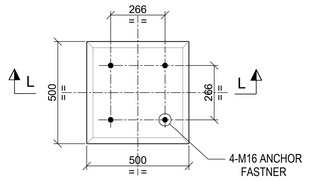


DETAIL OF PEDESTAL MKD. P11

SCALE 1:15

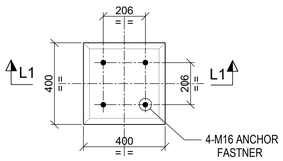


DETAIL OF PEDESTAL MKD. P11A

SCALE 1:15

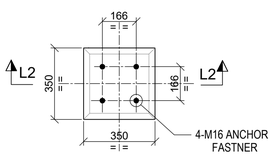


DETAIL OF PEDESTAL MKD. P11B

SCALE 1:15

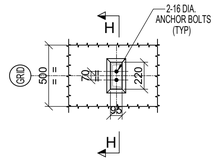

DETAIL - 'Y'

(SCALE 1:25)

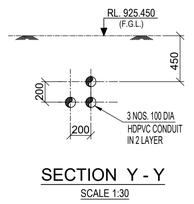

SECTION Y - Y

SCALE 1:30

NOTES :-

1. ALL DIMENSIONS ARE IN MILLIMETRES AND LEVELS AND CO-ORDINATES ARE IN METRES. UNLESS OTHERWISE STATED.
2. GRADE OF CONCRETE SHALL BE C35 FOR FOUNDATION.
3. GRADE OF REINFORCEMENT SHALL BE DEFORMED BAR ASTM A615 - GRADE 60 (fy = 420 MPa).
4. THE CONTENT OF THIS DRAWING SHALL CONFORM TO THE PROVISIONS OF CIVIL, STRUCTURAL AND ARCHITECTURAL DESIGN CRITERIA DOC. NO. MD-216-1000-EG-ST-CRT-1001.
5. FOR ARCHITECTURAL DRAWING REFER DRAWING NO. MD-216-49WF-EG-AR-GAD-3195.
6. FOR GENERAL NOTES REFER DRG. NO. MD-216-1000-EG-CV-DED-1001, 1002 & MD-216-1000-EG-ST-DED-1001.

THIS DRG. SHALL BE READ IN CONJUNCTION WITH DRG. NO. MD-216-49WF-EG-CV-GAD-1005,1006 & 1008.

SHEET 1 OF 2

DOCUMENT NUMBER	REFERENCE DOCUMENTS	REV	DATE	REVISION DESCRIPTION	DRN	CHK	ENG	APP	EMP
		D01	17/02/2023	AS-BUILT	AMJ	SJM	AVG	AG	
		C05	13/05/2022	ISSUED FOR CONSTRUCTION & GENERALLY REVISED	AMJ	SJM	AVG	AG	
		C04	04/08/2021	ISSUED FOR CONSTRUCTION & REVISED AS MARKED C04	SYA	SJM	SOR	AG	
		C03	09/06/2021	ISSUED FOR CONSTRUCTION & REVISED AS MARKED C03	SYA	SJM	SOR	AG	
		C02	21/04/2021	ISSUED FOR CONSTRUCTION & REVISED AS MARKED C02	SYA	SJM	SOR	AG	
		C01	07/03/2020	ISSUED FOR CONSTRUCTION	SYA	SJM	SOR	AG	
MD-216-49WF-EG-ME-LAD-1002	EQUIPMENT ARRGT. FOR BOREWELL PS (BH4)	A01	31/01/2020	ISSUED FOR REFERENCE	SYA	SJM	SOR	AG	

RESERVED FOR VENDOR LOGO AND DRAWING NUMBER

LARSEN & TOUBRO DRAWING NUMBER 019045_080_C_G_24957_003 — REVISION 6

OUTOTEC DRAWING NUMBER 900707__GAU01__AG32__MLT01__52007 — DOCUMENT ID OU100671519 — REVISION 6

LARSEN & TOUBRO

This drawing is the property of LARSEN & TOUBRO and must not be passed on to any person or body not authorized by us to receive it nor be copied or otherwise made use either in full or in part by such person or body without our prior permission in writing.

Outotec

The content of these documents are the sole property of Outotec Oyj. Any rights not expressly granted herein are reserved. Reproduction, transfer or distribution of part or all of the contents in any form without prior written permission of Outotec is prohibited.

MA'ADEN معادن
Saudi Arabian Mining Company شركة التعدين العربية السعودية


This document and the information contained herein is Ma'aden proprietary know-how. This document or any part thereof should not be reproduced, stored in a retrieval system or transmitted by any means, electronic or otherwise, or divulged without prior written permission of Ma'aden.

DRAWN	SYA	28/01/2020
CHECKED	SJM	30/01/2020
ENGINEER	SOR	27/01/2020
APPROVED	AG	31/01/2020
EMPLOYER		
SCALE	1:50,20,10	A1

MANSOURAH - MASSARAH GOLD PROJECT
GENERAL ARRANGEMENT DRAWING
BORE WELL PUMP HOUSE 4
LAYOUT OF BEAMS, BLDG. CROSS SEC. & DETAILS


DRAWING NUMBER MD-216-49WF-EG-CV-GAD-1007 — REV D01

DRAWING NUMBER MD-216-49WF-EG-CV-GAD-1007 REV D01

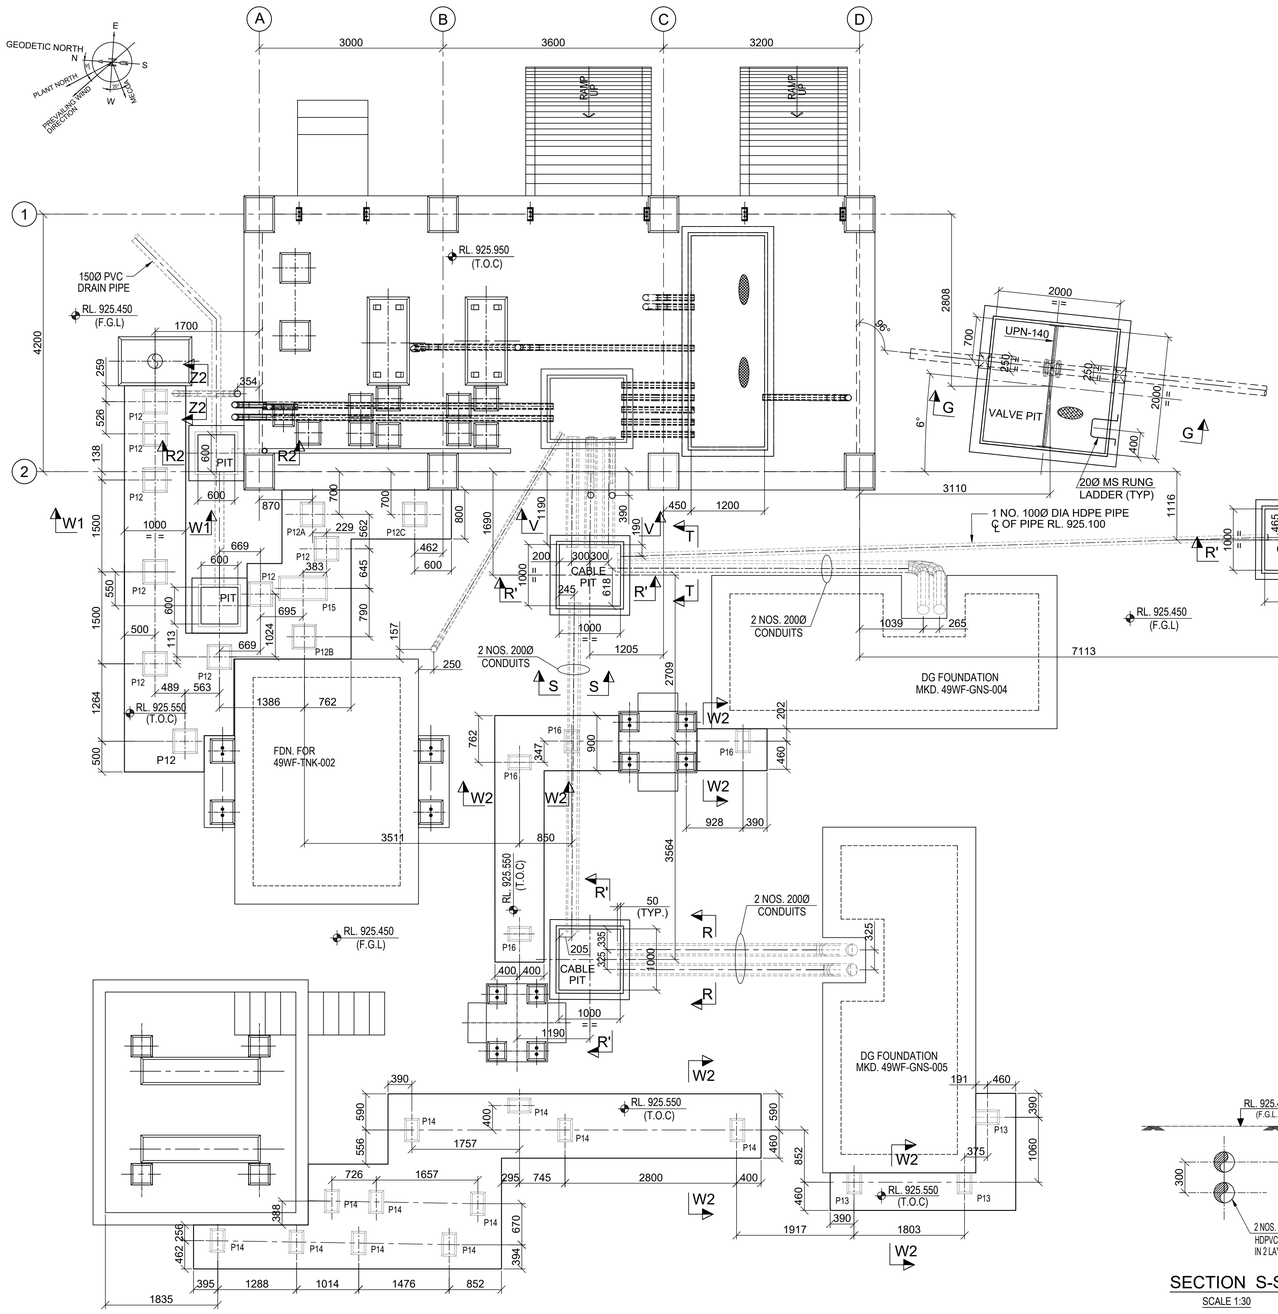

LAYOUT OF PIPE SUPPORT

SCALE 1:50

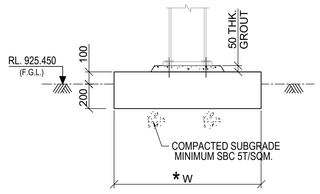


SECTION W1-W1

(CROSS SECTION OF FDN. OF PIPE SUPPORT MKD. P12, P12A, P12B, P12C & P15)

* NOTE: 'W' REFER LAYOUT PLAN

SCALE 1:25

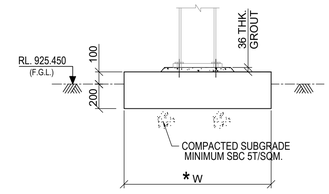


SECTION W2-W2

(CROSS SECTION OF FDN. OF PIPE SUPPORT MKD. P13, P14 & P16)


* NOTE: 'W' REFER LAYOUT PLAN

SCALE 1:25

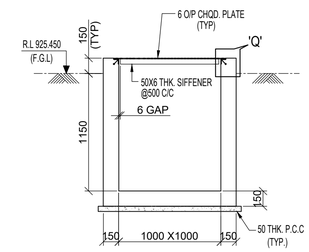


SECTION R' - R'

(SCALE 1:30)

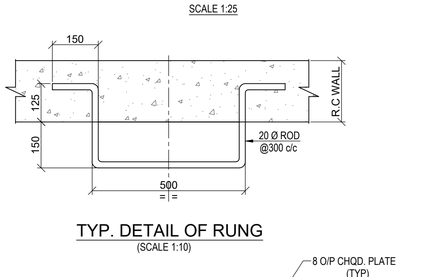


TYP. DETAIL OF RUNG

(SCALE 1:10)

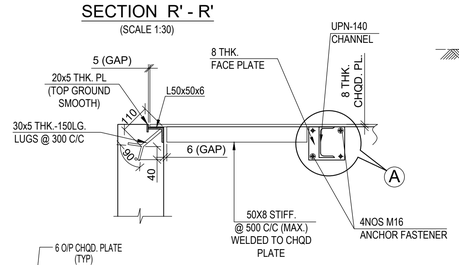


DETAIL - 'X'

SCALE= 1:10

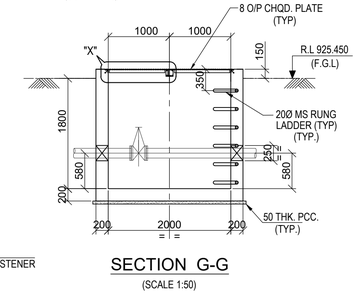


SECTION G-G

(SCALE 1:50)

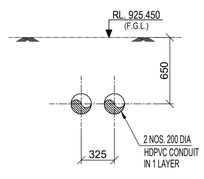


SECTION R-R

SCALE 1:30

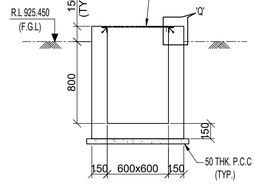


SECTION R2 - R2

(SCALE 1:30)

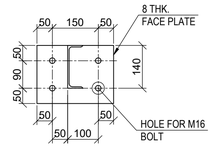


DETAIL - 'A'

SCALE 1:10

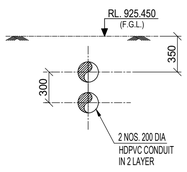


SECTION S-S

SCALE 1:30

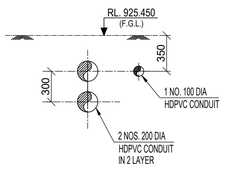


SECTION T-T

SCALE 1:30

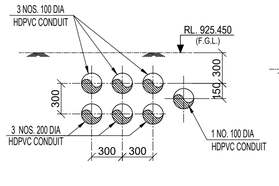

SECTION V-V

SCALE 1:30

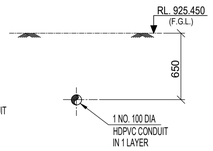

SECTION Z2 - Z2

SCALE 1:30

THIS DRG. SHALL BE READ IN CONJUNCTION WITH DRG. NO. MD-216-49WF-EG-CV-GAD-1005,1006 & 1008.

LEGEND :-

R.L. - REDUCED LEVEL
T.O.C - TOP OF CONCRETE
F.G.L - FINISHED GROUND LEVEL
P.C.C - PLAIN CEMENT CONCRETE
B.O.F - BOTTOM OF FOUNDATION
℄ - CENTRELINE
FDN. - FOUNDATION
TYP. - TYPICAL
F.F.L - FINISHED FLOOR LEVEL
ARCH. - ARCHITECTURAL
BLDG. - BUILDING
SEC. - SECTION
THK. - THICK
PL. - PLATE
MR - MONORAIL
T.O.B - TOP OF BEAM

NOTES :-

1. ALL DIMENSIONS ARE IN MILLIMETRES AND LEVELS AND CO-ORDINATES ARE IN METRES. UNLESS OTHERWISE STATED.
2. GRADE OF CONCRETE SHALL BE C35 FOR FOUNDATION.
3. GRADE OF REINFORCEMENT SHALL BE DEFORMED BAR ASTM A615 - GRADE 60 (fy = 420 MPa).
4. THE CONTENT OF THIS DRAWING SHALL CONFORM TO THE PROVISIONS OF CIVIL, STRUCTURAL AND ARCHITECTURAL DESIGN CRITERIA DOC. NO. MD-216-1000-EG-ST-CRT-1001.
5. FOR ARCHITECTURAL DRAWING REFER DRAWING NO. MD-216-49WF-EG-AR-GAD-3195.
6. FOR GENERAL NOTES REFER DRG. NO. MD-216-1000-EG-CV-DED-1001, 1002 & MD-216-1000-EG-ST-DED-1001.

SHEET 2 OF 2

DOCUMENT NUMBER	REFERENCE DOCUMENTS	REV	DATE	REVISION DESCRIPTION	DRN	CHK	ENG	APP	EMP
		D01	17/02/2023	AS-BUILT	AMJ	SJM	AVG	AG	
		C05	13/05/2022	ISSUED FOR CONSTRUCTION & GENERALLY REVISED	AMJ	SJM	AVG	AG	
		C04	04/08/2021	ISSUED FOR CONSTRUCTION & REVISED AS MARKED C04	SYA	SJM	SOR	AG	
		C03	09/06/2021	ISSUED FOR CONSTRUCTION & REVISED AS MARKED C03	SYA	SJM	SOR	AG	
		C02	21/04/2021	ISSUED FOR CONSTRUCTION & REVISED AS MARKED C02	SYA	SJM	SOR	AG	
		C01	07/03/2020	ISSUED FOR CONSTRUCTION	SYA	SJM	SOR	AG	
MD-216-49WF-EG-ME-LAD-1002	EQUIPMENT ARRGT. FOR BOREWELL PS (BH4)	A01	31/01/2020	ISSUED FOR REFERENCE	SYA	SJM	SOR	AG	

RESERVED FOR VENDOR LOGO AND DRAWING NUMBER

LARSEN & TOUBRO

This drawing is the property of LARSEN & TOUBRO and must not be passed on to any person or body not authorized by us to receive it nor be copied or otherwise made use either in full or in part by such person or body without our prior permission in writing.

Outotec

The content of these documents are the sole property of Outotec Oyj. Any rights not expressly granted herein are reserved. Reproduction, transfer or distribution of part or all of the contents in any form without prior written permission of Outotec is prohibited.

MA'ADEN معادن Saudi Arabian Mining Company شركة المعادن العربية السعودية

This document and the information contained herein is Ma'aden proprietary know-how. This document or any part thereof should not be reproduced, stored in a retrieval system or transmitted by any means, electronic or otherwise, or divulged without prior written permission of Ma'aden.

LARSEN & TOUBRO DRAWING NUMBER		REVISION
019045_080_C_G_24957_003		6
OUTOTEC DRAWING NUMBER	DOCUMENT ID	REVISION
900707__GAU01__AG32__MLT01__52007	OU100671519	6

DRAWN	SYA	28/01/2020
CHECKED	SJM	30/01/2020
ENGINEER	SOR	27/01/2020
APPROVED	AG	31/01/2020
EMPLOYER		
SCALE	1:50,20,10	A1

MANSOURAH - MASSARAH GOLD PROJECT
GENERAL ARRANGEMENT DRAWING
BORE WELL PUMP HOUSE 4
LAYOUT OF BEAMS, BLDG. CROSS SEC. & DETAILS

DRAWING NUMBER MD-216-49WF-EG-CV-GAD-1007 REV D01