


DRAWING NUMBER MD-216-49WF-EG-CV-GAD-1008 REV D01

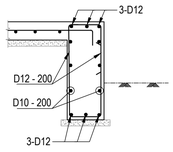


SECTION 1-1
(REFER DRG. NO. MD-216-49WF-EG-CV-GAD-1007)
(SCALE 1:25)

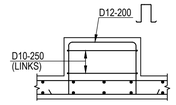


R.C DETAIL OF PEDESTAL MKD. P11, P11A & P11B
(SCALE - 1:20)

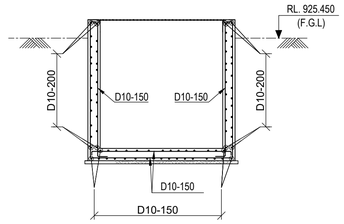


SECTION G-G (RC DETAIL)
(REFER DRG. NO. MD-216-49WF-EG-CV-GAD-1007)
SCALE 1:50

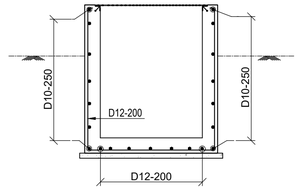


TYP. RCC DETAIL OF CABLE PITS
(REFER DRG. NO. MD-216-49WF-EG-CV-GAD-1007)
SCALE 1:30

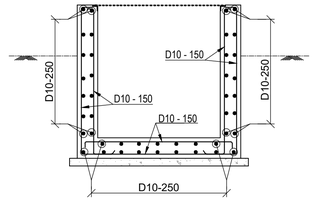


SECTION 3 - 3
RC DETAILS OF CABLE TRENCH
(REFER DRG. NO. MD-216-49WF-EG-CV-GAD-1007)
SCALE 1:30

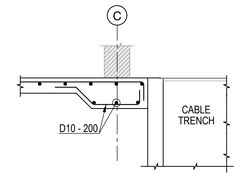


SECTION P - P
(REFER DRG. NO. MD-216-49WF-EG-CV-GAD-1007)
SCALE 1:30

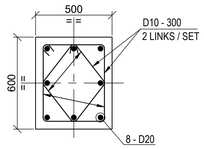


SECTION X-X
(RC. DET. OF PEDESTAL MKD. C1)
SCALE 1:20

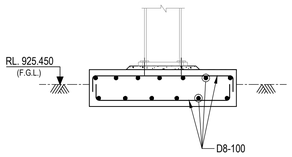


SECTION W1-W1 & W2-W2
(SHOWING RC DETAIL)
(REFER DRG. NO. MD-216-49WF-EG-CV-GAD-1007)
SCALE 1:25

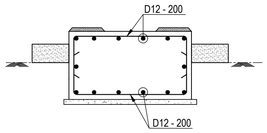


SECTION 9-9
(RC DETAIL OF P8 & P9)
(REFER DRG. NO. MD-216-49WF-EG-CV-GAD-1006)
(SCALE 1:25)

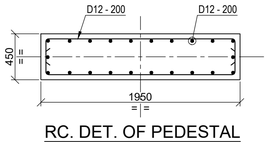


RC. DET. OF PEDESTAL MKD. P10A
SCALE 1:30

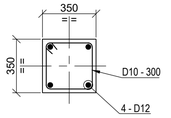


RC. DET. OF PEDESTAL MKD. P10
SCALE 1:20

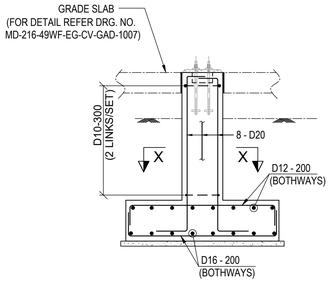


SECTION 1-1
(REFER DRG. NO. MD-216-49WF-EG-CV-GAD-1006)
SCALE 1:30

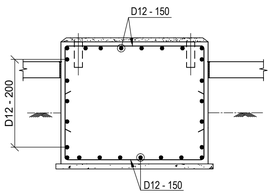


SECTION 4-4
(RC DETAIL OF F4)
(REFER DRG. NO. MD-216-49WF-EG-CV-GAD-1006)
SCALE 1:30

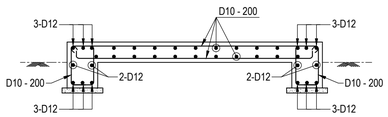


SECTION 3-3
(RC DETAIL OF F3)
(REFER DRG. NO. MD-216-49WF-EG-CV-GAD-1006)
(SCALE 1:30)

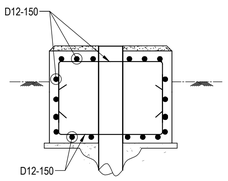


SECTION 6 - 6
SCALE 1:30

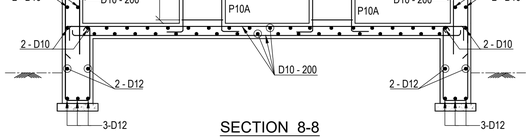


SECTION 8-8
(RC DETAIL OF F7)
(REFER DRG. NO. MD-216-49WF-EG-CV-GAD-1006)
(SCALE 1:30)

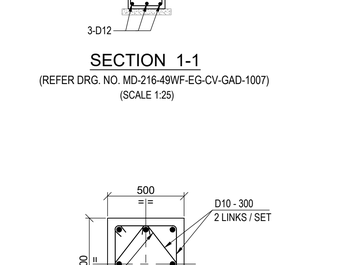


R.C DETAILS OF FOUNDATION MKD. F1
(8 NOS. REQD.)
(REFER DRG. NO. MD-216-49WF-EG-CV-GAD-1006)
SCALE 1:30

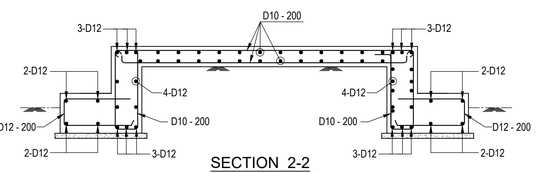

SECTION 2-2
(RC DETAIL OF F2)
(REFER DRG. NO. MD-216-49WF-EG-CV-GAD-1006)
(SCALE 1:30)

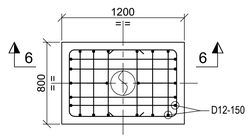

R.C DETAIL OF FDN. MKD. F5
(1 NO. REQD.)
(REFER DRG. NO. MD-216-49WF-EG-CV-GAD-1006)
SCALE 1:30

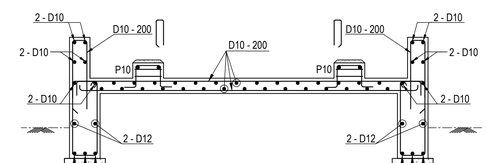

SECTION 7-7
(RC DETAIL OF F7)
(REFER DRG. NO. MD-216-49WF-EG-CV-GAD-1006)
(SCALE 1:30)

LEGEND :-
R.L. - REDUCED LEVEL
T.O.C. - TOP OF CONCRETE.
F.G.L. - FINISHED GROUND LEVEL.
B.O.F. - BOTTOM OF FOUNDATION
TYP. - TYPICAL.
WWF. - WELDED WIRE FABRIC
P.C.C - PLAIN CEMENT CONCRETE
BOTTOM REINF.(B) - ————
TOP REINF.(T) - – – – – –

NOTES :-
1. ALL DIMENSIONS ARE IN MILLIMETRES AND LEVELS AND CO-ORDINATES ARE IN METRES. UNLESS OTHERWISE STATED.
2. GRADE OF CONCRETE SHALL BE C35 FOR FOUNDATION & C15 FOR PCC.
3. GRADE OF REINFORCEMENT SHALL BE DEFORMED BAR ASTM A615 - GRADE 60 (fy = 420 MPa).
4. NET SAFE BEARING CAPACITY OF SOIL AT BOTTOM OF FOUNDATION CONSIDERED 350KN/ SQ. M. FOR FOUNDATION MARKED F1 & 100KN/SQ. M. FOR OTHER SHALLOW FOUNDATION.
5. IF ANY PART OF FOUNDATION COMES ON BACKFILL ZONE OF ADJACENT FOUNDATION OR ANY LOOSE SOIL ARE ENCOUNTERED BELOW FOUNDATION LEVEL THE SAME SHALL BE REMOVED AND FILLED WITH PCC (C15).
6. THE CONTENT OF THIS DRAWING SHALL CONFORM TO THE PROVISIONS OF CIVIL, STRUCTURAL AND ARCHITECTURAL DESIGN CRITERIA DOC. NO. MD-216-1000-EG-ST-CRT-1001 AND MD-216-1000-EG-CV-DED-1002 & 1005.

THIS DRG. SHALL BE READ IN CONJUNCTION WITH DRG. NO. MD-216-49WF-EG-CV-GAD-1005,1006 & 1007.

DOCUMENT NUMBER	REFERENCE DOCUMENTS	REV	DATE	REVISION DESCRIPTION	DRN	CHK	ENG	APP	EMP
		D01	17/02/2023	AS-BUILT	AMJ	SJM	AVG	AG	
		C05	13/05/2022	ISSUED FOR CONSTRUCTION & GENERALLY REVISED	AMJ	SJM	AVG	AG	
		C04	04/08/2021	ISSUED FOR CONSTRUCTION & REVISED AS MARKED C04	SYA	SJM	SOR	AG	
		C03	09/06/2021	ISSUED FOR CONSTRUCTION & REVISED AS MARKED C03	SYA	SJM	SOR	AG	
		C02	21/04/2021	ISSUED FOR CONSTRUCTION & REVISED AS MARKED C02	SYA	SJM	SOR	AG	
		C01	07/03/2020	ISSUED FOR CONSTRUCTION	SYA	SJM	SOR	AG	
MD-216-49WF-EG-ME-LAD-1002	EQUIPMENT ARRGT. FOR BOREWELL PS (BH4)	A01	31/01/2020	ISSUED FOR REFERENCE	SYA	SJM	SOR	AG	

RESERVED FOR VENDOR LOGO AND DRAWING NUMBER

LARSEN & TOUBRO DRAWING NUMBER: O19045_080_C_G_24957_004 — REVISION: 6
OUTOTEC DRAWING NUMBER: 900707__GAU01__AG32__MLT01__52008 — DOCUMENT ID: OU100671520 — REVISION: 6

LARSEN & TOUBRO
This drawing is the property of LARSEN & TOUBRO and must not be passed on to any person or body not authorized by us to receive it nor be copied or otherwise made use either in full or in part by such person or body without our prior permission in writing.

Outotec
The content of these documents are the sole property of Outotec Oyj. Any rights not expressly granted herein are reserved. Reproduction, transfer or distribution of part or all of the contents in any form without prior written permission of Outotec is prohibited.

MA'ADEN معادن
Saudi Arabian Mining Company شركة معادن العربية السعودية
This document and the information contained herein is Ma'aden proprietary know-how. This document or any part thereof should not be reproduced, stored in a retrieval system or transmitted by any means, electronic or otherwise, or divulged without prior written permission of Ma'aden.

DRAWN	SYA	28/01/2020
CHECKED	SJM	30/01/2020
ENGINEER	SOR	27/01/2020
APPROVED	AG	31/01/2020
EMPLOYER		
SCALE	1:30,20,10	A1

MANSOURAH - MASSARAH GOLD PROJECT
GENERAL ARRANGEMENT DRAWING
BORE WELL PUMP HOUSE 4
R.C DETAILS

DRAWING NUMBER: MD-216-49WF-EG-CV-GAD-1008 — REV: D01