


DRAWING NUMBER MD-216-49WF-EG-CV-GAD-1009 REV D01

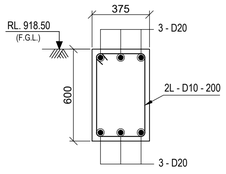


RC. DET. OF PB1
SCALE 1:20

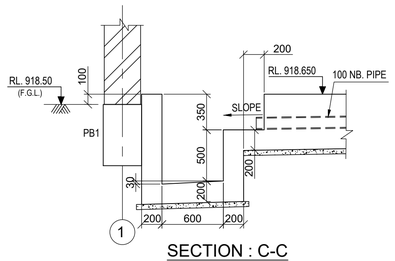


SECTION : C-C
SCALE 1:30

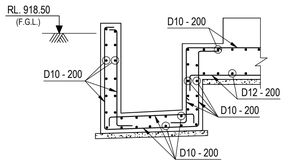


SECTION : C-C
(RC. DETAIL)
SCALE 1:30

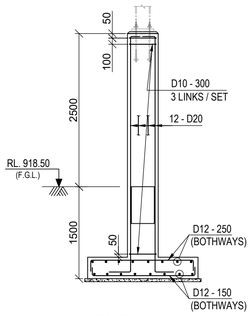


SECTION : A'-A'
SCALE 1:50

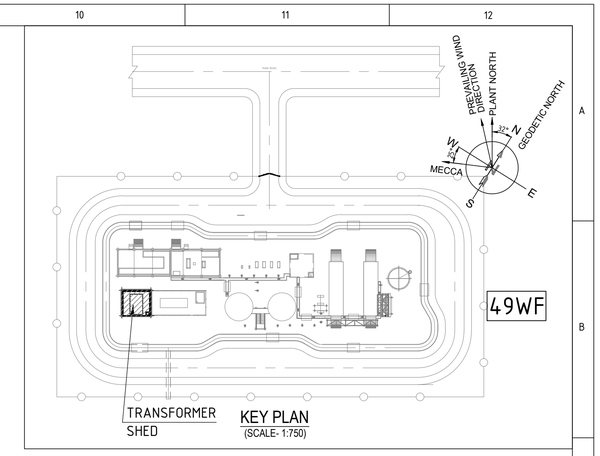


KEY PLAN
(SCALE- 1:750)

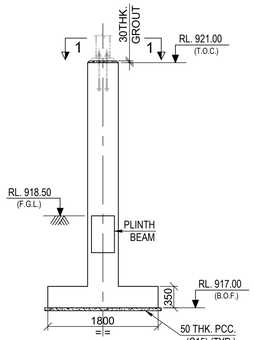


SECTION : B-B
SCALE 1:50

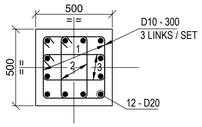


RC. DET. OF COLUMN
MKD. C1
SCALE 1:20

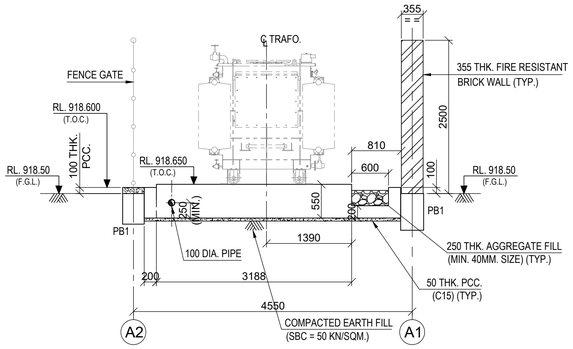


SECTION : A-A
SCALE 1:50

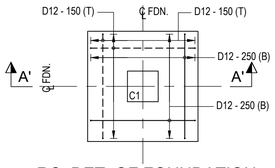


RC. DET. OF FOUNDATION
MKD. F1
SCALE 1:50

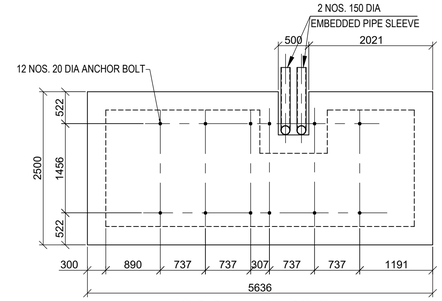


TOP PLAN OF DG SET
SCALE 1:25

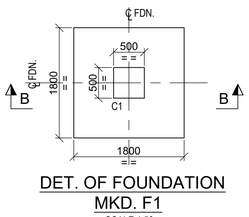


DET. OF FOUNDATION
MKD. F1
SCALE 1:50

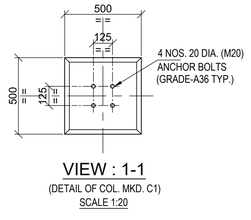


VIEW : 1-1
(DETAIL OF COL. MKD. C1)
SCALE 1:20

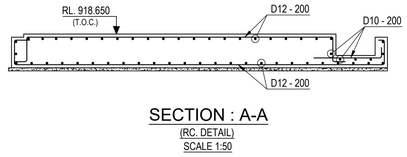


SECTION : A-A
(RC. DETAIL)
SCALE 1:50

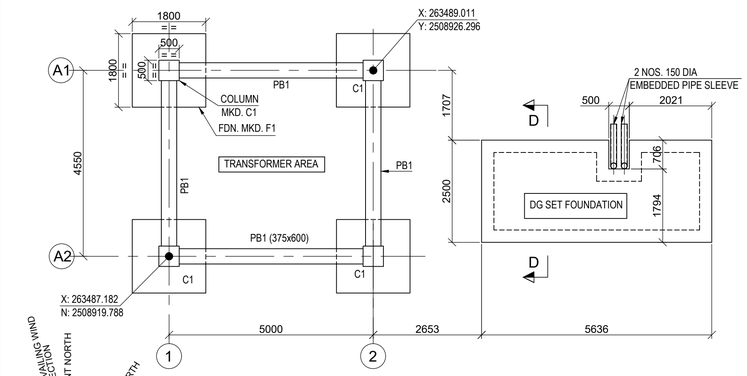

LAYOUT OF TRANSFORMER FOUNDATION & DG SET FOUNDATION
SCALE 1:75

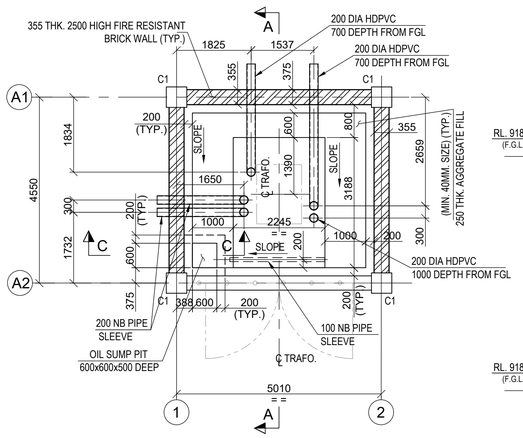


LAYOUT OF TRANSFORMER AREA
SCALE 1:75

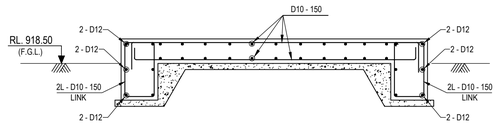

SECTION : D-D
SCALE 1:25

R.C DETAIL OF DG SET FOUDATION

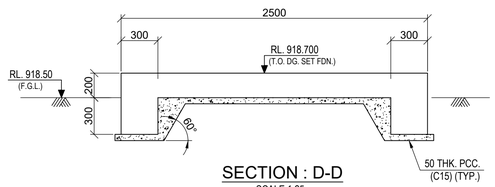

SECTION : D-D
SCALE 1:25

LEGENDS :-

R.L. - REDUCED LEVEL
℄ - CENTRE LINE
T.O.C. - TOP OF CONCRETE
TYP. - TYPICAL
T.O.G. - TOP OF GROUT
T.O. - TOP OF
B.O.F. - BOTTOM OF FOUNDATION
FDN. - FOUNDATION
F.G.L. - FINISHED GROUND LEVEL.
P.C.C - PLAIN CEMENT CONCRETE
THK. - THICK
R.C. - REINFORCED CONCRETE
MKD. - MARKED
MIN.- MINIMUM
TRAFO.- TRANSFORMER
DIA. - DIAMETER
BOTTOM REINFORCEMENT (B) - ————
TOP REINFORCEMENT (T) - – – – – –

NOTES:-

1. ALL DIMENSIONS ARE IN MILLIMETRES AND LEVELS AND CO-ORDINATES ARE IN METRES UNLESS OTHERWISE STATED.
2. NET SAFE BEARING CAPACITY OF SOIL AT BOTTOM OF FOUNDATION IS CONSIDERED AS 450KN/ SQ. M.
3. GRADE OF CONCRETE SHALL BE C35 (35Mpa) FOR FOUNDATION, C30 (30Mpa) FOR GRADE SLAB & C15 (15Mpa) FOR BLINDING CONCRETE.
4. GRADE OF REINFORCEMENT SHALL BE DEFORMED BAR 420 MPa (GRADE 60) - ASTM A615/A615M.
5. CLEAR COVER TO REINFORCEMENT SHALL BE FOUNDATIONS = 50 MM., COLUMNS = 50 MM., BEAM = 25 MM.
6. FOR STANDARD REINFORCEMENT DETAIL & GENERAL NOTES FOR CIVIL WORKS REFER DRAWING NO. MD-216-1000-EG-CV-DED-1005 & 1001.
7. FOR EMBEDDED CONDUIT DETAILS REFER ELECTRICAL DRAWING NO. MD-216-49WF-EG-EL-LAD-1011 & 1012.

DOCUMENT NUMBER	REFERENCE DOCUMENTS	REV	DATE	REVISION DESCRIPTION	DRN	CHK	ENG	APP	EMP
		D01	17/02/2023	AS-BUILT	AMJ	SJM	BJB	AG	
		C03	25/08/2021	ISSUED FOR CONSTRUCTION & REVISED AS MKD. C03	PML	SJM	BJB	AG	
		C02	20/04/2021	ISSUED FOR CONSTRUCTION & REVISED AS MKD. C02	DSR	SJM	BJB	AG	
MD-216-49WF-EG-ST-GAD-1001	DETAIL OF TRANSFORMER SHED	C01	18/01/2021	ISSUED FOR CONSTRUCTION	SR	SJM	BJB	AG	
MD-216-1000-EG-ST-CRT-1001	CIVIL, STRUCTURAL & ARCHITECTURAL - DESIGN CRITERIA	A01	18/12/2020	ISSUED FOR REVIEW	SR	SJM	BJB	AG	

RESERVED FOR VENDOR LOGO AND DRAWING NUMBER

LARSEN & TOUBRO

This drawing is the property of LARSEN & TOUBRO and must not be passed on to any person or body not authorized by us to receive it nor be copied or otherwise made use either in full or in part by such person or body without our prior permission in writing.

Outotec

The content of these documents are the sole property of Outotec Oyj. Any rights not expressly granted herein are reserved. Reproduction, transfer or distribution of part or all of the contents in any form without prior written permission of Outotec is prohibited.

MA'ADEN معادن
Saudi Arabian Mining Company شركة التعدين العربية السعودية

This document and the information contained herein is Ma'aden proprietary know-how. This document or any part thereof should not be reproduced, stored in a retrieval system or transmitted by any means, electronic or otherwise, or divulged without prior written permission of Ma'aden.

DRAWN	SR	08/12/2020
CHECKED	SJM	13/12/2020
ENGINEER	BJB	10/12/2020
APPROVED	AG	18/12/2020
EMPLOYER		
SCALE	1:20, 1:30, 1:50, 1:75	A1

LARSEN & TOUBRO DRAWING NUMBER: 019045_080_C_G_24988_001 — REVISION: 4
OUTOTEC DRAWING NUMBER: 900707 _GAU01 _AG32_MTL01 _53088 — DOCUMENT ID: OU100706719 — REVISION: 4

MANSOURAH - MASSARAH GOLD PROJECT
GENERAL ARRANGEMENT DRAWING
POTABLE WATER TREATMENT PLANT
DETAIL OF TRANSFORMER & DG FOUNDATION

DRAWING NUMBER: MD-216-49WF-EG-CV-GAD-1009 — REV: D01