


DRAWING NUMBER: MD-216-49WF-EG-CV-GAD-1010 | REV: D01

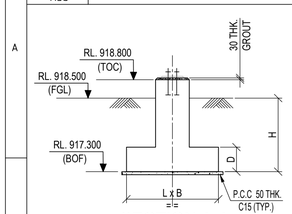


SECTION A-A
(SCALE - 1:50)

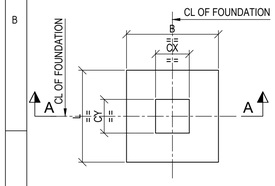


DETAIL OF FOUNDATION
MKD F6, F3 & F7

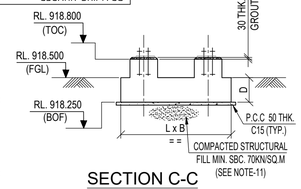


SECTION C-C
(FOR FDN. MKD. F2)
(SCALE - 1:50)

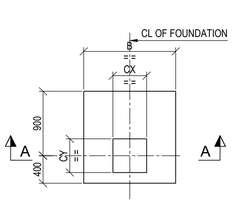


DETAIL OF FOUNDATION MKD F5
(SCALE - 1:50)

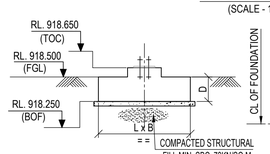


SECTION B-B
(FOR FDN. MKD. F1)
(SCALE - 1:50)

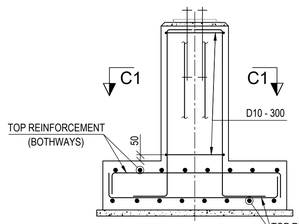


SECTION D-D
(SCALE - 1:25)

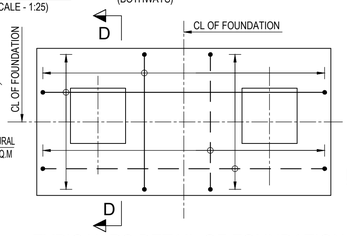


TYPICAL RC DETAIL OF FOUNDATION
(SCALE - 1:25)

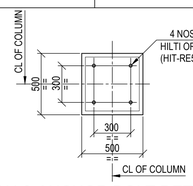


PLAN & ANCHOR BOLT DETAIL
(FOR COLUMN MKD C1)
(SCALE 1:25)

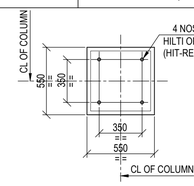


PLAN & ANCHOR BOLT DETAIL
(FOR COLUMN MKD C2)
(SCALE 1:25)

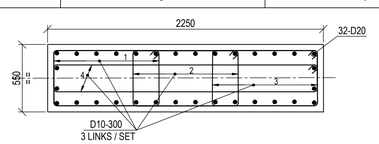


RC DETAIL OF COLUMN MKD C4
(SCALE = 1:25)

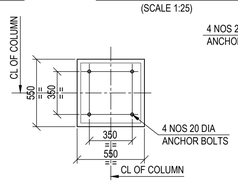

PLAN & ANCHOR BOLT DETAIL
(FOR COLUMN MKD C5)
(SCALE 1:25)

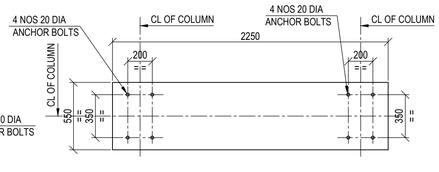


PLAN & ANCHOR BOLT DETAIL
(FOR COLUMN MKD C4)
(SCALE 1:25)

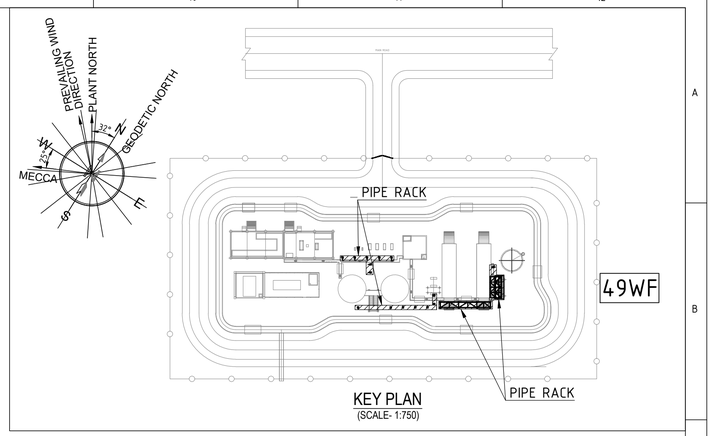


KEY PLAN
(SCALE- 1:750)

SCHEDULE OF FOOTING & COLUMN


TYPE	SIZE (LxB)	DEPTH (D)	HEIGHT (H)	COL MKD	DIMENSION CX	DIMENSION CY	BOTTOM REINFORCEMENT	TOP REINFORCEMENT	BOTTOM OF FOUNDATION
F1	10190X1200	250	–	C1	500	500	T12@175 BOTHWAYS	T12@175 BOTHWAYS	RL 918.250
F2	13500X2000	250	–	C3	400	400	T12@175 BOTHWAYS	T12@175 BOTHWAYS	RL 918.250
F6	1200X1200	350	1200	C5	550	550	T12@150 BOTHWAYS	T12@150 BOTHWAYS	RL 917.300
F3	1300X1300	350	1200	C2	550	550	T12@150 BOTHWAYS	T12@150 BOTHWAYS	RL 917.300
F7	1200X1200	350	1200	C1	500	500	T12@150 BOTHWAYS	T12@150 BOTHWAYS	RL 917.300
F5	1300X1300	350	1200	C2	550	550	T12@150 BOTHWAYS	T12@150 BOTHWAYS	RL 917.300

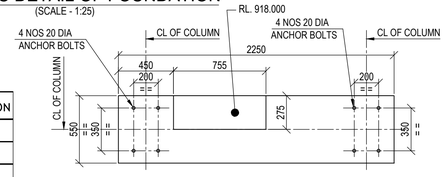


PLAN & ANCHOR BOLT DETAIL
(FOR COLUMN MKD C4A)
(SCALE 1:25)

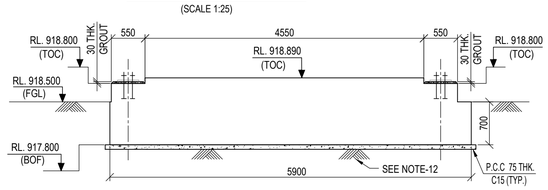


SECTION E-E
(FOR FDN. MKD. F4)
(SCALE - 1:50)

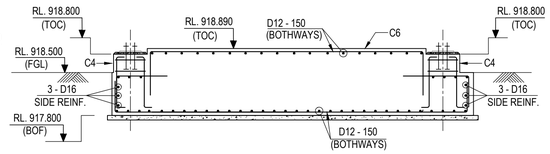


SECTION E-E
(RC DETAILS FOR FDN. MKD. F4)
(SCALE - 1:50)

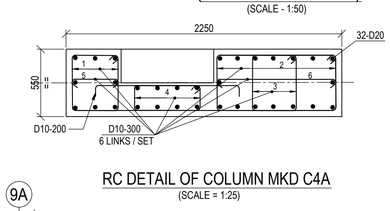


RC DETAIL OF COLUMN MKD C4A
(SCALE = 1:25)

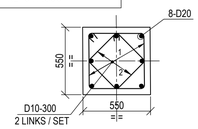


RC DETAIL OF COLUMN MKD C5
(SCALE = 1:25)

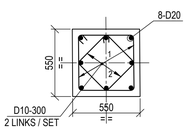


RC DETAIL OF COLUMN MKD C2
(SCALE = 1:25)

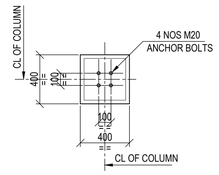

PLAN & ANCHOR BOLT DETAIL
(FOR COLUMN MKD C3)
(SCALE 1:25)

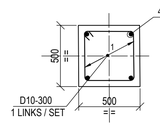

RC DETAIL OF COLUMN MKD C1
(SCALE = 1:25)

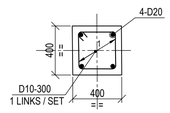

RC DETAIL OF COLUMN MKD C3
(SCALE = 1:25)

LAYOUT OF FOUNDATION
(SCALE - 1:100)

LEGENDS :

TOC - TOP OF CONCRETE
RL- REDUCED LEVEL
TYP - TYPICAL
PCC - PLAIN CEMENT CONCRETE
DIA - DIAMETER
MKD - MARKED
C - COLUMN
MISC. - MISCELLANEOUS
FDN - FOUNDATION
BOF - BOTTOM OF FOUNDATION
CL - CENTRE LINE
RCC - REINFORCED CEMENT CONCRETE
DRG. - DRAWING
THK - THICK
FGL - FINISHED GROUND LEVEL
RC - REINFORCED CONCRETE
MKD - MARKED
BOTTOM REINFORCEMENT(B) - ———
TOP REINFORCEMENT(T) - —— —— ——
SBC - SAFE BEARING CAPACITY
SQ. - SQUIRE

NOTES :-

1. ALL DIMENSIONS ARE IN MILLIMETRES AND LEVELS AND CO-ORDINATES ARE IN METRES UNLESS OTHERWISE STATED.
2. GRADE OF CONCRETE SHALL BE 35MPa FOR RCC AND 15 MPa FOR BLINDING CONCRETE.
3. GRADE OF REINFORCEMENT SHALL BE DEFORMED BAR MPa (GRADE 60) - ASTM M615/fy=420Mpa.
4. NET SAFE BEARING CAPACITY OF SOIL AT BOTTOM OF FOUNDATION IS CONSIDERED AS 375 KN/m .
5. CLEAR COVER TO REINFORCEMENT SHALL BE AS
   a). FOUNDATION = 50mm.
   b). COLUMN = 50mm.
6. FOR MINIMUM LAP LENGTH OF REINFORCEMENT REFER DRG. NO. MD-216-1000-EG-CV-DED-1001.
7. IF ANY PART OF FOUNDATION COMES ON BACKFILL ZONE OF ADJACENT FOUNDATION OR ANY LOOSE SOIL ARE ENCOUNTERED BELOW FOUNDATION LEVEL THE SAME SHALL BE REMOVED AND FILLED WITH PCC.
8. FOR STANDARD DETAILS OF ANCHOR BOLTS REFER DRG. NO. MD-216-1000-EG-CV-DED-1003.
9. FOR STRUCTURAL DETAILS REFER DRG. NO. MD-216-49WF-EG-ST-GAD-2003.
10. THE CONTENT OF THIS DRAWING SHALL CONFORM TO THE PROVISIONS OF CIVIL, STRUCTURAL & ARCHITECTURAL DESIGN CRITERIA DOCUMENT NO. MD-216-1000-EG-ST-CRT-1001.
11. THE STRUCTURAL FILL SHALL CONFIRM TO PROVISIONS OF DOCUMENT NO. MD-216-1000-EG-CV-MST-1698.
12. MINIMUM NET SAFE BEARING CAPACITY TO BE ACHIEVED 10T/SQM.

DOCUMENT NUMBER	REFERENCE DOCUMENTS	REV	DATE	REVISION DESCRIPTION	DRN	CHK	ENG	APP	EMP
		D01	17/02/2023	AS-BUILT	SYA	SJM	BJB	AG	
		C06	08/09/2021	ISSUED FOR CONSTRUCTION & REVISED AS MKD C06	SYA	SJM	BJB	AG	
		C05	25/08/2021	ISSUED FOR CONSTRUCTION & REVISED AS MKD C05	PML	SJM	BJB	AG	
		C04	07/08/2021	ISSUED FOR CONSTRUCTION & REVISED AS MKD C04	SYA	SJM	BJB	AG	
		C03	11/05/2021	ISSUED FOR CONSTRUCTION & REVISED AS MKD C03	DSR	SJM	BJB	AG	
		C02	20/02/2021	ISSUED FOR CONSTRUCTION & REVISED AS MKD C02	DSR	SJM	BJB	AG	
MD-216-49WF-EG-CV-GAD-1013	MISC. PIPE SUPPORTS FOUNDATION DETAIL-2	C01	29/01/2021	ISSUED FOR CONSTRUCTION & REVISED AS MARKED C01	AUD	SJM	BJB	AG	
MD-216-49WF-EG-ST-GAD-2003	MISC. PIPE SUPPORTS PLAN & SECTION DETAIL	A01	05/12/2020	ISSUED FOR REVIEW	DSR	SJM	BJB	AG	

RESERVED FOR VENDOR LOGO AND DRAWING NUMBER

LARSEN & TOUBRO
This drawing is the property of LARSEN & TOUBRO and must not be passed on to any person or body not authorized by us to receive it nor be copied or otherwise made use either in full or in part by such person or body without our prior permission in writing.

Outotec
The content of these documents are the sole property of Outotec Oyj. Any rights not expressly granted herein are reserved. Reproduction, transfer or distribution of part or all of the contents in any form without prior written permission of Outotec is prohibited.

MA'ADEN معادن
Saudi Arabian Mining Company شركة التعدين العربية السعودية
This document and the information contained herein is Ma'aden proprietary know-how. This document or any part thereof should not be reproduced, stored in a retrieval system or transmitted by any means, electronic or otherwise, or divulged without prior written permission of Ma'aden.

LARSEN & TOUBRO DRAWING NUMBER	019045_080_C_G_24989_001	REVISION 7
OUTOTEC DRAWING NUMBER	900707__GAU01__AG32__MTL01__53089	DOCUMENT ID OU100706720 / REVISION 7

DRAWN	DSR	30/11/2020
CHECKED	SJM	04/12/2020
ENGINEER	BJB	03/12/2020
APPROVED	AG	05/12/2020
EMPLOYER		
SCALE	1:100,50,25	A1

MANSOURAH - MASSARAH GOLD PROJECT
GENERAL ARRANGEMENT DRAWING
POTABLE WATER TREATMENT PLANT
MISC. PIPE SUPPORTS FOUNDATION DETAIL

DRAWING NUMBER: MD-216-49WF-EG-CV-GAD-1010 | REV: D01