

DRAWING NUMBER: MD-216-49WF-EG-CV-GAD-1011
REV: D01

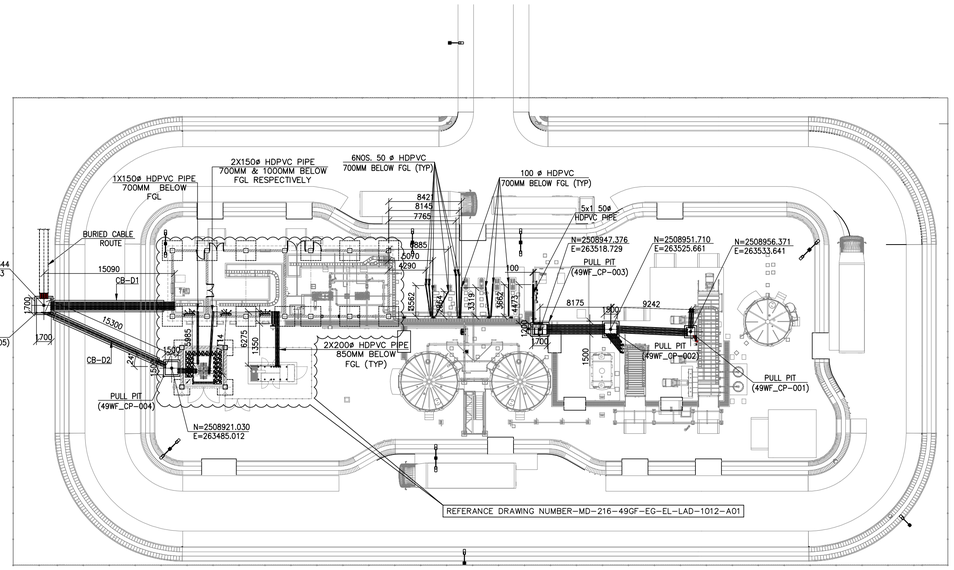


POTABLE WATER TREATMENT PLANT CABLE PULL PIT LAYOUT PLAN

SCALE- 1:250

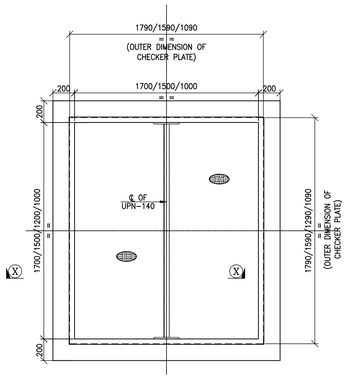


TYPICAL PLAN AT CHQD. PLATE COVER

SCALE 1:20

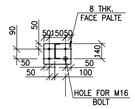


DETAIL-A

SCALE 1:20

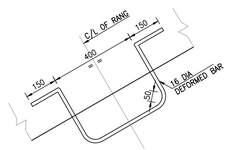


DETAIL OF RUNG

SCALE 1:10

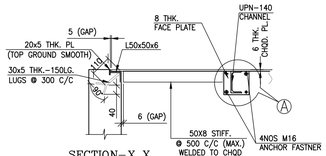


SECTION- X X

SCALE= 1:10

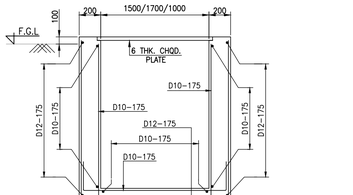


R.C. SECTION E-E

SCALE 1:30

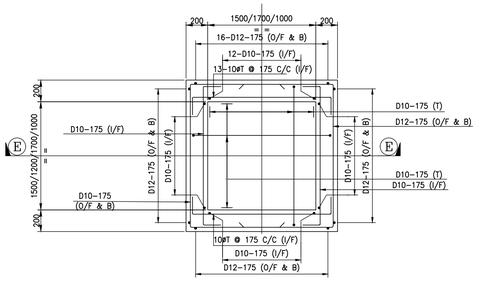


R.C. PLAN OF PULLPIT

SCALE 1:30

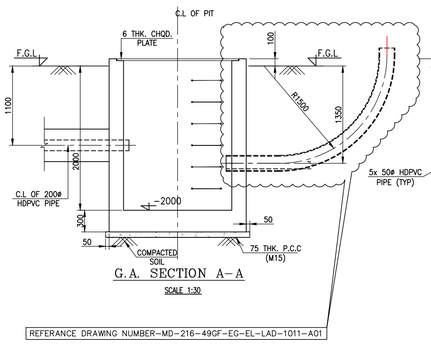


G.A. SECTION A-A

SCALE 1:30

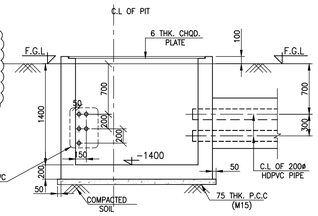


G.A. SECTION B-B

SCALE 1:30

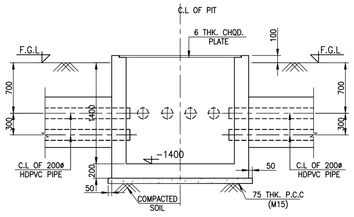


G.A. SECTION C-C

SCALE 1:30

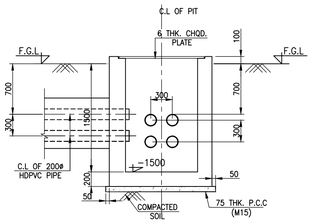


G.A. SECTION D-D

SCALE 1:30

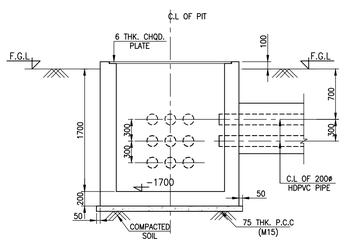


G.A. SECTION E-E

SCALE 1:30

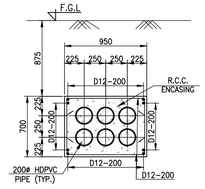


SECTION OF CB-D1

SCALE 1:25

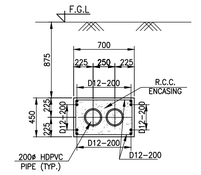


SECTION OF CB-D2

SCALE 1:25

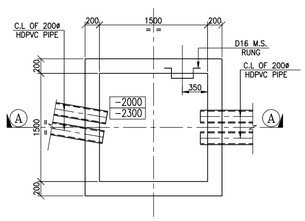


G.A. PLAN FOR PULLPIT MKD. 49WF_CP-004

SCALE 1:30

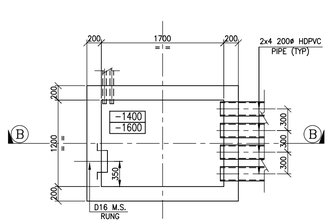


G.A. PLAN FOR PULLPIT MKD. 49WF_CP-003

SCALE 1:30

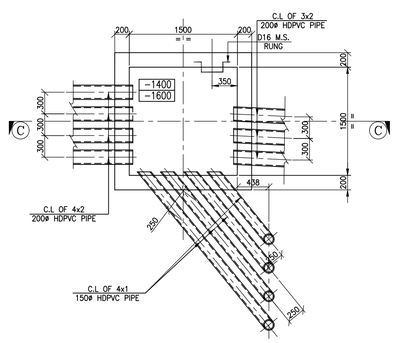


G.A. PLAN FOR PULLPIT MKD. 49WF_CP-002

SCALE 1:30

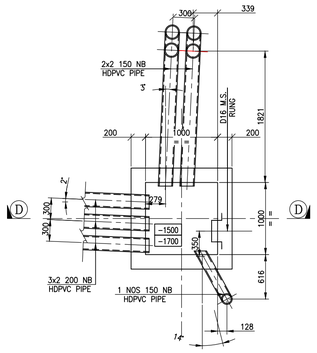

G.A. PLAN FOR PULLPIT MKD. 49WF_CP-001

SCALE 1:30

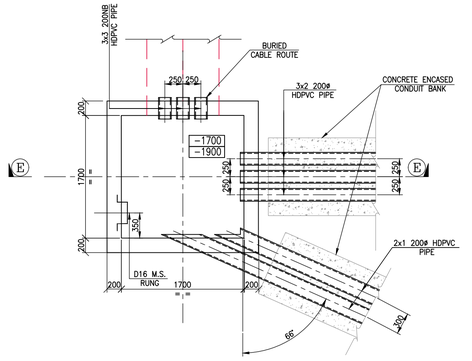

G.A. PLAN FOR PULLPIT MKD. 49WF_CP-005

SCALE 1:30

LEGEND:

TYP.	TYPICAL
U.N.O	UNLESS NOTED OTHERWISE
G.A.	GENERAL ARRANGEMENT
R.C.	REINFORCED CONCRETE
DET.	DETAIL
CB	CONDUIT BANK
F.G.L	FINISHED GROUND LEVEL
P.C.C	PLAIN CEMENT CONCRETE
R.C.C	REINFORCED CEMENT CONCRETE
M.S.	MILD STEEL
HDPVC	HIGH-DENSITY POLYVINYL CHLORIDE
MKD.	MARKED
ø	DIAMETER
R.C.C	REINFORCED CEMENT CONCRETE
I/F	INNER FACE
O/F	OUTER FACE
T	TOP
B	BOTTOM
DIA	DIAMETER
C.L	CENTRE LINE
M.S	MILD STEEL
C/L	CENTRE LINE
CHQD.	CHEQUERED
THK.	THICK
PL.	PLATE
LG.	LONG
STIFF.	STIFFNER
C/C.	CENTRE TO CENTRE
MAX.	MAXIMUM

NOTES:

1. ALL DIMENSIONS ARE IN MILLIMETRES.
2. CO-ORDINATES AND LEVELS ARE IN METRES
3. CO-ORDINATES ARE ON WORLD GRID (FLAT PLANT/WORLD)
4. WORLD MAPPING GRID BASED ON UTM (WGS 84) 038N
5. GRADE OF REINFORCED CEMENT CONCRETE (R.C.C) SHALL BE M35.
6. REINFORCEMENT BARS SHALL CONFORM TO ASTM A615 GRADE 60 (fy=420 N/sq.mm.)
7. CLEAR COVER TO MAIN REINFORCEMENT SHALL BE 25mm(MINIMUM) U.N.O.

DOCUMENT NUMBER	REFERENCE DOCUMENTS	REV	DATE	REVISION DESCRIPTION	DRN	CHK	ENG	APP	EMP
		D01	17/02/23	AS-BUILT	PML	BJB	APEX	SJM	
		C06	25/06/21	ISSUED FOR CONSTRUCTION AND REVISED AS MKD.	PML	BJB	APEX	SJM	
		C05	01/06/21	ISSUED FOR CONSTRUCTION AND REVISED AS MKD.	SYA	BJB	APEX	SJM	
		C04	28/04/21	ISSUED FOR CONSTRUCTION AND REVISED AS MKD.	DSR	BJB	APEX	SJM	
		C03	11/03/21	ISSUED FOR CONSTRUCTION AND REVISED AS MKD.	PML	BJB	APEX	SJM	
MD-216-49GF-EG-EL-LAD-1012		C02	13/02/21	ISSUED FOR CONSTRUCTION AND REVISED AS MKD.	APEX	BJB	APEX	SJM	
MD-216-49GF-EG-EL-LAD-1011		C01	29/01/21	ISSUED FOR CONSTRUCTION	APEX	BJB	APEX	SJM	
MD-216-49WF-EG-CV-DED-2005		A01	27/12/20	ISSUED FOR REVIEW	APEX	BJB	APEX	SJM	

RESERVED FOR VENDOR LOGO AND DRAWING NUMBER

LARSEN & TOUBRO

This drawing is the property of LARSEN & TOUBRO and must not be passed on to any person or body not authorized by us to receive it nor be copied or otherwise made use either in full or in part by such person or body without our prior permission in writing.

Outotec

The content of these documents are the sole property of Outotec Oyj. Any rights not expressly granted herein are reserved. Reproduction, transfer or distribution of part or all of the contents in any form without prior written permission of Outotec is prohibited.

MA'ADEN معادن
Saudi Arabian Mining Company
شركة معادن السعودية للتعدين

This document and the information contained herein is Ma'aden proprietary know-how. This document or any part thereof should not be reproduced, stored in a retrieval system or transmitted by any means, electronic or otherwise, or divulged without prior written permission of Ma'aden.

LARSEN & TOUBRO DRAWING NUMBER: 019045_080_C_G_24999_001 — REVISION: 7
OUTOTEC DRAWING NUMBER: 900707__GAU01__AG32__MTL01__53092 — DOCUMENT ID: OU100709638 — REVISION: 7

DRAWN	APEX	16/12/2020
CHECKED	BJB	24/12/2020
ENGINEER	APEX	16/12/2020
APPROVED	SJM	27/12/2020
EMPLOYER		
SCALE	1:30	A0

MANSOURAH - MASSARAH GOLD PROJECT
GENERAL ARRANGEMENT DRAWING
POTABLE WATER TREATMENT PLANT
CABLE PIT LAYOUT & DETAILS

DRAWING NUMBER: MD-216-49WF-EG-CV-GAD-1011 — REV: D01