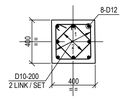
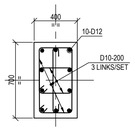
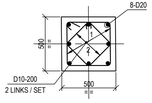
DRAWING NUMBER: MD-216-49WF-EG-CV-GAD-1013 | REV: D01



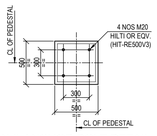

SECTION B1-B1
RC DETAIL OF PEDESTAL MKD P2
(SCALE = 1:20)



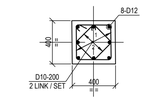

SECTION C1-C1
RC DETAIL OF PEDESTAL MKD P3
(SCALE = 1:20)



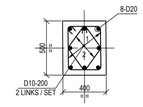

SECTION D1-D1
RC DETAIL OF PEDESTAL MKD P4
(SCALE = 1:20)



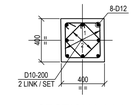

PLAN & ANCHOR BOLT DETAIL
(FOR PEDESTAL MKD P4)
(SCALE 1:25)



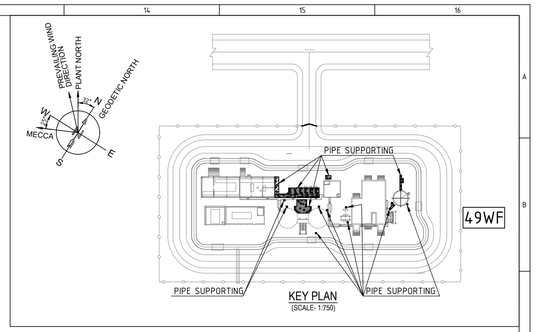

SECTION E1-E1
RC DETAIL OF PEDESTAL MKD P2
(SCALE = 1:20)



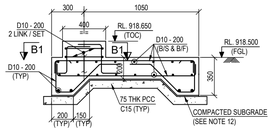

SECTION H1-H1
RC DETAIL OF PEDESTAL MKD P5
(SCALE = 1:20)



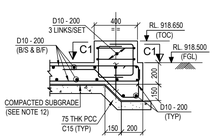

SECTION L1-L1
RC DETAIL OF PEDESTAL MKD P2
(SCALE = 1:20)



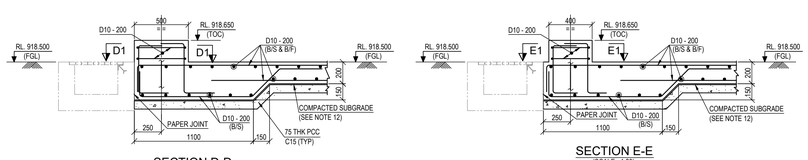

KEY PLAN
(SCALE- 1:750)




SECTION B-B
(SCALE - 1:20)



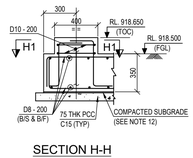

SECTION C-C
(SCALE - 1:20)



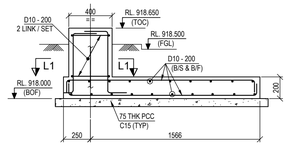

SECTION D-D
(SCALE - 1:20)



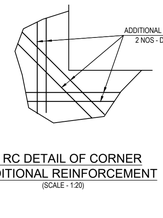

SECTION E-E
(SCALE - 1:20)



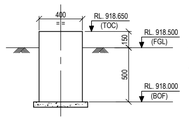

SECTION H-H



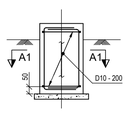

SECTION L-L
(SCALE - 1:20)



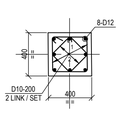

TYP RC DETAIL OF CORNER
ADDITIONAL REINFORCEMENT
(SCALE - 1:20)



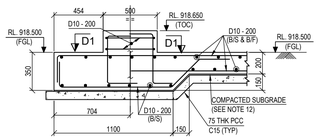

TYP DETAIL OF BLOCK
FOUNDATION MKD P1
(SCALE - 1:20)



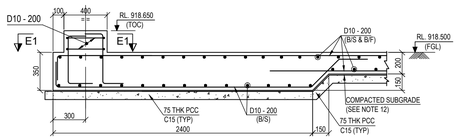

RC DETAIL OF BLOCK
FOUNDATION MKD P1
(SCALE - 1:20)



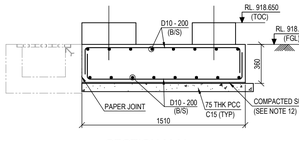

SECTION A1-A1
RC DETAIL OF P1
(SCALE = 1:20)



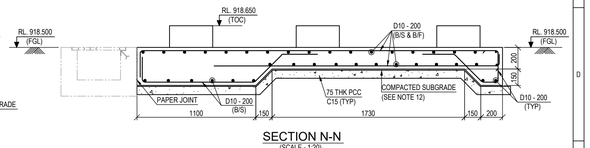

SECTION F-F
(SCALE - 1:20)



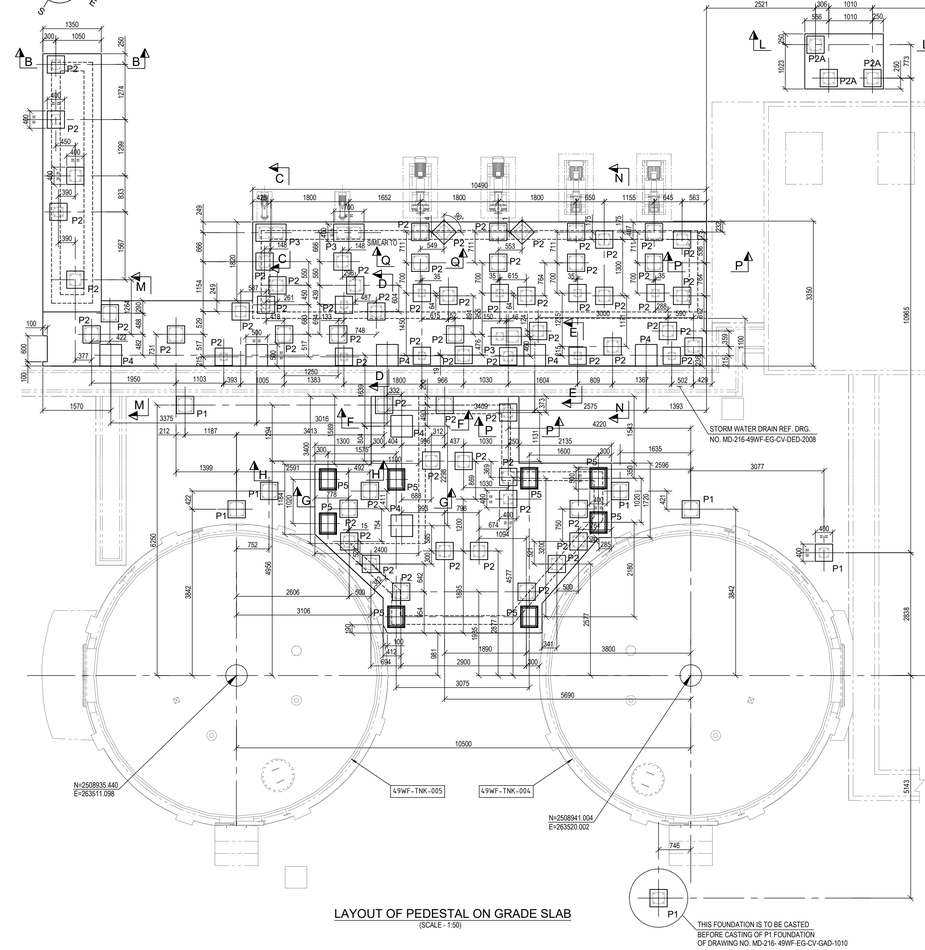

SECTION G-G
(SCALE - 1:25)



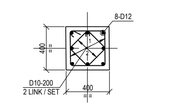

SECTION M-M
(SCALE - 1:20)



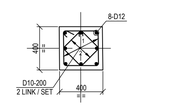

SECTION N-N
(SCALE - 1:20)



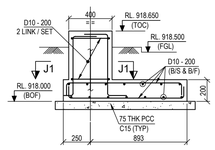

LAYOUT OF PEDESTAL ON GRADE SLAB
(SCALE - 1:50)



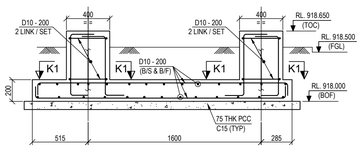

SECTION J1-J1
RC DETAIL OF PEDESTAL MKD P2
(SCALE = 1:20)



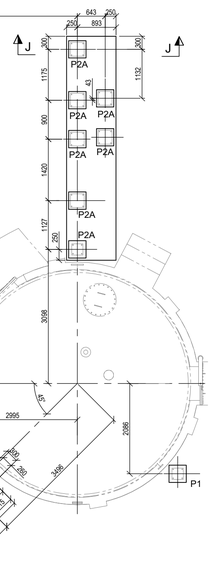

SECTION K1-K1
RC DETAIL OF PEDESTAL MKD P2
(SCALE = 1:20)

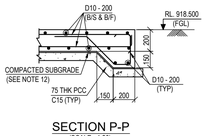



SECTION J-J
(SCALE - 1:20)

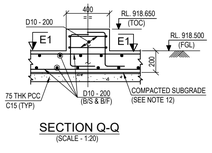



SECTION K-K
(SCALE - 1:20)




SECTION P-P
(SCALE - 1:20)




SECTION Q-Q
(SCALE - 1:20)

LEGENDS :

TOC - TOP OF CONCRETE
RL- REDUCED LEVEL
TYP - TYPICAL
PCC - PLAIN CEMENT CONCRETE
DIA - DIAMETER
MKD - MARKED
C - COLUMN
MISC. - MISCELLANEOUS
FDN - FOUNDATION
BOF - BOTTOM OF FOUNDATION
CL - CENTRE LINE
RCC - REINFORCED CEMENT CONCRETE
DRG. - DRAWING
THK - THICK
FGL - FINISHED GROUND LEVEL
RC - REINFORCED CONCRETE
B/S - BOTH SIDE
B/F - BOTH FACE
BOTTOM REINFORCEMENT(B) -
TOP REINFORCEMENT(T) -

4 NOS. CHEMICAL ANCHOR(HILTI HIT-HY-200-A/R OR EQV.)
ARE PROVIDED ON EACH PEDESTAL (EXCEPT MKD. P4) & ALL HILTI ANCHORS
IN VENDOR SCOPE.

NOTES :-

1. ALL DIMENSIONS ARE IN MILLIMETRES AND LEVELS AND CO-ORDINATES ARE IN METRES UNLESS OTHERWISE STATED.
2. GRADE OF CONCRETE SHALL BE 35MPa FOR RCC AND 15 MPa FOR BLINDING CONCRETE.
3. GRADE OF REINFORCEMENT SHALL BE DEFORMED BAR MPa (GRADE 60) - ASTM M615/fy=420Mpa.
4. NET SAFE BEARING CAPACITY OF SOIL AT BOTTOM OF FOUNDATION IS CONSIDERED AS 200 KN/m^2 AT 500mm BELOW FGL.
5. CLEAR COVER TO REINFORCEMENT SHALL BE AS
   a). FOUNDATION = 50mm.
   b) PEDESTAL = 50mm.
6. FOR MINIMUM LAP LENGTH OF REINFORCEMENT REFER DRG. NO. MD-216-1000-EG-CV-DED-1001.
7. IF ANY PART OF FOUNDATION COMES ON BACKFILL ZONE OF ADJACENT FOUNDATION OR ANY LOOSE SOIL ARE ENCOUNTERED BELOW FOUNDATION LEVEL THE SAME SHALL BE REMOVED AND FILLED WITH PCC.
8. FOR STANDARD DETAILS OF ANCHOR BOLTS REFER DRG. NO. MD-216-1000-EG-CV-DED-1003.
9. FOR STRUCTURAL DETAILS REFER DRG. NO. MD-216-49WF-EG-ST-GAD-2003.
10. THE CONTENT OF THIS DRAWING SHALL CONFORM TO THE PROVISIONS OF CIVIL, STRUCTURAL & ARCHITECTURAL DESIGN CRITERIA DOCUMENT NO. MD-216-1000-EG-ST-CRT-1001.
11. FOR DETAILS OF SLAB EDGE THICHENING AND RE-ENTRANT REBARS REFER DRG. NO. MD-101-SMEM-EG-ST-DST-002 & MD-101-SMEM-EG-ST-DST-007. FOR DETAILS OF SLAB JOINTS REFER DRG. NO. MD-216-1000-EG-CV-DED-1002.
12. THE MINIMUM SAFE BEARING CAPACITY AT FOUNDATION BOTTOM TO BE ACHIVED IS 7 T/m^2 AT 200mm BELOW FGL.

| DOCUMENT NUMBER | REFERENCE DOCUMENTS |
|---|---|
| MD-216-49WF-EG-CV-GAD-1010 | MISC. PIPE SUPPORTS FOUNDATION DETAIL |
| MD-216-49WF-EG-ST-GAD-2003 | MISC. PIPE SUPPORTS PLAN & SECTIONAL DETAIL |

| REV | DATE | REVISION DESCRIPTION | DRN | CHK | ENG | APP | EMP |
|---|---|---|---|---|---|---|---|
| D01 | 17/02/2023 | AS-BUILT | SYA | SJM | BJB | AG | |
| C03 | 08/09/2021 | ISSUED FOR CONSTRUCTION & REVISED AS MKD (03) | SYA | SJM | BJB | AG | |
| C02 | 11/08/2021 | ISSUED FOR CONSTRUCTION & REVISED AS MKD (02) | SYA | SJM | BJB | AG | |
| C01 | 12/05/2021 | ISSUED FOR CONSTRUCTION & REVISED AS MKD (01) | DSR | SJM | BJB | AG | |
| A02 | 09/04/2021 | ISSUED FOR REVIEW AND REVISED AS PER EMPLOYER'S COMMENTS ON 31.03.2021 & REVISED AS MKD (02) | DSR | SJM | BJB | AG | |
| A01 | 27/02/2021 | ISSUED FOR REVIEW | DSR | SJM | BJB | AG | |

| DOCUMENT NUMBER | REFERENCE DOCUMENTS |
|---|---|

RESERVED FOR VENDOR LOGO AND DRAWING NUMBER

LARSEN & TOUBRO

This drawing is the property of LARSEN & TOUBRO and must not be passed on to any person or body not authorized by us to receive it nor be copied or otherwise made use either in full or in part by such person or body without our prior permission in writing.

Outotec

The content of these documents are the sole property of Outotec Oyj. Any rights not expressly granted herein are reserved. Reproduction, transfer or distribution of part or all of the contents in any form without prior written permission of Outotec is prohibited.

MA'ADEN معادن Saudi Arabian Mining Company

This document and the information contained herein is Ma'aden proprietary know-how. This document or any part thereof should not be reproduced, stored in a retrieval system or transmitted by any means, electronic or otherwise, or divulged without prior written permission of Ma'aden.

| | | |
|---|---|---|
| LARSEN & TOUBRO DRAWING NUMBER | 019045_080_C_G_24991_001 | REVISION 5 |
| OUTOTEC DRAWING NUMBER | 900707__GAU01__AG32_MTL01__53095 | DOCUMENT ID 0U100712209 / REVISION 5 |

| | | |
|---|---|---|
| DRAWN | DSR | 22/02/2021 |
| CHECKED | SJM | 25/02/2021 |
| ENGINEER | BJB | 22/02/2021 |
| APPROVED | AG | 27/02/2021 |
| EMPLOYER | | |
| SCALE | 1:50, 20 | A0 |

MANSOURAH - MASSARAH GOLD PROJECT
GENERAL ARRANGEMENT DRAWING
POTABLE WATER TREATMENT PLANT
MISC. PIPE SUPPORTS FOUNDATION DETAIL-2

DRAWING NUMBER: MD-216-49WF-EG-CV-GAD-1013 | REV: D01