


DRAWING NUMBER: MD-216-49WF-EG-CV-GAD-1014 | REV: D01

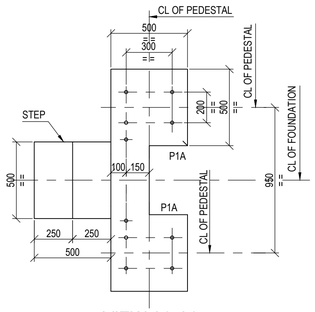


VIEW A3-A3
(FOR PEDESTAL MKD P1A)

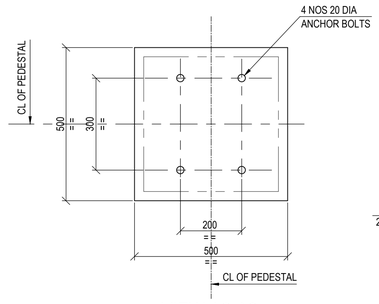


VIEW A2-A2
(FOR PEDESTAL MKD P1)
(SCALE 1:10)

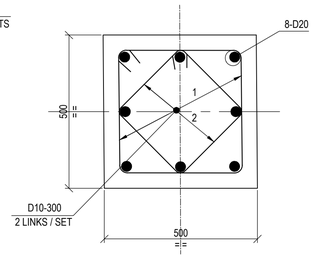


SECTION C1-C1
RC DETAIL OF PEDESTAL MKD P1
(SCALE = 1:10)

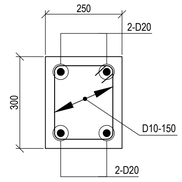



RC DETAIL OF TIE BEAM MKD TB1
(SCALE = 1:10)

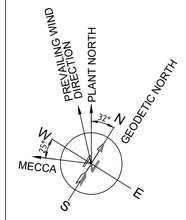

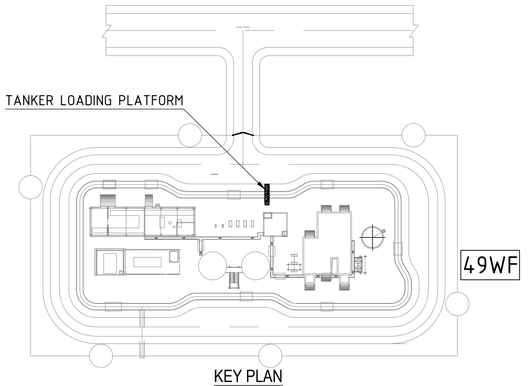


KEY PLAN
(SCALE- 1:750)

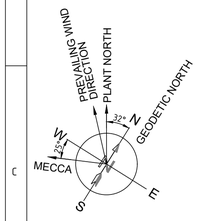


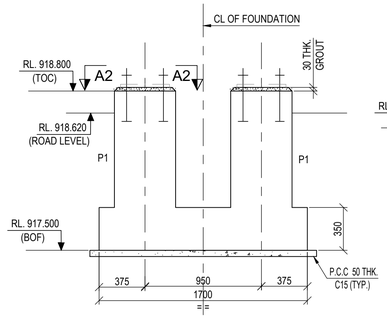


SECTION A-A
(SCALE - 1:25)

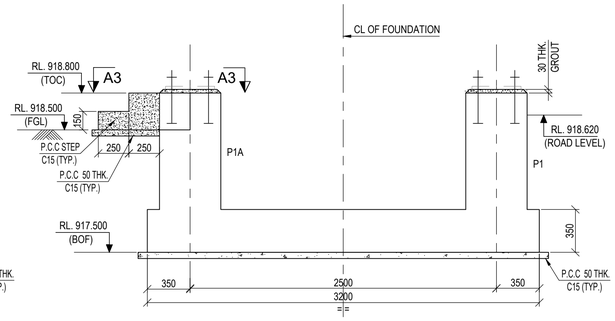


SECTION B-B
(SCALE - 1:25)

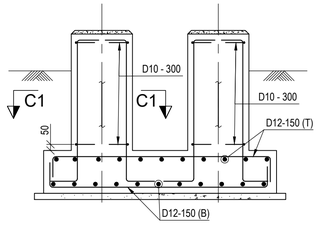


SECTION C-C
(SCALE - 1:25)

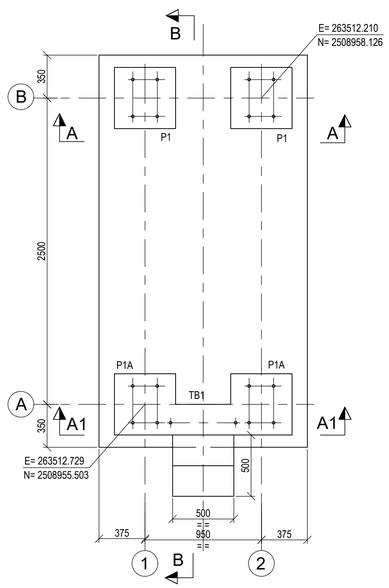

DETAIL OF FOUNDATION MKD F1
(SCALE - 1:25)

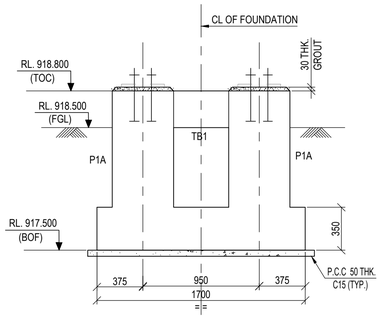

SECTION A1-A1
(SCALE - 1:25)

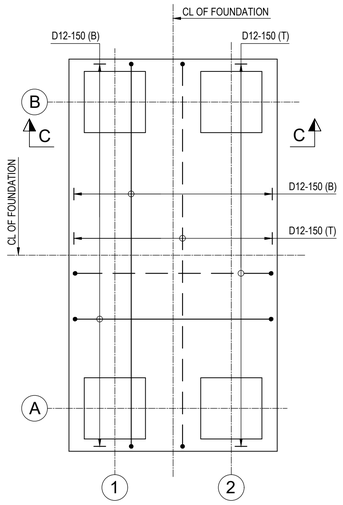

RC DETAIL OF FOUNDATION
(SCALE - 1:25)

LEGENDS :

TOC - TOP OF CONCRETE
RL- REDUCED LEVEL
TYP - TYPICAL
PCC - PLAIN CEMENT CONCRETE
DIA - DIAMETER
MKD - MARKED
P - PEDESTAL
BOF - BOTTOM OF FOUNDATION
CL - CENTRE LINE
DRG. - DRAWING
THK - THICK
FGL - FINISHED GROUND LEVEL
RC - REINFORCED CONCRETE
MKD - MARKED
BOTTOM REINFORCEMENT(B) - ————————
TOP REINFORCEMENT(T) - — — — — —
RC - REINFORCED CONCRETE

NOTES :-

1. ALL DIMENSIONS ARE IN MILLIMETRES AND LEVELS AND CO-ORDINATES ARE IN METRES UNLESS OTHERWISE STATED.
2. GRADE OF CONCRETE SHALL BE 35MPa FOR RCC AND 15 MPa FOR BLINDING CONCRETE.
3. GRADE OF REINFORCEMENT SHALL BE DEFORMED BAR MPa (GRADE 60) - ASTM M615/fy=420Mpa.
4. NET SAFE BEARING CAPACITY OF SOIL AT BOTTOM OF FOUNDATION IS CONSIDERED AS 375 KN/m^2.
5. CLEAR COVER TO REINFORCEMENT SHALL BE AS
   a). FOUNDATION = 50mm.
   b). COLUMN = 50mm.
6. FOR MINIMUM LAP LENGTH OF REINFORCEMENT REFER DRG. NO. MD-216-1000-EG-CV-DED-1001.
7. IF ANY PART OF FOUNDATION COMES ON BACKFILL ZONE OF ADJACENT FOUNDATION OR ANY LOOSE SOIL ARE ENCOUNTERED BELOW FOUNDATION LEVEL THE SAME SHALL BE REMOVED AND FILLED WITH PCC.
8. FOR STANDARD DETAILS OF ANCHOR BOLTS REFER DRG. NO. MD-216-1000-EG-CV-DED-1003.
9. FOR STRUCTURAL DETAILS REFER DRG. NO. MD-216-49WF-EG-ST-GAD-2003.
10. THE CONTENT OF THIS DRAWING SHALL CONFORM TO THE PROVISIONS OF CIVIL, STRUCTURAL & ARCHITECTURAL DESIGN CRITERIA DOCUMENT NO. MD-216-1000-EG-ST-CRT-1001.

DOCUMENT NUMBER	REFERENCE DOCUMENTS	REV	DATE	REVISION DESCRIPTION	DRN	CHK	ENG	APP	EMP
		D01	17/02/2023	AS-BUILT	DSR	SJM	BJB	AG	
		C01	12/04/2021	ISSUED FOR CONSTRUCTION	DSR	SJM	BJB	AG	
MD-216-49WF-EG-ST-GAD-2005	TANKER LOADING PLATFORM GA & DETAIL	A01	27/02/2021	ISSUED FOR REVIEW	DSR	SJM	BJB	AG	

RESERVED FOR VENDOR LOGO AND DRAWING NUMBER

LARSEN & TOUBRO
This drawing is the property of LARSEN & TOUBRO and must not be passed on to any person or body not authorized by us to receive it nor be copied or otherwise made use either in full or in part by such person or body without our prior permission in writing.

Outotec
The content of these documents are the sole property of Outotec Oyj. Any rights not expressly granted herein are reserved. Reproduction, transfer or distribution of part or all of the contents in any form without prior written permission of Outotec is prohibited.

MA'ADEN معادن
Saudi Arabian Mining Company شركة التعدين العربية السعودية
This document and the information contained herein is Ma'aden proprietary know-how. This document or any part thereof should not be reproduced, stored in a retrieval system or transmitted by any means, electronic or otherwise, or divulged without prior written permission of Ma'aden.

LARSEN & TOUBRO DRAWING NUMBER: 019045_080_C_G_24992_001 | REVISION: 2
OUTOTEC DRAWING NUMBER: 900707__GAU01__AG32__MTL01__53097 | DOCUMENT ID: OU100717231 | REVISION: 2

DRAWN	DSR	23/02/2021
CHECKED	SJM	25/02/2021
ENGINEER	BJB	22/02/2021
APPROVED	AG	27/02/2021
EMPLOYER		
SCALE	1:100,50,25	A1

MANSOURAH - MASSARAH GOLD PROJECT
GENERAL ARRANGEMENT DRAWING
POTABLE WATER TREATMENT PLANT
TANKER LOADING PLATFORM FOUNDATION DETAIL

DRAWING NUMBER: MD-216-49WF-EG-CV-GAD-1014 | REV: D01