

DRAWING NUMBER
MD - 216 - 49WF- EG - CV - GAD - 1015
REV
D01

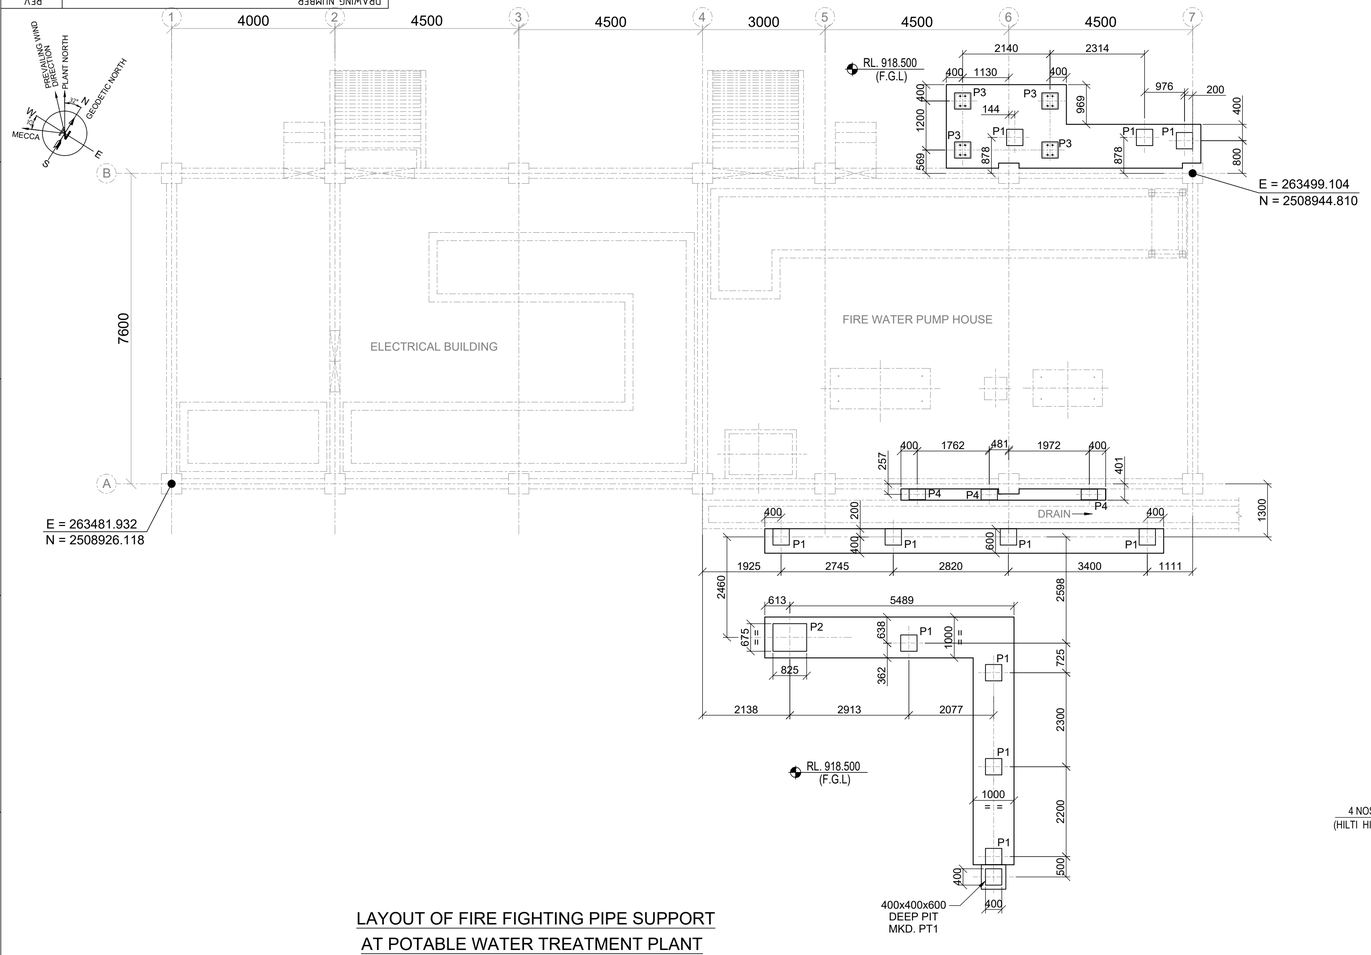


LAYOUT OF FIRE FIGHTING PIPE SUPPORT AT POTABLE WATER TREATMENT PLANT

(SCALE - 1:75)

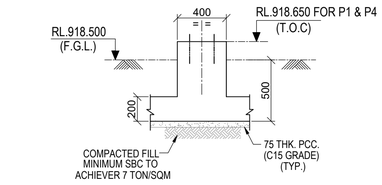


SECTION A - A

(SCALE 1:25)

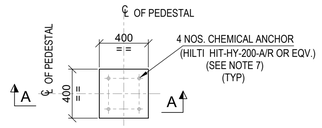


TYP. DETAIL OF PEDESTAL MKD. P1

(SCALE 1:25)

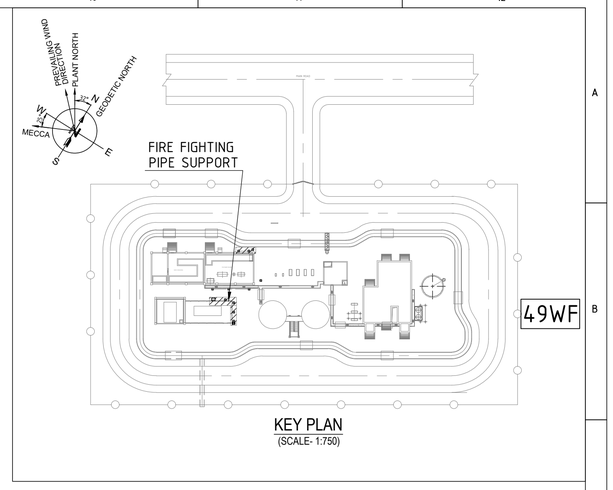


KEY PLAN

(SCALE- 1:750)

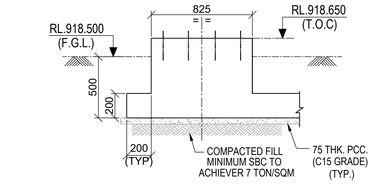


SECTION B - B

(SCALE 1:25)

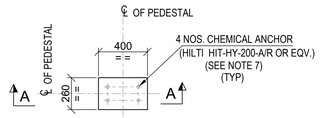


TYP. DETAIL OF PEDESTAL MKD. P4

(SCALE 1:25)

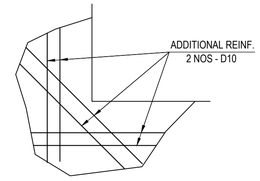


TYP RC DETAIL OF CORNER ADDITIONAL REINFORCEMENT

(SCALE - 1:20)

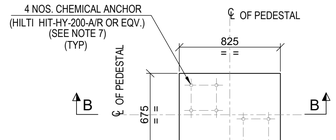


TYP. DETAIL OF PEDESTAL MKD. P2

(SCALE 1:25)

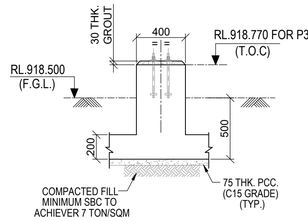


SECTION A1 - A1

(SCALE 1:25)

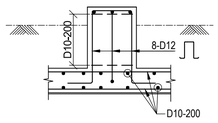


SECTION 1 - 1

(SCALE 1:25)

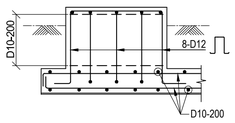


SECTION 2 - 2

(SCALE 1:25)

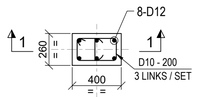


RC DETAIL OF PEDESTAL MKD. P4

(SCALE 1:25)

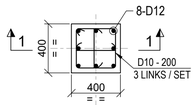


RC DETAIL OF PEDESTAL MKD. P1 & P3

(SCALE 1:25)

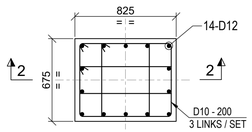


RC DETAIL OF PEDESTAL MKD. P2

(SCALE 1:25)

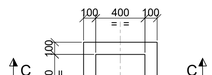


TYP. DETAIL OF PIT MKD. PT1

(SCALE 1:25)

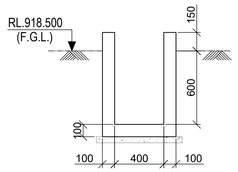

SECTION C - C


(SCALE 1:25)

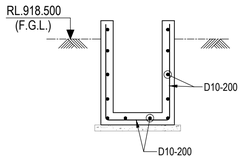

SECTION C - C

(SHOWING RC DETAIL)

(SCALE 1:25)

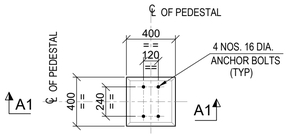

TYP. DETAIL OF PEDESTAL MKD. P3

(SCALE 1:25)

LEGEND :-

R.L. - REDUCED LEVEL
℄ - CENTRE LINE
T.O.C. - TOP OF CONCRETE
TYP. - TYPICAL
F.G.L. - FINISHED GROUND LEVEL
F.F.L. - FINISHED FLOOR LEVEL
B.O.F. - BOTTOM OF FOUNDATION
MKD. - MARKED
P.C.C - PLAIN CEMENT CONCRETE
DET. - DETAIL
R.C. - REINFORCED CONCRETE
FDN. - FOUNDATION
THK. - THICK
GA-GENERAL ARRANGEMENT
REF.- REFER
DWG.-DRAWING
DIA. - DIAMETER
R.C.C. - REINFORCED CEMENT CONCRETE

NOTES:-

1. ALL DIMENSIONS ARE IN MILLIMETRES AND LEVELS AND CO-ORDINATES ARE IN METRES UNLESS OTHERWISE STATED.
2. GRADE OF CONCRETE SHALL BE C35 (35MPa) FOR FOUNDATION & C15 (15MPa) FOR BLINDING CONCRETE.
3. GRADE OF REINFORCEMENT SHALL BE DEFORMED BAR 420 MPa (GRADE 60) - ASTM A615/A615M.
4. IF ANY PART OF FOUNDATION COMES ON BACKFILL ZONE OF ADJACENT FOUNDATION OR ANY LOOSE SOIL ARE ENCOUNTERED BELOW FOUNDATION LEVEL THE SAME SHALL BE REMOVED AND FILLED WITH PCC (C15).
5. CLEAR COVER TO REINFORCEMENT SHALL BE
   a. FOUNDATIONS = 50 MM., b. COLUMNS = 50 MM., c. GRADE SLAB = 25 MM.
6. FOR STANDARD REINFORCEMENT DETAIL & GENERAL NOTES FOR CIVIL WORKS REFER DRAWING NO. MD-216-1000-EG-CV-DED-1005 & 1001.
7. ALL HILTI ANCHORS ARE IN VENDOR SCOPE.

DOCUMENT NUMBER	REFERENCE DOCUMENTS			REVISION DESCRIPTION	DRN	CHK	ENG	APP	EMP
		D01	17/02/2023	AS-BUILT	AMJ	SJM	BJB	AG	
MD-216-49WF-EG-ST-GAD-2007	POTABLE WATER TREATMENT PLANT	C03	08/06/2021	ISSUED FOR CONSTRUCTION & REVISED AS MKD. C03	AMJ	SJM	BJB	AG	
	SHED GA & DETAILS	C02	01/06/2021	ISSUED FOR CONSTRUCTION & REVISED AS MKD. C02	AMJ	SJM	BJB	AG	
MD-216-49WF-EG-CV-GAD-1013	POTABLE WATER TREATMENT PLANT	C01	14/05/2021	REVISED AS PER EMPLOYER COMMENTS	AMJ	SJM	BJB	AG	
	MISC. PIPE SUPPORTS FOUNDATION DETAIL-2			DATED 08/05/2021 & REVISED AS MKD. C01					
MD-216-49WF-EG-CV-DED-2001	POTABLE WATER TREATMENT PLANT	A02	09/04/2021	REVISED AS PER EMPLOYER COMMENTS	AMJ	SJM	AVG	AG	
	FW PUMP HOUSE & ELEC. BUILDING DETAIL			DATED 19/03/2021 & REVISED AS MKD. A02					
MD-216-1000-EG-ST-CRT-1001	CIVIL,STRUCTURAL AND ARCHITECTURAL DESIGN CRITERIA	A01	25/02/2021	ISSUED FOR REVIEW	AMJ	SJM	BJB	AG	

RESERVED FOR VENDOR LOGO AND DRAWING NUMBER

LARSEN & TOUBRO
This drawing is the property of LARSEN & TOUBRO and must not be passed on to any person or body not authorized by us to receive it nor be copied or otherwise made use either in full or in part by such person or body without our prior permission in writing.

Outotec
The content of these documents are the sole property of Outotec Oyj. Any rights not expressly granted herein are reserved. Reproduction, transfer or distribution of part or all of the contents in any form without prior written permission of Outotec is prohibited.

MA'ADEN معادن
Saudi Arabian Mining Company شركة التعدين العربية السعودية
This document and the information contained herein is Ma'aden proprietary know-how. This document or any part thereof should not be reproduced, stored in a retrieval system or transmitted by any means, electronic or otherwise, or divulged without prior written permission of Ma'aden.

LARSEN & TOUBRO DRAWING NUMBER: 019045_080_C_G_24993_001 — REVISION: 5
OUTOTEC DRAWING NUMBER: 900707__GAU01__AG32__MTL01__39239 — DOCUMENT ID: OU100717687 — REVISION: 5

DRAWN	AMJ	20/02/2021	MANSOURAH - MASSARAH GOLD PROJECT
CHECKED	SJM	22/02/2021	GENERAL ARRANGEMENT DRAWING
ENGINEER	BJB	20/02/2021	POTABLE WATER TREATMENT PLANT
APPROVED	AG	25/02/2021	FIRE FIGHTING PIPE SUPPORT FOUNDATION DETAILS
EMPLOYER			
SCALE	1:75, 1:25 & 1:15	A1	DRAWING NUMBER: MD - 216 - 49WF- EG - CV - GAD - 1015 — REV: D01