


DRAWING NUMBER: MD-216-49WF-EG-CV-GAD-1017 | REV: D01

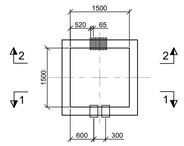


DETAIL OF PIT MKD. PIT-1
SCALE 1 : 50

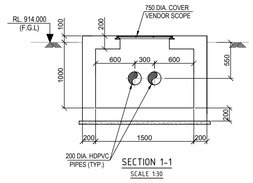


SECTION 1-1
SCALE 1:30

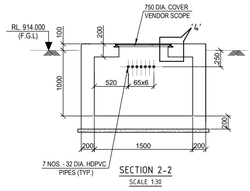

SECTION 2-2
SCALE 1:30

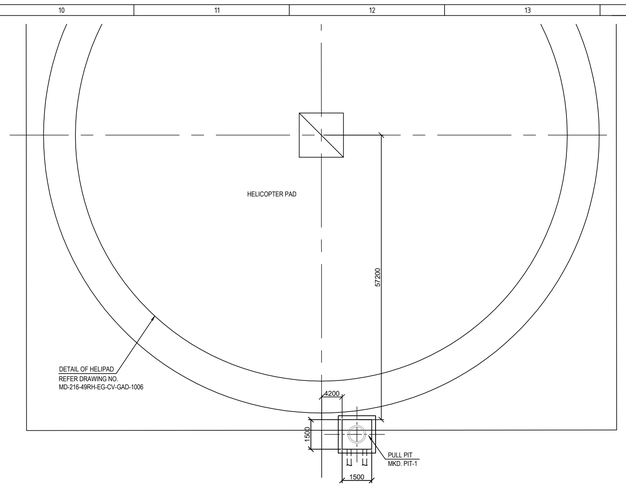


DETAIL -S
SCALE 1 : 100

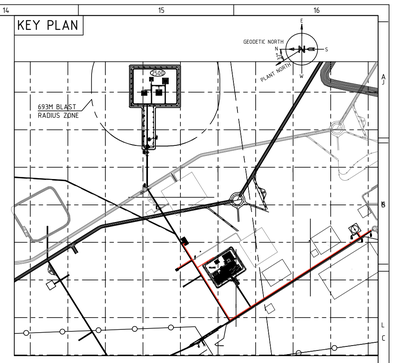

RC DETAIL OF PIT MKD. PIT-1
SCALE 1:30

VIEW 3-3
SCALE 1 : 50

DETAIL - '4'
(SCALE 1:10)

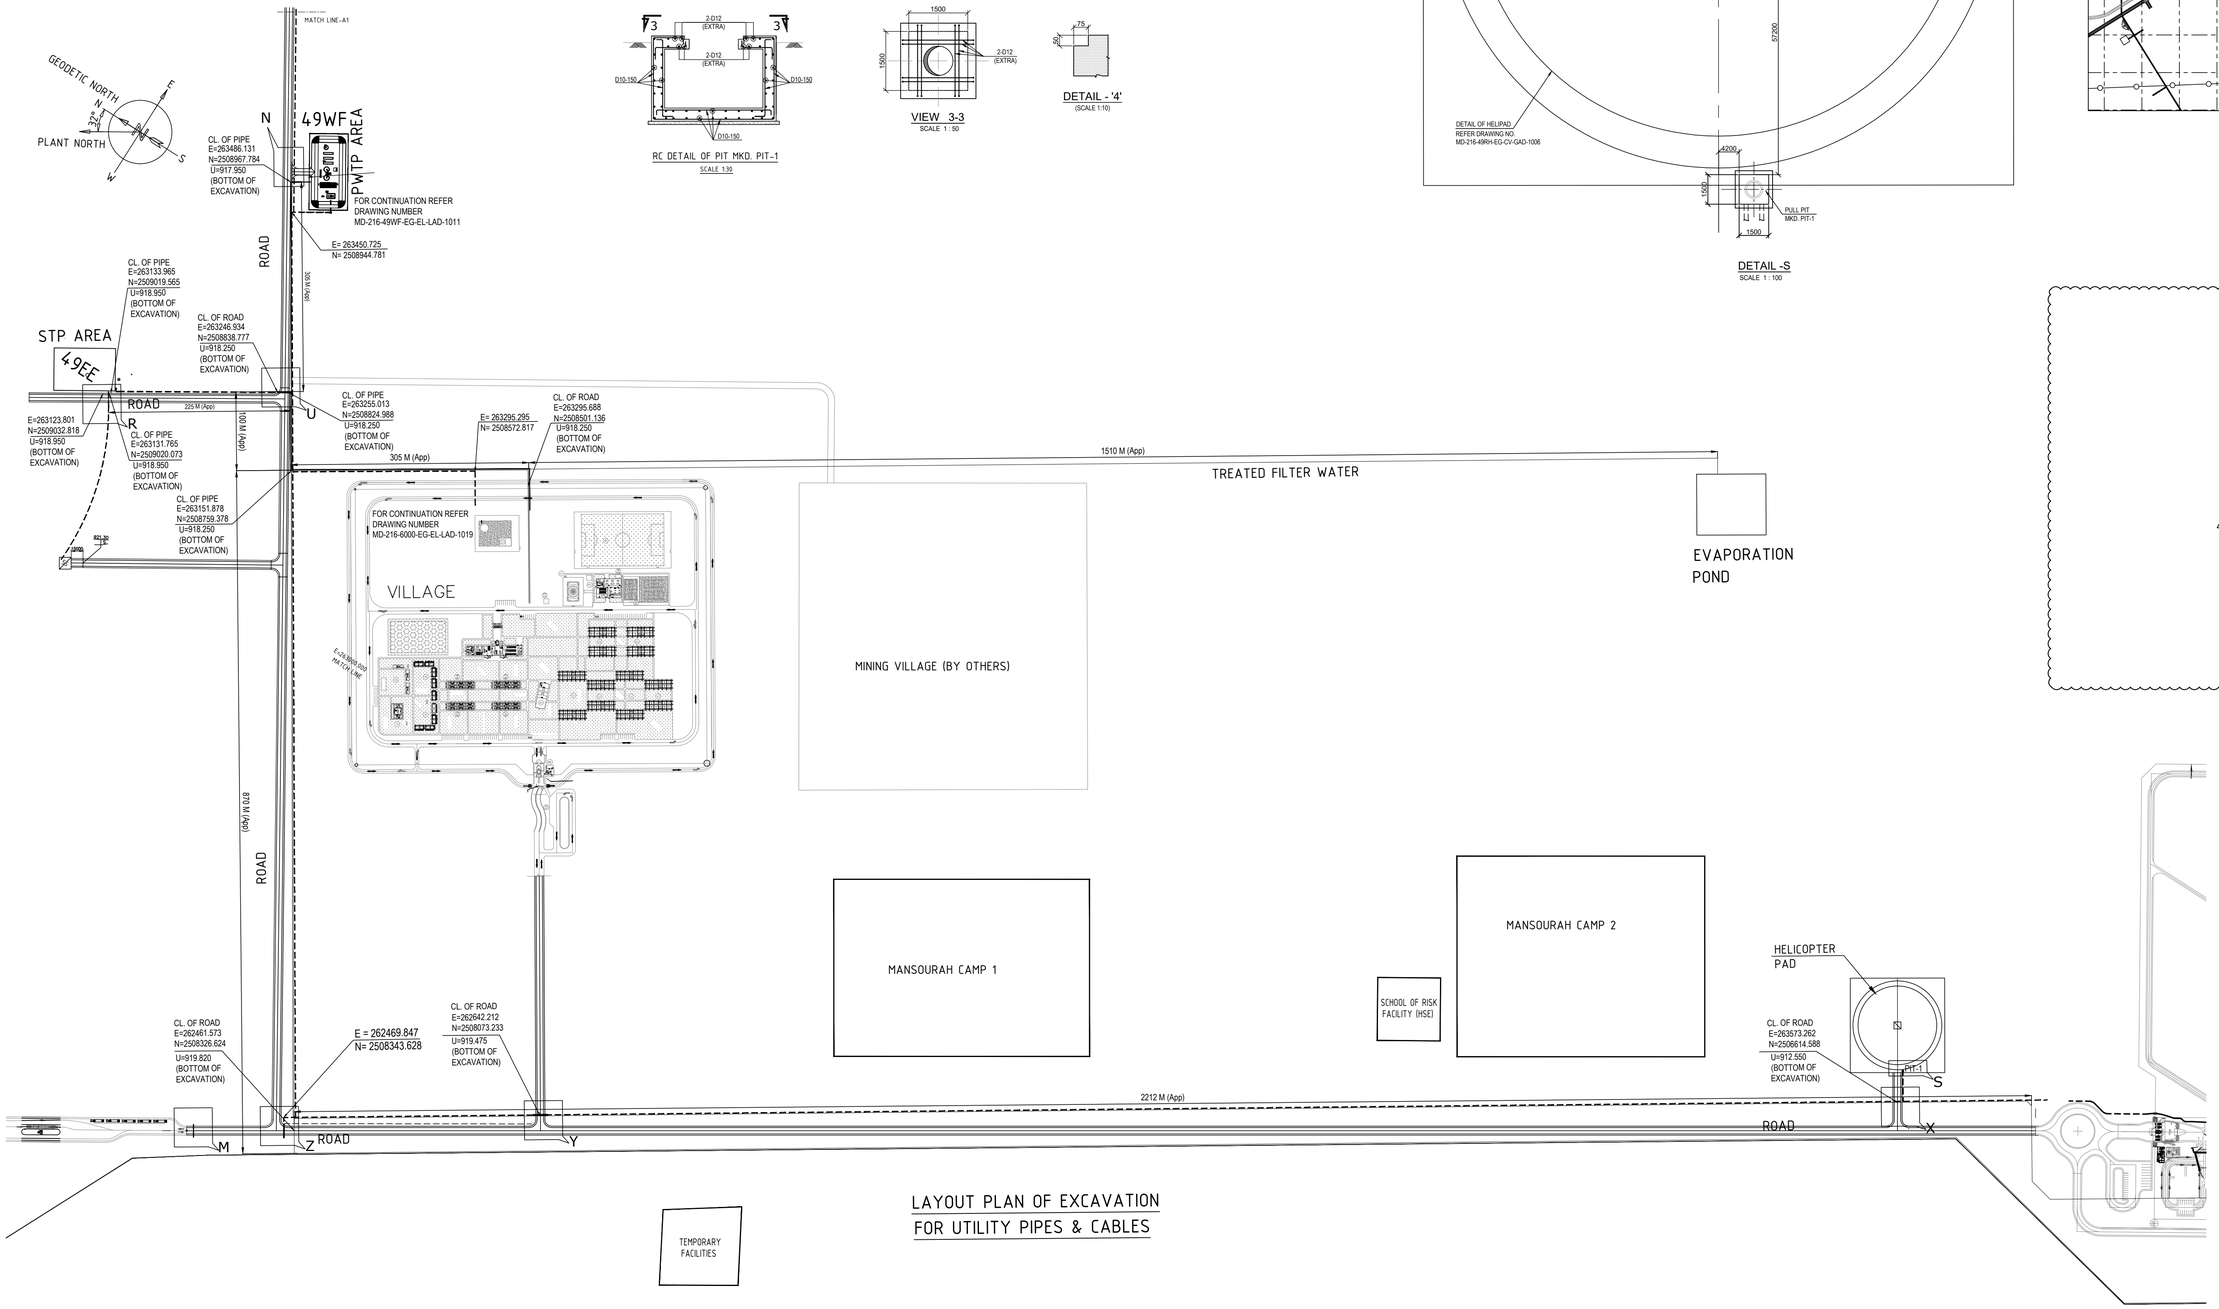

LAYOUT PLAN OF EXCAVATION FOR UTILITY PIPES & CABLES

LEGEND :-

CJ - CONSTRUCTION JOINT
F.G.L - FINISHED GROUND LEVEL
F.F.L - FINISHED FLOOR LEVEL
R.L - REDUCED LEVEL
I.L - INVERT LEVEL
THK. - THICK
T.O.C - TOP OF CONCRETE
DIA - DIAMETER
DRG. - DRAWING
OPP - OPPOSITE
RC - REINFORCED CONCRETE
DET - DETAIL
FDN. - FOUNDATION
MKD - MARKED
TYP. - TYPICAL
C - CENTRE LINE
Ø - DIAMETER
R - RADIUS
U/G - UNDER GROUND

NOTES:-

1. ALL DIMENSIONS ARE IN MILLIMETRES AND LEVELS AND CO-ORDINATES ARE IN METRES UNLESS OTHERWISE STATED.
2. GRADE OF CONCRETE SHALL BE C35 (35Mpa).
3. GRADE OF REINFORCEMENT SHALL BE DEFORMED BAR 420 MPa (GRADE 60) - ASTM A615/A615M.
4. CLEAR COVER TO REINFORCEMENT SHALL BE SLAB = 25 MM.
5. FOR STANDARD REINFORCEMENT DETAIL & GENERAL NOTES FOR CIVIL WORKS REFER DRAWING NO. MD-216-1000-EG-CV-DED-1005 & 1001.
6. THIS DRG SHALL BE READ IN CONJUNCTION WITH DRG NO. MD-216-49WF-EG-CV-GAD-1018.
7. NET SAFE BEARING CAPACITY OF SOIL UNDER CROSS / PIT IS CONSIDERED AS 20 T/ SQM.
8. EARTHWORKS FOR ROAD CROSSINGS SHALL BE CONSTRUCTED PER S.15 OF MD-101-SWEM-EG-CV-SPC-0003.

DOCUMENT NUMBER	REFERENCE DOCUMENTS	REV	DATE	REVISION DESCRIPTION	DRN	CHK	ENG	APP	EMP
		D01	17/02/2023	AS-BUILT	AMJ	SJM	AVG	AG	
		C01	03/07/2021	ISSUED FOR CONSTRUCTION & REVISED AS MKD. C01	AMJ	SJM	AVG	AG	
MD-216-49WF-EG-PL-DED-1013	POTABLE WATER SUPPLY	A02	02/06/2021	REVISED AS PER EMPLOYER COMMENTS	AMJ	SJM	AVG	AG	
	U/G PIPE & CABLE ROUTE (OUTSIDE PROCESS AREA)			DATED 25/05/2021 & REVISED AS MKD. A02					
MD-216-1000-EG-ST-CRT-1001	CIVIL, STRUCTURAL & ARCHITECTURAL - DESIGN CRITERIA	A01	29/04/2021	ISSUED FOR REVIEW	AMJ	SJM	AVG	AG	

RESERVED FOR VENDOR LOGO AND DRAWING NUMBER

LARSEN & TOUBRO

This drawing is the property of LARSEN & TOUBRO and must not be passed on to any person or body not authorized by us to receive it nor be copied or otherwise made use either in full or in part by such person or body without our prior permission in writing.

Outotec

The content of these documents are the sole property of Outotec Oyj. Any rights not expressly granted herein are reserved. Reproduction, transfer or distribution of part or all of the contents in any form without prior written permission of Outotec is prohibited.

MA'ADEN معادن Saudi Arabian Mining Company

This document and the information contained herein is Ma'aden proprietary know-how. This document or any part thereof should not be reproduced, stored in a retrieval system or transmitted by any means, electronic or otherwise, or divulged without prior written permission of Ma'aden.

LARSEN & TOUBRO DRAWING NUMBER	019045_080_C_G_24996_001	REVISION	3
OUTOTEC DRAWING NUMBER	900707__GAU01__AG32_MTL01__53103	DOCUMENT ID	0U100721773
		REVISION	3
DRAWN	AMJ	22/04/2021	MANSOURAH - MASSARAH GOLD PROJECT
CHECKED	SJM	27/04/2021	GENERAL ARRANGEMENT DRAWING
ENGINEER	AVG	22/04/2021	POTABLE WATER TREATMENT PLANT
APPROVED	AG	29/04/2021	LAYOUT OF U/G CROSSING FOR PIPES & CABLES
EMPLOYER			
SCALE	1:4000	A0	DRAWING NUMBER: MD-216-49WF-EG-CV-GAD-1017 REV: D01