

DRAWING NUMBER	REV
MD-216-49WF-EG-CV-GAD-1019	D01

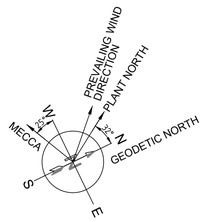

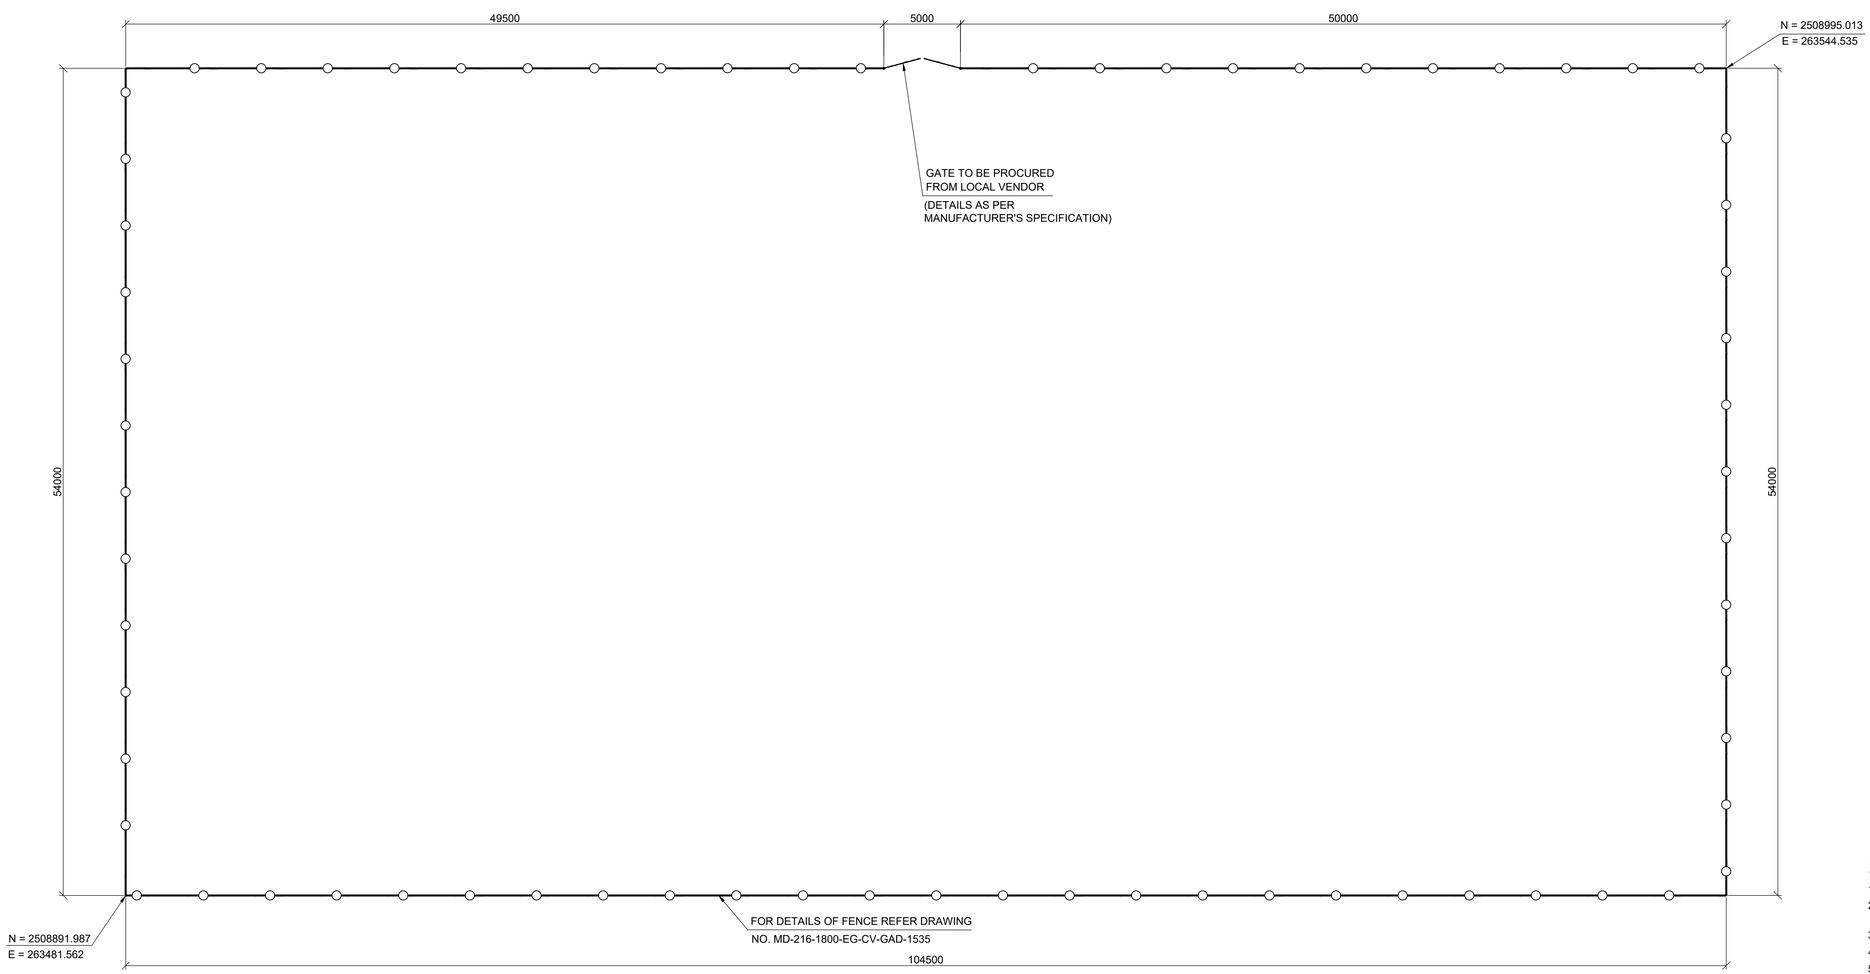

POTABLE WATER TREATMENT PLANT DEMARCATION FENCE

SCALE 1:200

NOTES :-

1. ALL DIMENSION ARE IN MILLIMETRE UNLESS OTHERWISE NOTED.
2. ALL FENCE POST & BRACES ARE COMPLYING ASTM A-53 SCH. 40 GALVANIZED + PVC COATED AS PER ASTM F1043
3. WIRE FOR CHAIN LINK IS PVC EXTRUDED
4. TENSION WIRE , STIRRUP WIRE & TIE WIRE ARE PVC EXTRUDED
5. ALL FENCE FITTING HOT DIPPED GALVANIZED AS PER ASTM F626 + PVC COATED AS PER ASTM F1043
6. CONCRETE SHALL BE PLAIN CEMENT CONCRETE (P.C.C.) OF GRADE 28 MPA (COMPRESSIVE STRENGTH AT 28 DAYS)
7. FENCE SHALL CONFORM TO PROVISION OF ASTM F 567-11a.
8. FENCE SHALL BE INSTALLED ON EXISTING NATURAL GROUND LEVELS (N.G.L.) AS AVAILABLE AT SITE.

DOCUMENT NUMBER	REFERENCE DOCUMENTS	REV	DATE	REVISION DESCRIPTION	DRN	CHK	ENG	APP	EMP
		D01	17/02/2023	AS-BUILT	AMJ	SJM	BJB	AG	
		C01	29/10/2021	ISSUED FOR CONSTRUCTION & REVISED AS PER EMPLOYER	SYA	SJM	BJB	AG	
				COMMENTS DATED 03/07/2021					
MD-216-1800-EG-CV-GAD-1535	SECURITY SYSTEM-MINING BOUNDARY OVERALL PERIMETER FENCE	A01	03/06/2021	ISSUED FOR APPROVAL	SYA	SJM	BJB	AG	

RESERVED FOR VENDOR LOGO AND DRAWING NUMBER

LARSEN & TOUBRO

This drawing is the property of *LARSEN & TOUBRO* and must not be passed on to any person or body not authorized by us to receive it nor be copied or otherwise made use either in full or in part by such person or body without our prior permission in writing.

Outotec

The content of these documents are the sole property of Outotec Oyj. Any rights not expressly granted herein are reserved. Reproduction, transfer or distribution of part or all of the contents in any form without prior written permission of Outotec is prohibited.

MA'ADEN معادن
Saudi Arabian Mining Company شركة المعادن العربية السعودية

This document and the information contained herein is Ma'aden proprietary know-how. This document or any part thereof should not be reproduced, stored in a retrieval system or transmitted by any means, electronic or otherwise, or divulged without prior written permission of Ma'aden.

LARSEN & TOUBRO DRAWING NUMBER			REVISION
019045_080_C_G_24693_001			2
OUTOTEC DRAWING NUMBER		DOCUMENT ID	REVISION
900707 __GAU01 __AG32__MTL01 __53106		OU100726160	2

DRAWN	SYA	01/06/2021
CHECKED	SJM	02/06/2021
ENGINEER	BJB	01/06/2021
APPROVED	AG	03/06/2021
EMPLOYER		
SCALE	1:200	A1

MANSOURAH - MASSARAH GOLD PROJECT
GENERAL ARRANGEMENT DRAWING
POTABLE WATER TREATMENT PLANT
DEMARCATION FENCE LAYOUT

DRAWING NUMBER	REV
MD-216-49WF-EG-CV-GAD-1019	D01