

DRAWING NUMBER: MD-216-49PS-EG-CV-DED-1002 | REV: D01

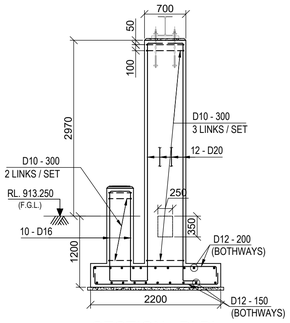


SECTION : D'-D'

SCALE 1:50

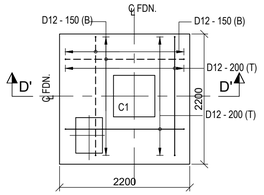

RC. DET. OF FOUNDATION
MKD. F4

SCALE 1:50

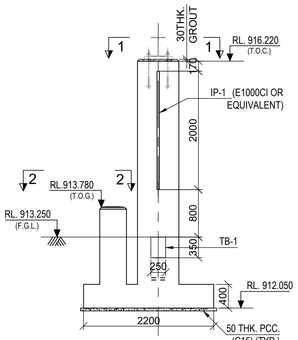


SECTION : A-A


SCALE 1:50

DET. OF FOUNDATION
MKD. F4

SCALE 1:50

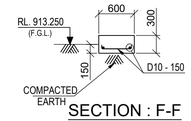


SECTION : F-F

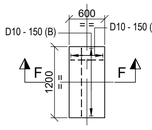


DET. OF FOUNDATION
MKD. F6

SCALE 1:50

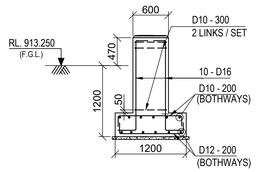


SECTION : E'-E'

SCALE 1:50

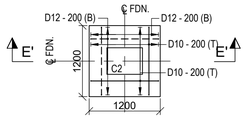


RC. DET. OF FOUNDATION
MKD. F5

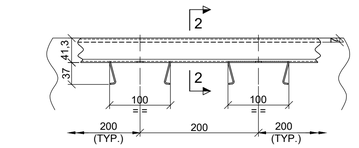


TYP. DET. OF INSERT MKD. IP-1 CHANNEL
TYPE E1000CI OR EQUIVALENT

SCALE - 1:5

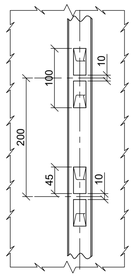


SECTION : 3-3

SCALE - 1:5

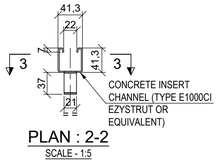

PLAN : 2-2

SCALE - 1:5

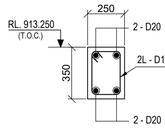

RC. DET. OF TB-1


SCALE 1:20

RC. DET. OF TB-2

SCALE 1:20


SECTION : Z-Z

SCALE 1:50

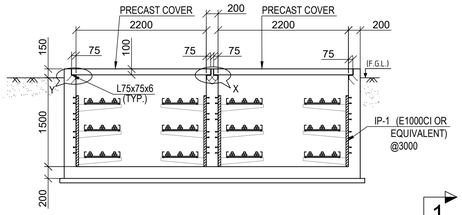


SECTION : Z-Z

SCALE 1:50

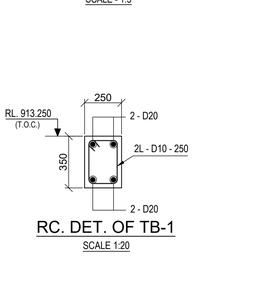


RC. DET. OF COLUMN
MKD. C1

SCALE 1:20

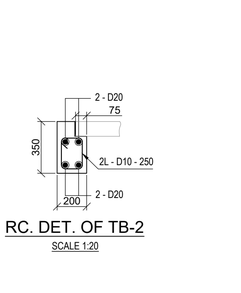


RC. DET. OF COLUMN
MKD. C2

SCALE 1:20

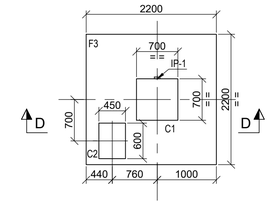


DET. OF FOUNDATION
MKD. F4

SCALE 1:50

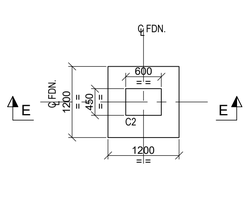

DET. OF FOUNDATION
MKD. F5


SCALE 1:50

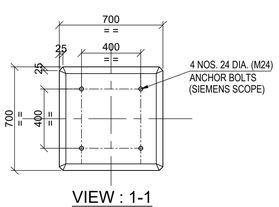

VIEW : 1-1

(DETAIL OF COL. MKD. C1)


SCALE 1:20

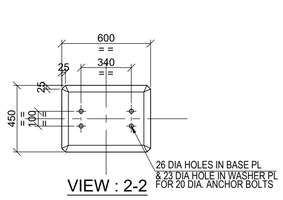

VIEW : 2-2


(DETAIL OF COL. MKD. C2)

SCALE 1:20

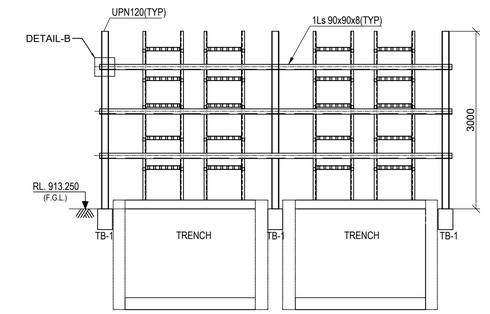


SECTION : F-F

SCALE 1:50

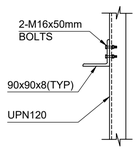


SECTION 1-1

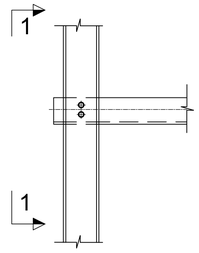

DETAIL-B


(TYPICAL L90x90x8 CONNECTION WITH UPN120)

SCALE 1:10

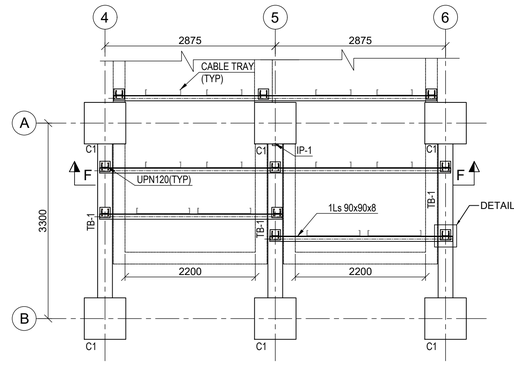

DET. OF VERTICAL TRAY SUPPORT
PLAN


SCALE 1:50

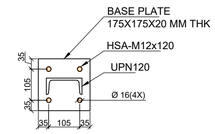

DETAIL-A


(TYPICAL UPN120 BASE CONNECTION)

SCALE 1:10

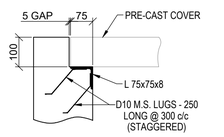

DETAIL - Y

(SCALE 1:10)

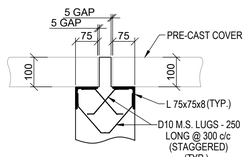

DETAIL - X

(SCALE 1:10)

LEGENDS :-

R.L. - REDUCED LEVEL
℄ - CENTRE LINE
T.O.C. - TOP OF CONCRETE
T.O.G. - TOP OF GROUT
TYP. - TYPICAL
F.G.L. - FINISHED GROUND LEVEL
F.F.L. - FINISHED FLOOR LEVEL
B.O.F. - BOTTOM OF FOUNDATION
MKD. - MARKED
THK. - THICK
BOTTOM REINFORCEMENT (B) - – – – – –
TOP REINFORCEMENT (T) - ————
R.C. - REINFORCED CONCRETE
P.C.C - PLAIN CEMENT CONCRETE
FDN. - FOUNDATION
DET. - DETAIL
COL. - COLUMN
DIA. - DIAMETER
IDT- INVERTER DUTY TRANSFORMER
PL- PLATE
C/C- CENTRE TO CENTRE

NOTES:-

1. ALL DIMENSIONS ARE IN MILLIMETRES AND LEVELS AND CO-ORDINATES ARE IN METRES UNLESS OTHERWISE STATED.
2. GRADE OF CONCRETE SHALL BE C35 (35MPa) FOR FOUNDATION & C15 (15MPa) FOR BLINDING CONCRETE.
3. GRADE OF REINFORCEMENT SHALL BE DEFORMED BAR 420 MPa (GRADE 60) - ASTM A615/A615M.
4. NET SAFE BEARING CAPACITY OF SOIL AT BOTTOM OF FOUNDATION CONSIDERED AS 200KN/ SQ. M
5. CLEAR COVER TO REINFORCEMENT SHALL BE FOUNDATIONS = 50 MM., COLUMNS = 50 MM., WALL = 25 MM.
6. FOR STANDARD REINFORCEMENT DETAIL & GENERAL NOTES FOR CIVIL WORKS REFER DRAWING NO. MD-216-1000-EG-CV-DED-1005 & 1001.

DOCUMENT NUMBER	REFERENCE DOCUMENTS	REV	DATE	REVISION DESCRIPTION	DRN	CHK	ENG	APP	EMP
		D01	09/03/2023	AS-BUILT	PT&D	AVG	GSK	SJM	
		C01	05/05/2021	ISSUED FOR CONSTRUCTION	PT&D	AVG	GSK	SJM	
		A02	09/04/2021	REVISED AS PER EMPLOYER COMMENTS DATED 23/03/2021	PT&D	AVG	GSK	SJM	
MD-216-49PS-EG-ST-GAD-2416	DETAILS OF STAIR & PLATFORM	A01	27/02/2021	ISSUED FOR APPROVAL	PT&D	AVG	GSK	SJM	

RESERVED FOR VENDOR LOGO AND DRAWING NUMBER

LARSEN & TOUBRO

This drawing is the property of LARSEN & TOUBRO and must not be passed on to any person or body not authorized by us to receive it nor be copied or otherwise made use either in full or in part by such person or body without our prior permission in writing.

Outotec

The content of these documents are the sole property of Outotec Oy). Any rights not expressly granted herein are reserved. Reproduction, transfer or distribution of part or all of the contents in any form without prior written permission of Outotec is prohibited.

MA'ADEN معادن
Saudi Arabian Mining Company شركة المعادن العربية السعودية

This document and the information contained herein is Ma'aden proprietary know-how. This document or any part thereof should not be reproduced, stored in a retrieval system or transmitted by any means, electronic or otherwise, or divulged without prior written permission of Ma'aden.

LARSEN & TOUBRO DRAWING NUMBER	019045_008_C_D_24642_002	REVISION 3
OUTOTEC DRAWING NUMBER	900707 __GAU01 __WG02__CTB05 __45002	DOCUMENT ID OU100717184 / REVISION 3

DRAWN	PT&D	23/02/2021
CHECKED	AVG	25/02/2021
ENGINEER	GSK	23/02/2021
APPROVED	SJM	27/02/2021
EMPLOYER		
SCALE	1:40	A1

MANSOURAH - MASSARAH GOLD PROJECT
GENERAL ARRANGEMENT DRAWING
POWER GENERATION : SOLAR PLANT
DETAIL OF FOUNDATION & TRENCH FOR IDT STATION

DRAWING NUMBER: MD-216-49PS-EG-CV-DED-1002 | REV: D01