


REV	DRAWING NUMBER
D01	MD- 216- 49PS- EG- CV- GAD- 1604

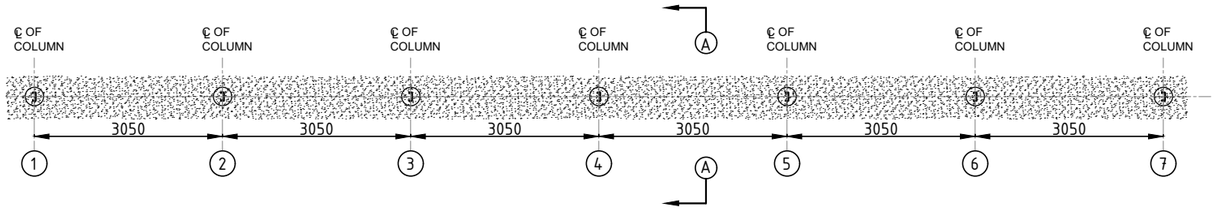

TYPICAL PLAN OF CONCRETE PILE

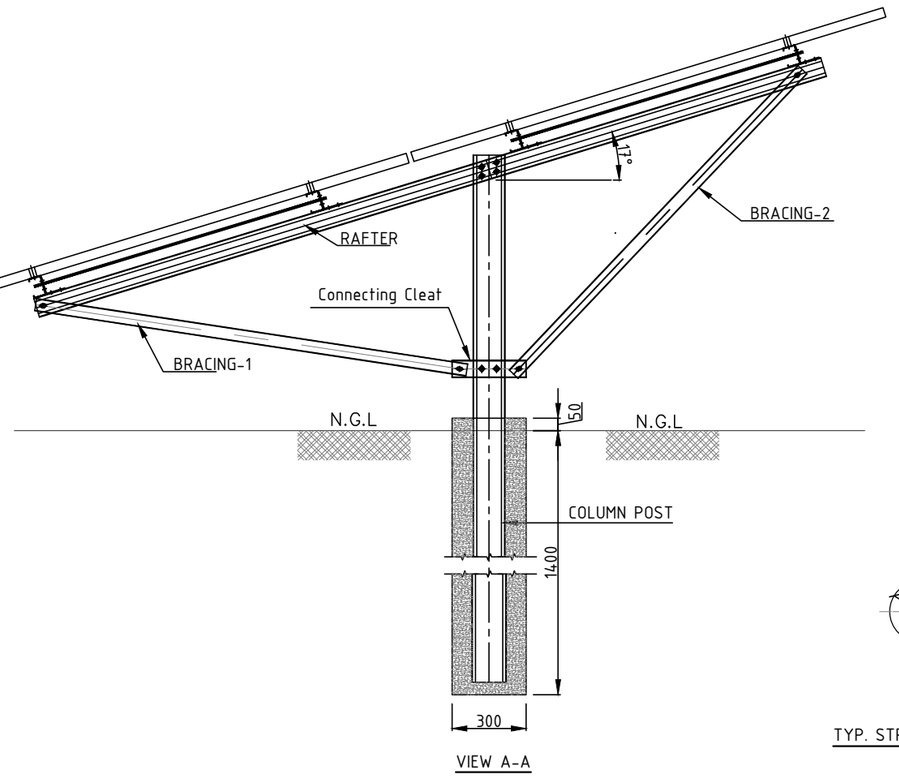

VIEW A-A

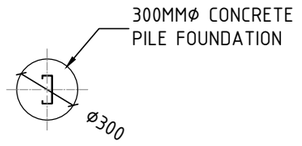

TYP. STRUCTURE FOUNDATION PLAN

MATERIALS:-

1. CONCRETE -C25 (CUBE STRENGTH 25MPA AT 28 DAYS)
2. COLD FORM STEEL LEG -S355 ACCORDING TO EN1993-1-3.

LEGENDS:-

N.G.L.	- NATURAL GROUND LEVEL
TYP.	- TYPICAL
NTS.	- NOT TO SCALE
MMS.	- MODULE MOUNTING STRUCTURE
℄	- CENTRE LINE
ø	- DIAMETER

NOTES:

1. ALL DIMENSIONS ARE IN MILLIMETRES, LEVEL AND CO-ORDINATES ARE IN METRE.
2. IN CASE OF ANY DISCREPANCY IN THE DIMENSION, WRITTEN DIMENSION SHALL BE FOLLOWED
3. ANY DISCREPANCY IN THE DRAWING SHALL BE BROUGHT TO THE NOTICE OF L&T DESIGN TEAM.
4. NECESSARY ARRANGEMENTS TO ENSURE PROPER VERTICAL ALIGNMENT/CLEAR COVER AT THE BOTTOM OF COLUMN POST SHALL BE DONE AT SITE.
5. FOUNDATION SHALL BE BORED CAST IN SITU WITH POST EMBEDDED IN CONCRETE.
6. NGL AS SHOWN IN THIS DRAWING REFERS TO NATURAL GROUND LEVEL AT SITE ANY UNDULATION BETWEEN ADJACENT COLUMN POST TO BE ADJUSTED IN COLUMN HEIGHTS ABOVE NGL BY PV TABLE ERECTION MANUAL.
7. REFER MD-216-49PS-EG-CV-GAD-1603 FOR MODULE MOUNTING STRUCTURE FOUNDATION LAYOUT.
9. FINAL PILE LOCATIONS SHALL BE DECIDED IN CONSULTATION WITH ENGINEER-IN-CHARGE AT SITE.
10. WHILE INSTALLING THE PILE BORE, SOIL PROFILE SHALL BE CHECKED WITH RESPECT TO SOIL PROFILE OBTAINED FROM GEO-TECHNICAL REPORT. IN CASE OF ANY MAJOR DIFFERENCE BETWEEN THE TWO, THE SAME SHALL BE REPORTED TO L&T DESIGN TEAM.
11. SOIL CHARACTERISTICS : SAND WITH SILT AND GRAVEL / GRAVEL WITH SILT AND SAND IS ASSUMED

REV	DATE	REVISION DESCRIPTION	DRN	CHK	ENG	APP	EMP
D01	09/03/2020	AS-BUILT	RVJ	AVG	GSK	SJM	
C01	03/10/2020	ISSUED FOR CONSTRUCTION	RVJ	AVG	GSK	SJM	
A01	02/09/2020	ISSUED FOR REFERENCE	RVJ	AVG	GSK	SJM	

RESERVED FOR VENDOR LOGO AND DRAWING NUMBER

Outotec
The content of these documents are the sole property of Outotec Oyj. Any rights not expressly granted herein are reserved. Reproduction, transfer or distribution of part or all of the contents in any form without prior written permission of Outotec is prohibited.

LARSEN & TOUBRO
This drawing is the property of LARSEN & TOUBRO and must not be passed on to any person or body not authorized by us to receive it nor be copied or otherwise made use either in full or in part by such person or body without our prior permission in writing.

MA'ADEN معادن
Saudi Arabian Mining Company شركة التعدين العربية السعودية
This document and the information contained herein is Ma'aden proprietary know-how. This document or any part thereof should not be reproduced, stored in a retrieval system or transmitted by any means, electronic or otherwise, or divulged without prior written permission of Ma'aden.

LARSEN & TOUBRO DRAWING NUMBER	O19045_008_C_G_24299_002	REV 2
OUTOTEC DRAWING NUMBER	900707 _ GAU01 _WG02_MTL01 _ 45004	DOCUMENT ID OU100688097 REV 2

DRAWN	RVJ	23/08/2020
CHECKED	AVG	24/08/2020
ENGINEER	GSK	23/08/2020
APPROVED	SJM	02/09/2020
EMPLOYER		
SCALE	NTS	A3

MANSOURAH - MASSARAH GOLD PROJECT
GENERAL ARRANGEMENT
POWER GENERATION : SOLAR PLANT
MMS FOUNDATION CROSS SECTION AND DETAILS

DRAWING NUMBER MD - 216-49PS- EG- CV- GAD- 1604 REV D01