


DRAWING NUMBER MD-216-49PS-EG-CV-GAD-1605 REV D01

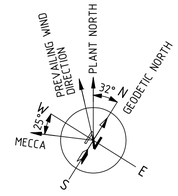

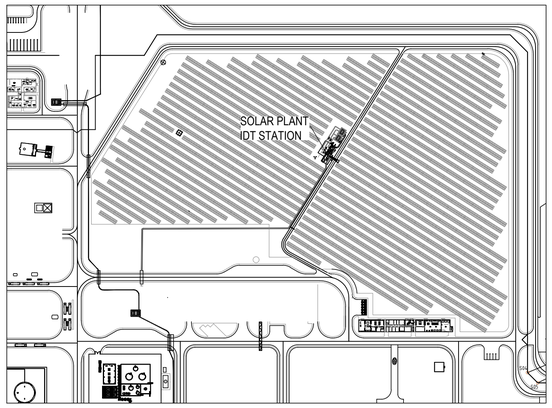

KEY PLAN

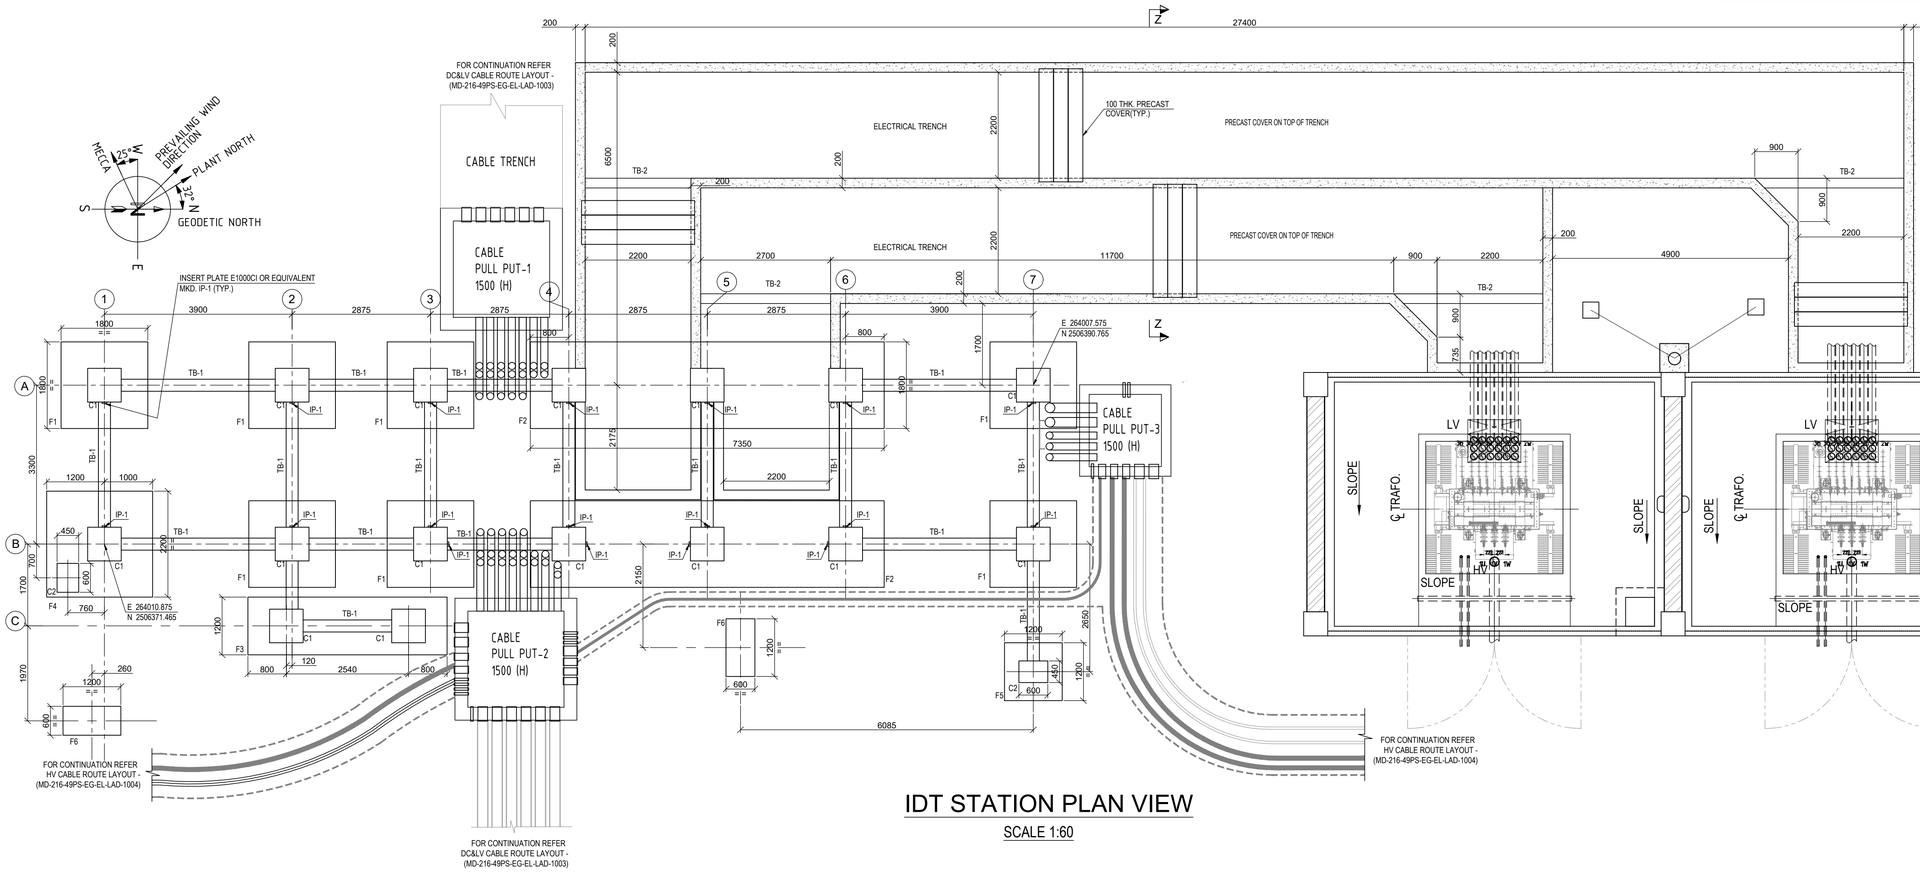

IDT STATION PLAN VIEW

SCALE 1:60

LEGEND :-

R.L. - REDUCED LEVEL
℄ - CENTRE LINE
T.O.C. - TOP OF CONCRETE
TYP. - TYPICAL
F.G.L. - FINISHED GROUND LEVEL
F.F.L. - FINISHED FLOOR LEVEL
B.O.F. - BOTTOM OF FOUNDATION
MKD. - MARKED
P.C.C - PLAIN CEMENT CONCRETE
N.T.S. - NOT TO SCALE
EXP. JT. - EXPANSION JOINT
DET. - DETAIL
BOTTOM REINFORCEMENT (B) -
TOP REINFORCEMENT (T) -
SQ. - SQUARE
R.C. - REINFORCED CONCRETE
FDN. - FOUNDATION
THK. - THICK
GA-GENERAL ARRANGEMENT
REF.- REFER
DWG.-DRAWING
DIA. - DIAMETER
R.C.C. - REINFORCEMENT CEMENT CONCRETE
IDT- INVERTER DUTY TRANSFORMER
TRAFO- TRANSFORMER

NOTES:-

1. ALL DIMENSIONS ARE IN MILLIMETRES AND LEVELS AND CO-ORDINATES ARE IN METRES UNLESS OTHERWISE STATED.
2. NET SAFE BEARING CAPACITY OF SOIL AT BOTTOM OF FOUNDATION CONSIDER 200KN/ SQ. M.
3. GRADE OF CONCRETE SHALL BE C35 (35MPa) FOR FOUNDATION & C15 (15MPa) FOR BLINDING CONCRETE.
4. GRADE OF REINFORCEMENT SHALL BE DEFORMED BAR 420 MPa (GRADE 60) - ASTM A615/A615M.
5. IF ANY PART OF FOUNDATION COMES ON BACKFILL ZONE OF ADJACENT FOUNDATION OR ANY LOOSE SOIL ARE ENCOUNTERED BELOW FOUNDATION LEVEL THE SAME SHALL BE REMOVED AND FILLED WITH PCC (C15).
6. CLEAR COVER TO REINFORCEMENT SHALL BE a. FOUNDATIONS = 50 MM., b. COLUMNS = 50 MM., c. GRADE SLAB = 25 MM.
7. FOR STANDARD REINFORCEMENT DETAIL & GENERAL NOTES FOR CIVIL WORKS REFER DRAWING NO. MD-216-1000-EG-CV-DED-1005 & 1001.

SHEET-1 OF 2

DOCUMENT NUMBER	REFERENCE DOCUMENTS	REV	DATE	REVISION DESCRIPTION	DRN	CHK	ENG	APP	EMP
		D01	09/03/2023	AS-BUILT	PT&D	AVG	GSK	SJM	
		C02	25/05/2021	ISSUED FOR CONSTRUCTION	PT&D	AVG	GSK	SJM	
		C01	05/05/2021	ISSUED FOR CONSTRUCTION	PT&D	AVG	GSK	SJM	
		A02	09/04/2021	REVISED AS PER EMPLOYER COMMENTS DATED 23/03/2021	PT&D	AVG	GSK	SJM	
MD-216-49PS-EG-ST-GAD-2416	DETAILS OF STAIR & PLATFORM	A01	27/02/2021	ISSUED FOR APPROVAL	PT&D	AVG	GSK	SJM	

RESERVED FOR VENDOR LOGO AND DRAWING NUMBER

LARSEN & TOUBRO

This drawing is the property of LARSEN & TOUBRO and must not be passed on to any person or body not authorized by us to receive it nor be copied or otherwise made use either in full or in part by such person or body without our prior permission in writing.

Outotec

The content of these documents are the sole property of Outotec Oyj. Any rights not expressly granted herein are reserved. Reproduction, transfer or distribution of part or all of the contents in any form without prior written permission of Outotec is prohibited.

MA'ADEN معادن
Saudi Arabian Mining Company شركة معادن العربية السعودية

This document and the information contained herein is Ma'aden proprietary know-how. This document or any part thereof should not be reproduced, stored in a retrieval system or transmitted by any means, electronic or otherwise, or divulged without prior written permission of Ma'aden.


LARSEN & TOUBRO DRAWING NUMBER: 019045_008_C_G_24545_001 — REVISION: 4
OUTOTEC DRAWING NUMBER: 900707__GAU01__WG02__MTL01__45017 — DOCUMENT ID: 0U100709101 — REVISION: 4

DRAWN	PT&D	23/02/2021
CHECKED	AVG	25/02/2021
ENGINEER	GSK	23/02/2021
APPROVED	SJM	27/02/2021
EMPLOYER		
SCALE	1:60	A1

MANSOURAH - MASSARAH GOLD PROJECT
GENERAL ARRANGEMENT DRAWING
POWER GENERATION : SOLAR PLANT
LAYOUT OF FOUNDATION FOR IDT STATION


DRAWING NUMBER: MD-216-49PS-EG-CV-GAD-1605 — REV: D01

DRAWING NUMBER: MD-216-49PS-EG-CV-GAD-1605
REV: D01

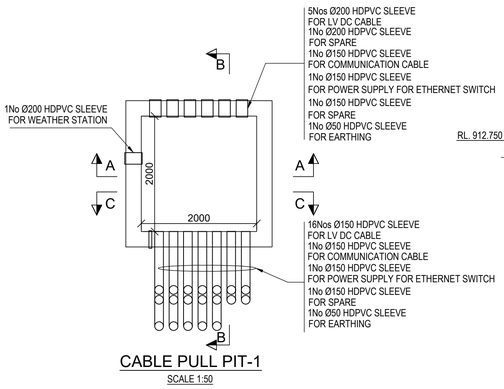


CABLE PULL PIT-1

SCALE 1:50

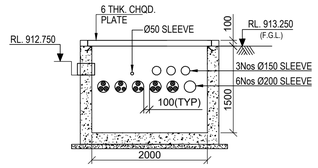


SECTION : A-A

SCALE 1:50

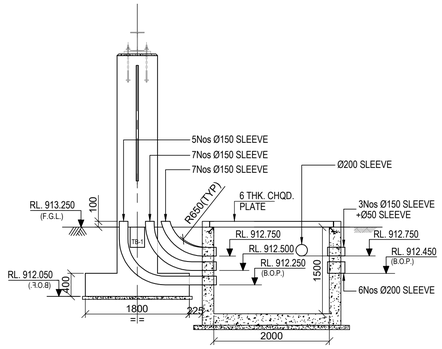


SECTION : B-B

SCALE 1:50

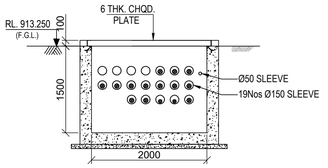


SECTION : C-C

SCALE 1:50

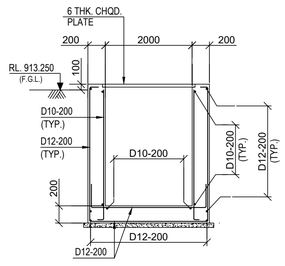


SECTION : X-X

SCALE 1:50

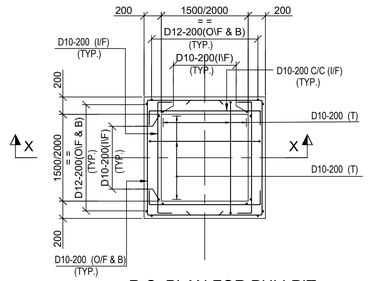


R.C. PLAN FOR PULLPIT

SCALE 1:50

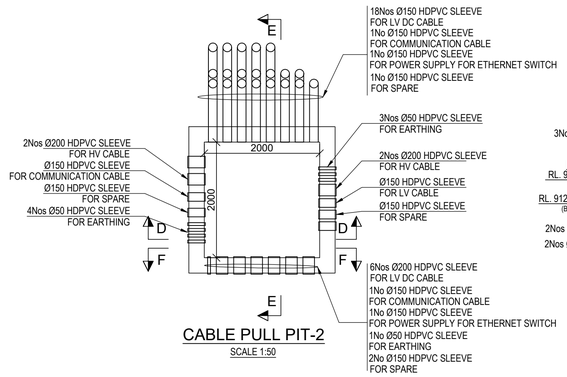


CABLE PULL PIT-2

SCALE 1:50

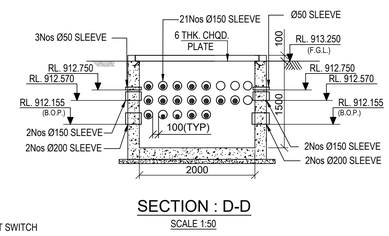


SECTION : D-D

SCALE 1:50

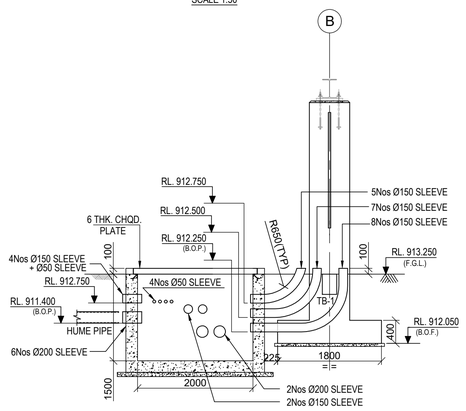


SECTION : E-E

SCALE 1:50

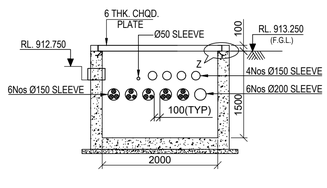


SECTION : F-F

SCALE 1:50

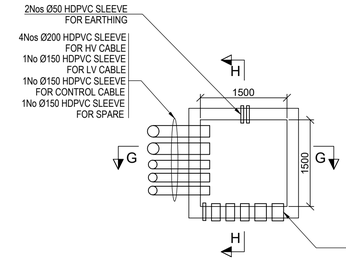


CABLE PULL PIT-3

SCALE 1:50

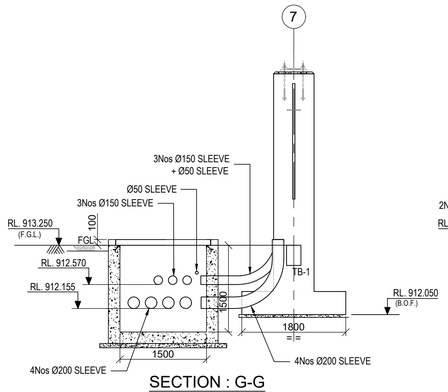


SECTION : G-G

SCALE 1:50

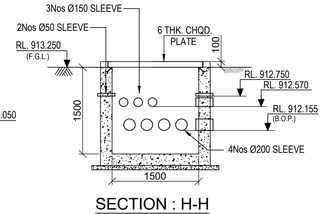

SECTION : H-H

SCALE 1:50

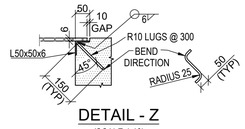

DETAIL - Z

(SCALE 1:10)

LEGENDS :-

R.L. - REDUCED LEVEL
℄ - CENTRE LINE
T.O.C. - TOP OF CONCRETE
T.O.G. - TOP OF GROUT
TYP. - TYPICAL
F.G.L. - FINISHED GROUND LEVEL
F.F.L. - FINISHED FLOOR LEVEL
B.O.F. - BOTTOM OF FOUNDATION
MKD. - MARKED
THK. - THICK
DIA. - DIAMETER
IDT- INVERTER DUTY TRANSFORMER

NOTES:-

1. ALL DIMENSIONS ARE IN MILLIMETRES AND LEVELS AND CO-ORDINATES ARE IN METRES UNLESS OTHERWISE STATED.
2. GRADE OF CONCRETE SHALL BE C35 (35MPa) FOR FOUNDATION & C15 (15MPa) FOR BLINDING CONCRETE.
3. GRADE OF REINFORCEMENT SHALL BE DEFORMED BAR 420 MPa (GRADE 60) - ASTM A615/A615M.
4. NET SAFE BEARING CAPACITY OF SOIL AT BOTTOM OF FOUNDATION CONSIDERED AS 200KN/ SQ. M
5. CLEAR COVER TO REINFORCEMENT SHALL BE FOUNDATIONS = 50 MM., COLUMNS = 50 MM., WALL = 25 MM.
6. FOR STANDARD REINFORCEMENT DETAIL & GENERAL NOTES FOR CIVIL WORKS REFER DRAWING NO. MD-216-1000-EG-CV-DED-1005 & 1001.

SHEET-2 OF 2

DOCUMENT NUMBER	REFERENCE DOCUMENTS	REV	DATE	REVISION DESCRIPTION	DRN	CHK	ENG	APP	EMP
		D01	09/03/2023	AS-BUILT	PT&D	AVG	GSK	SJM	
		C02	25/05/2021	ISSUED FOR CONSTRUCTION	PT&D	AVG	GSK	SJM	
		C01	05/05/2021	ISSUED FOR CONSTRUCTION	PT&D	AVG	GSK	SJM	
		A02	09/04/2021	REVISED AS PER EMPLOYER COMMENTS DATED 23/03/2021	PT&D	AVG	GSK	SJM	
MD-216-49PS-EG-ST-GAD-2416	DETAILS OF STAIR & PLATFORM	A01	28/02/2021	ISSUED FOR APPROVAL	PT&D	AVG	GSK	SJM	

RESERVED FOR VENDOR LOGO AND DRAWING NUMBER

LARSEN & TOUBRO

This drawing is the property of LARSEN & TOUBRO and must not be passed on to any person or body not authorized by us to receive it nor be copied or otherwise made use either in full or in part by such person or body without our prior permission in writing.

Outotec

The content of these documents are the sole property of Outotec Oyj. Any rights not expressly granted herein are reserved. Reproduction, transfer or distribution of part or all of the contents in any form without prior written permission of Outotec is prohibited.

MA'ADEN معادن
Saudi Arabian Mining Company شركة معادن العربية السعودية

This document and the information contained herein is Ma'aden proprietary know-how. This document or any part thereof should not be reproduced, stored in a retrieval system or transmitted by any means, electronic or otherwise, or divulged without prior written permission of Ma'aden.

LARSEN & TOUBRO DRAWING NUMBER: 019045_008_C_G_24545_001 — REVISION: 4
OUTOTEC DRAWING NUMBER: 900707__GAU01__WG02__MTL01__45017 — DOCUMENT ID: 0U100709101 — REVISION: 4

DRAWN	PT&D	23/02/2021
CHECKED	AVG	25/02/2021
ENGINEER	GSK	23/02/2021
APPROVED	SJM	28/02/2021
EMPLOYER		
SCALE	1:60	A1

MANSOURAH - MASSARAH GOLD PROJECT
GENERAL ARRANGEMENT DRAWING
POWER GENERATION : SOLAR PLANT
LAYOUT OF FOUNDATION FOR IDT STATION

DRAWING NUMBER: MD-216-49PS-EG-CV-GAD-1605 — REV: D01