


DRAWING NUMBER: MD-216-49PS-EG-CV-GAD-1606 | REV: D01

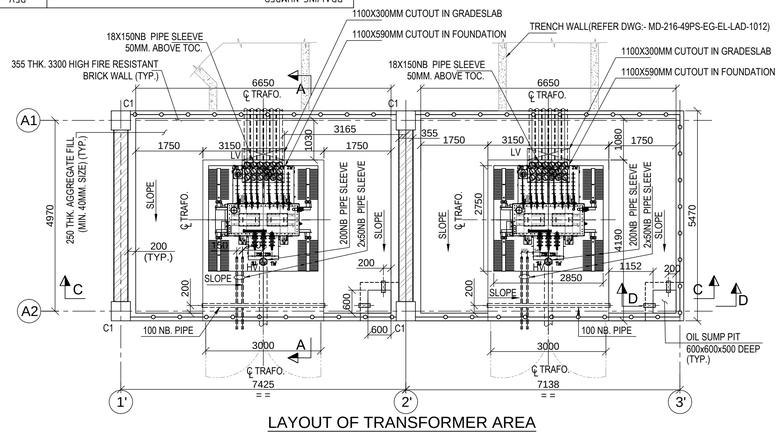


LAYOUT OF TRANSFORMER AREA
SCALE 1:75

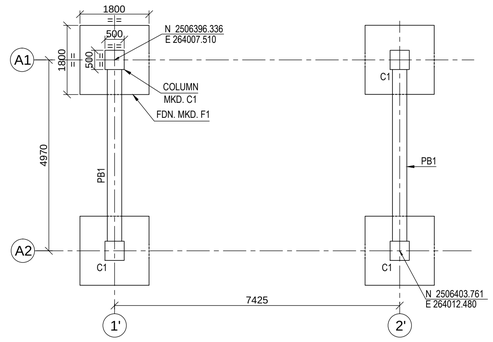


LAYOUT OF FOUNDATION
SCALE 1:75

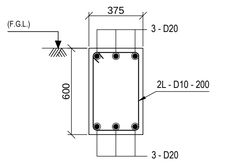


RC. DET. OF PB1
SCALE 1:20

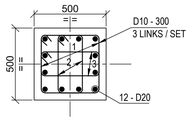


RC. DET. OF COLUMN MKD. C1
SCALE 1:20

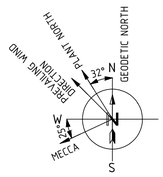


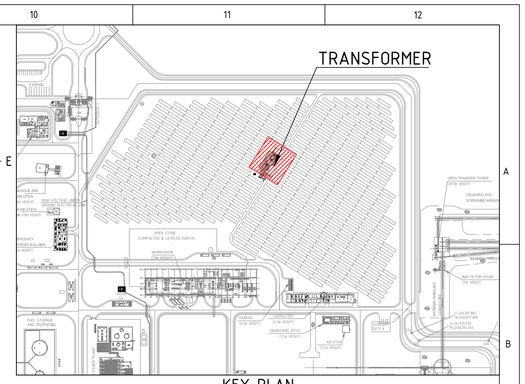

KEY PLAN

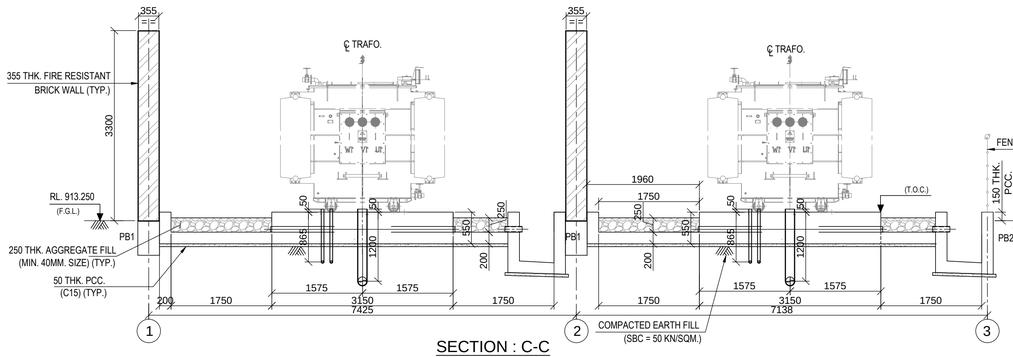

SECTION : C-C
SCALE 1:50

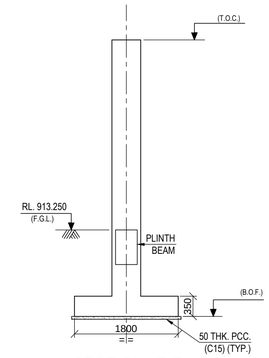


SECTION : B-B
SCALE 1:50




SECTION : A'-A'
SCALE 1:50


SECTION : A-A
SCALE 1:50

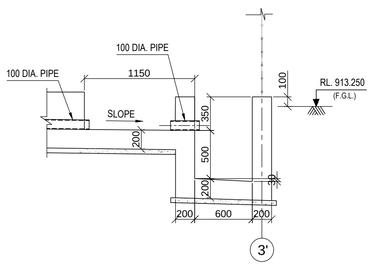


SECTION : D-D
SCALE 1:30

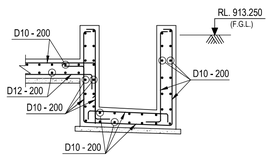


SECTION : D-D
(RC. DETAIL)
SCALE 1:30

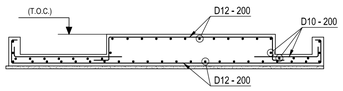

SECTION : A-A
(RC. DETAIL)
SCALE 1:50

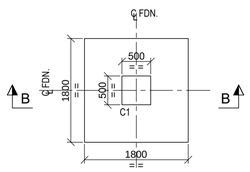

DET. OF FOUNDATION MKD. F1
SCALE 1:50

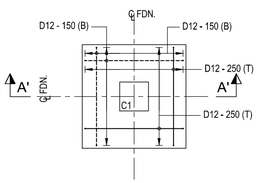

RC. DET. OF FOUNDATION MKD. F1
SCALE 1:50

LEGENDS :-

R.L. - REDUCED LEVEL
℄ - CENTRE LINE
T.O.C. - TOP OF CONCRETE
TYP. - TYPICAL
T.O.G. - TOP OF GROUT
B.O.F. - BOTTOM OF FOUNDATION
F.G.L. - FINISHED GROUND LEVEL.
F.F.L. - FINISHED FLOOR LEVEL
P.C.C - PLAIN CEMENT CONCRETE
DET. - DETAIL
FDN. - FOUNDATION
THK. - THICK
R.C. - REINFORCED CONCRETE
MKD. - MARKED
TRAFO. - TRANSFORMER
MIN. - MINIMUM
DIA. - DIAMETER
BOTTOM REINFORCEMENT (B) - ----------
TOP REINFORCEMENT (T) - ————

NOTES:-

1. ALL DIMENSIONS ARE IN MILLIMETRES AND LEVELS AND CO-ORDINATES ARE IN METRES UNLESS OTHERWISE STATED.
2. NET SAFE BEARING CAPACITY OF SOIL AT BOTTOM OF ISOLATED FOUNDATION IS CONSIDERED AS 250KN/ SQ. M.
3. GRADE OF CONCRETE SHALL BE C35 (35Mpa) FOR FOUNDATION, C30 (30Mpa) FOR GRADE SLAB & C15 (15Mpa) FOR BLINDING CONCRETE.
4. GRADE OF REINFORCEMENT SHALL BE DEFORMED BAR 420 MPa (GRADE 60) - ASTM A615/A615M.
5. CLEAR COVER TO REINFORCEMENT SHALL BE FOUNDATIONS = 50 MM., COLUMNS = 50 MM., BEAM = 25 MM.
6. FOR STANDARD REINFORCEMENT DETAIL & GENERAL NOTES FOR CIVIL WORKS REFER DRAWING NO. MD-216-1000-EG-CV-DED-1005 & 1001.

DOCUMENT NUMBER	REFERENCE DOCUMENTS	REV	DATE	REVISION DESCRIPTION	DRN	CHK	ENG	APP	EMP
		D01	09/03/2023	AS-BUILT	RVJ	AVG	GSK	SJM	
MD-216-49PS-EG-EL-LAD-1012	CABLE ROUTE LAYOUT-HV	C01	16/01/2021	ISSUED FOR CONSTRUCTION	RVJ	AVG	GSK	SJM	
MD-216-49PS-EG-EL-LAD-1002	LAYOUT SOLAR POWER PLANT OVERALL	A01	19/12/2020	ISSUED FOR APPROVAL	RVJ	AVG	GSK	SJM	

RESERVED FOR VENDOR LOGO AND DRAWING NUMBER

LARSEN & TOUBRO

This drawing is the property of LARSEN & TOUBRO and must not be passed on to any person or body not authorized by us to receive it nor be copied or otherwise made use either in full or in part by such person or body without our prior permission in writing.

Outotec

The content of these documents are the sole property of Outotec Oyj. Any rights not expressly granted herein are reserved. Reproduction, transfer or distribution of part or all of the contents in any form without prior written permission of Outotec is prohibited.

MA'ADEN معادن
Saudi Arabian Mining Company شركة معادن العربية السعودية

This document and the information contained herein is Ma'aden proprietary know-how. This document or any part thereof should not be reproduced, stored in a retrieval system or transmitted by any means, electronic or otherwise, or divulged without prior written permission of Ma'aden.

LARSEN & TOUBRO DRAWING NUMBER: 019045_008_C_G_24545_002 | REVISION: 2
OUTOTEC DRAWING NUMBER: 900707__GAU01__WG02__MTL01__45018 | DOCUMENT ID: OU100709102 | REVISION: 2

DRAWN	RVJ	13/12/2020	
CHECKED	AVG	18/12/2020	
ENGINEER	GSK	13/12/2020	
APPROVED	SJM	19/12/2020	
EMPLOYER			
SCALE	NTS		A1

MANSOURAH - MASSARAH GOLD PROJECT
GENERAL ARRANGEMENT DRAWING
POWER GENERATION : SOLAR PLANT
DETAIL OF TRANSFORMER AREA

DRAWING NUMBER: MD-216-49PS-EG-CV-GAD-1606 | REV: D01