DRAWING NUMBER: MD-216-49R0-EG-CV-GAD-1569
REV: D01

E=263000.000

E=263000.000
MATCH LINE

DRG. NO.
MD-216-49R0-EG-CV-GAD-1568-A01

N 2508973.086
E 262989.946

E=262918.125
N=2508951.049
T.O.R MATCH WITH
BOUNDARY ROAD

E=262903.121
N=2508235.412
T.O.R MATCH WITH
VILLAGE ROAD

N=2509000.000

N=2508500.000

N=2508260.000
MATCH LINE

DRG. NO.
MD-216-49R0-EG-CV-GAD-1567-A01

N 2508690.998
E 262525.7

E=262500.000

E=262500.000

R10


E=262450.420
N=2508342.848
T.O.R+922.00

E=262389.066
N=2508438.896
T.O.R MATCH WITH
PLANT ACCESS ROAD

GEODETIC NORTH
PLANT NORTH
35°
25°
MECCA
PREVAILING WIND DIRECTION

CUT AND FILL SLOPES

TERRAIN TYPE	DEPTH	CUT SLOPE (H : V)	FILL SLOPE (H : V)
ROLLING	0.00 - 1.00	3 : 1	4 : 1
	1.00 - 3.00	2 : 1	4 : 1
	3.00 - 5.00	2 : 1	3 : 1
	> 5.00	2 : 1	2 : 1

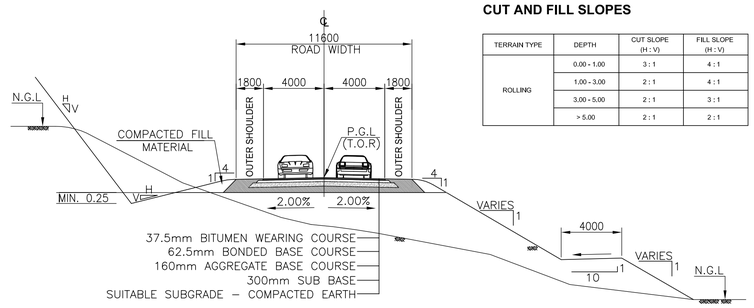

TYPICAL ROAD CROSS SECTION

NOTES:
1. ALL DIMENSIONS ARE IN MILLIMETRES.
2. CO-ORDINATES AND LEVELS ARE IN METRES
3. CO-ORDINATES ARE ON WORLD GRID (FLAT PLANT/WORLD)
4. WORLD MAPPING GRID BASED ON UTM (WGS 84) Q38N
5. TOP OF ROAD (T.O.R). LEVEL SHOWN THUS..... 219.3 / 221.7
6. INSIDE RADIUS OF CURVATURE OF ROAD SHOWN THUS.....10R, INDICATES RADIUS = 10M.
7. SYMBOL USED AS:- `S' = SLOPE AND `L' = LEVEL.

DOCUMENT NUMBER	REFERENCE DOCUMENTS	REV	DATE	REVISION DESCRIPTION	DRN	CHK	ENG	APP	EMP
		D01	08/09/2023	AS-BUILT	APEX	MLI	APEX	SJM	
		C02	28/04/2021	ISSUED FOR CONSTRUCTION & REVISED AS MKD. 02	APEX	MLI	APEX	SJM	
MD-216-49EA-EG-CV-GAD-1004	PEOCESS PLANT ROAD	C01	06/07/2020	ISSUED FOR CONSTRUCTION	APEX	MLI	APEX	SJM	
MD-216-1000-EG-GE-PPD-1002	PROCESS PLANT LAYOUT	A01	04/06/2020	ISSUED FOR REFERENCE	APEX	MLI	APEX	SJM	

RESERVER FOR VENDOR LOGO AND DRAWING NUMBER

LARSEN & TOUBRO

This drawing is the property of LARSEN & TOUBRO and must not be passed on to any person or body not authorized by us to receive it nor be copied or otherwise made use either in full or in part by such person or body without our prior permission in writing.

Outotec

The content of these documents are the sole property of Outotec Oyj. Any rights not expressly granted herein are reserved. Reproduction, transfer or distribution of part or all of the contents in any form without prior written permission of Outotec is prohibited.

MA'ADEN معادن
Saudi Arabian Mining Company شركة التعدين العربية السعودية

This document and the information contained herein is Ma'aden proprietary know-how. This document or any part thereof should not be reproduced, stored in a retrieval system or transmitted by any means, electronic or otherwise, or divulged without prior written permission of Ma'aden.

LARSEN & TOUBRO DRAWING NUMBER: 019045_910_C_G_24270_001 — REVISION: 3
OUTOTEC DRAWING NUMBER: 900707__GAU01__AN03__MTL01__00007 — DOCUMENT ID: OU100687822 — REVISION: 3

DRAWN	APEX	02/06/2020
CHECKED	MLI	03/06/2020
ENGINEER	APEX	02/06/2020
APPROVED	SJM	04/06/2020
EMPLOYER		
SCALE	1:1500	A1

MANSOURAH - MASSARAH GOLD PROJECT
GENERAL ARRANGEMENT
ACCESS ROAD TO HAUL ROAD
PLAN, SECTION & DETAILS (SHEET 4 OF 4)

DRAWING NUMBER: MD-216-49R0-EG-CV-GAD-1569 — REV: D01