


DRAWING NUMBER MD-216-49EE-EG-CV-GAD-1584 REV D01

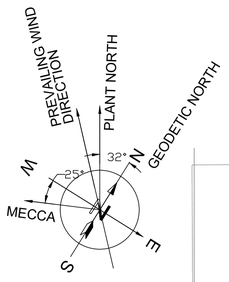

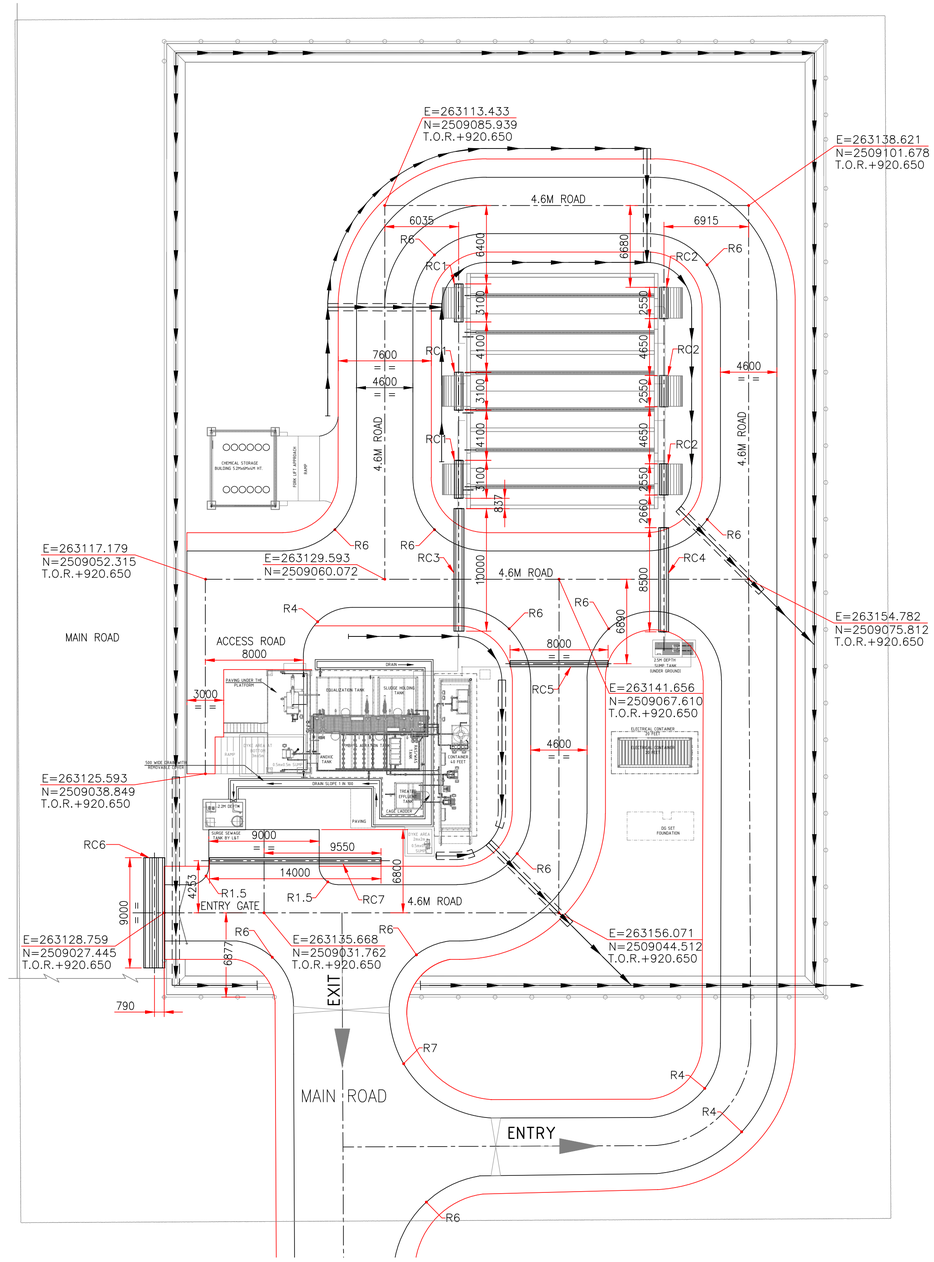


CUT AND FILL SLOPES

TERRAIN TYPE	DEPTH	CUT SLOPE (H : V)	FILL SLOPE (H : V)
ROLLING	0.00 - 1.00	3 : 1	4 : 1
	1.00 - 3.00	2 : 1	4 : 1
	3.00 - 5.00	2 : 1	3 : 1
	> 5.00	2 : 1	2 : 1

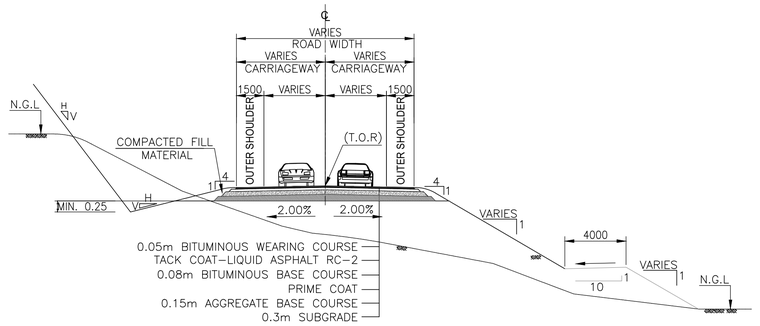


TYPICAL ROAD CROSS SECTION

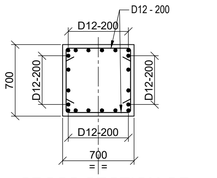


CROSS SECTION OF ENCASING MARKED RC1,RC2 RC3 & RC4

(SHOWING RC DETAIL)
(SCALE 1:30)

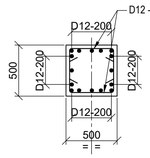


CROSS SECTION OF ENCASING MARKED RC5 & RC7

(SHOWING RC DETAIL)
(SCALE 1:30)

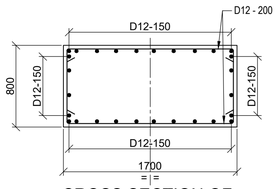


CROSS SECTION OF ENCASING MARKED RC6

(SHOWING RC DETAIL)
(SCALE 1:30)

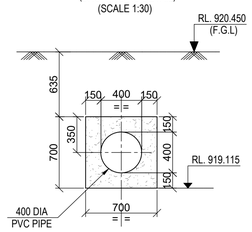


CROSS SECTION OF ENCASING MARKED RC1

(SCALE 1:30)

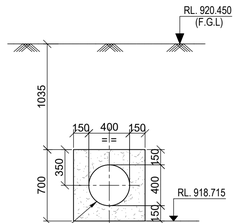


CROSS SECTION OF ENCASING MARKED RC2

(SCALE 1:30)

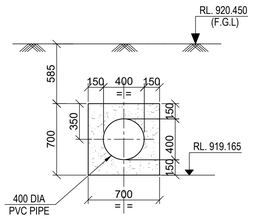


CROSS SECTION OF ENCASING MARKED RC3

(SCALE 1:30)

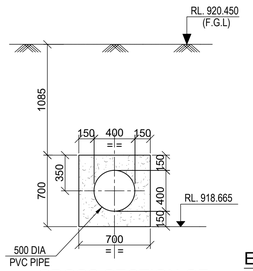


CROSS SECTION OF ENCASING MARKED RC4

(SCALE 1:30)

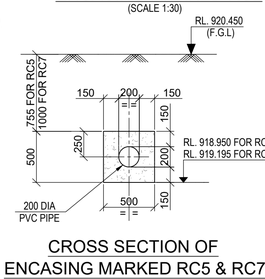


CROSS SECTION OF ENCASING MARKED RC5 & RC7

(SCALE 1:30)

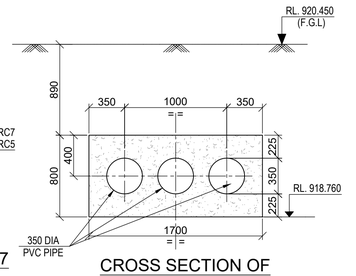

CROSS SECTION OF ENCASING MARKED RC6

(SCALE 1:30)

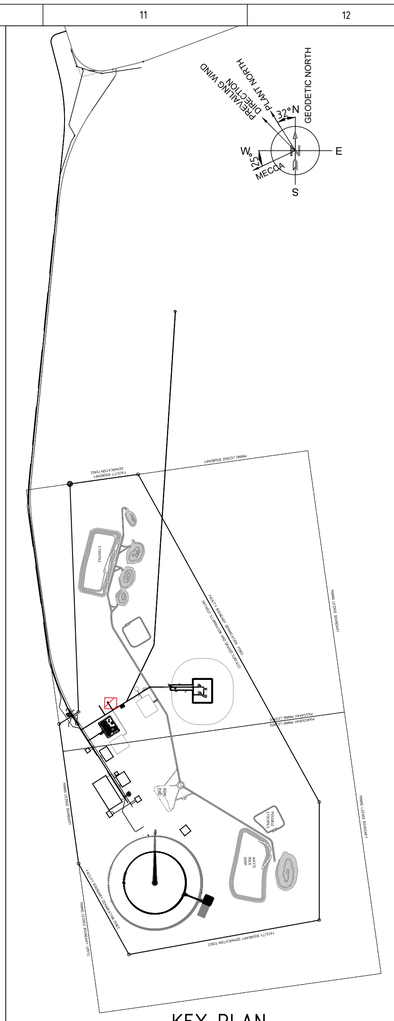

KEY PLAN

LEGEND:

	FENCE
	NEW ROAD (L&T SCOPE)
N.G.L.	NATURAL GROUND LEVEL
T.O.R.	TOP OF ROAD
H	HORIZONTAL
V	VERTICAL
EL	ELEVATION
CL	CENTRE LINE
Min	MINIMUM

NOTE:

1. ALL DIMENSIONS ARE IN MILLIMETRES UNLESS OTHERWISE SPECIFIED.
2. CO-ORDINATES AND LEVELS ARE IN METRES
3. CO-ORDINATES ARE ON WORLD GRID (FLAT PLANT/WORLD)
4. WORLD MAPPING GRID BASED ON UTM (WGS 84) Q38N
5. TOP OF ROAD (T.O.R) = EL(+)920.650M.
6. INSIDE RADIUS OF CURVATURE OF ROAD SHOWN THUS.....6R, INDICATES RADIUS = 6M.
7. FINISHED GROUND LEVEL (F.G.L) = EL(+)920.450M.

DOCUMENT NUMBER	REFERENCE DOCUMENTS	REV	DATE	REVISION DESCRIPTION	DRN	CHK	ENG	APP	EMP
		D01	16/02/2023	AS-BUILT & REVISED AS MARKED 10	SYA	BJB	SJM	AG	
MD-216-49EE-EG-CV-GAD-1585	LAYOUT & SECTIONS OF STORM WATER DRAIN	C02	21/01/2022	ISSUED FOR CONSTRUCTION & REVISED AS MARKED 09	SYA	BJB	SJM	AG	
MD-216-49R0-EG-CV-GAD-1568	ACCESS ROAD TO W.W.T. PLANT & GARBAGE COLLECTION AREA	C01	20/01/2021	ISSUED FOR CONSTRUCTION & REVISED AS MARKED 08	APEX	BJB	APEX	SJM	
MD-216-1000-EG-ME-PPD-1001	SITE MAP GENERAL OVERALL PROJECT LAYOUT	A01	05/11/2020	ISSUED FOR REVIEW	APEX	BJB	APEX	SJM	

RESERVER FOR VENDOR LOGO AND DRAWING NUMBER

LARSEN & TOUBRO DRAWING NUMBER: 019045_450_C_G_24280_001 — REVISION: 3

OUTOTEC DRAWING NUMBER: 900707__GAU01__AG90__MTL01__50034 — DOCUMENT ID: OU100706303 — REVISION: 3

LARSEN & TOUBRO

This drawing is the property of LARSEN & TOUBRO and must not be passed on to any person or body not authorized by us to receive it nor be copied or otherwise made use either in full or in part by such person or body without our prior permission in writing.

Outotec

The content of these documents are the sole property of Outotec Oyj. Any rights not expressly granted herein are reserved. Reproduction, transfer or distribution of part or all of the contents in any form without prior written permission of Outotec is prohibited.

MA'ADEN معادن
Saudi Arabian Mining Company شركة التعدين العربية السعودية

This document and the information contained herein is Ma'aden proprietary know-how. This document or any part thereof should not be reproduced, stored in a retrieval system or transmitted by any means, electronic or otherwise, or divulged without prior written permission of Ma'aden.

DRAWN	APEX	30/10/2020
CHECKED	BJB	02/11/2020
ENGINEER	APEX	30/10/2020
APPROVED	SJM	05/11/2020
EMPLOYER		
SCALE	1:250	A1

MANSOURAH - MASSARAH GOLD PROJECT
GENERAL ARRANGEMENT
SEWAGE TREATMENT PLANT
ROAD LAYOUT & SECTIONS

DRAWING NUMBER: MD-216-49EE-EG-CV-GAD-1584 — REV: D01